ADDENDUM NO. 1 UNION STREET IMPROVEMENTS CITY OF CONCORD, NORTH CAROLINA

This Addendum No. 1 is issued this 20Th day of August 2020 to all parties who hold a set of Bidding Documents for the project entitled "Union Street Improvements, Concord, North Carolina". This Addendum No. 1 shall become part of the Contract Documents and its receipt acknowledged on the Bidding Documents at the time of bidding.

The following changes shall be made:

1. **Pre-Bid Meeting Notes:**

Attached are meeting notes from the Pre-Bid meeting held on Tuesday, August 17, 2020, at 2:00 pm. The meeting notes and materials distributed (and included herein) shall become a part of the Bidding Documents.

2. <u>Attendance Sheet</u>: A copy of the Attendance Sheet for the Pre-Bid meeting is provided as an attachment to these meeting notes.

3. Revision to Contract Documents:

The following revisions are made to the contract documents:

Replace the following documents in their entirety.

Exhibit A Bid Form

Exhibit C Special Provisions

Appendix F – City of Concord Conditions

Construction Document Sheets – See attached Revised Plans

CE-104 – Add field located 3" roof drain not on survey

CE-106 – Add field located 4" roof drain not on survey

CD-104 – Added demolition of existing curb and gutter

C-102 – Add key tag for 6" concrete section at end of granite SW flume

C-103 – Add addition ornamental railing

C-104 – Extend and tag 30" curb and gutter; 6" concrete drive section for corners at intersection of Corban

C-107 – Add key tag to clarify 6" curb at back of HC ramps

C-201 – Key notes revised

C-202 - Key notes revised

- C-203 Key notes revised
- C-204 Add 3" roof drain, update key notes
- C-205 Key notes revised
- C-206 add 4" and 6" roof drain, update key notes
- C-207 Key notes revised
- C-501 Revised landscape edge and stand-up curb details
- C-503 Revised HC ramp side elevation
- C-504 Revised trail marker detail
- C-506 Revised monolithic wall detail
- E-103 Sheet number changed to A1_E-103. Manhole that was located on the right side of plaza has been moved to the next sheet.
- E-104 Sheet number changed to A1_E-104. Manhole from previous sheet has been added to this sheet above Barbrick Avenue. Additional duct bank of four (4) spare 4" conduits has been added to run down Barbrick Avenue.
- E-105 Sheet number changed to A1_E-105. Continuation of duct bank of four (4) spare 4" conduits from previous sheet. Two additional manholes added, one on Barbrick Avenue and the other on Market Street.

4. Clarifications/Questions:

a. Clarification of unclassified excavation.

Bid form has been revised to include undercut excavation.

b. Question on temporary trench cap – Is there a detail provided?

Temporary Trench cap will be addressed in Addendum 2.

c. Question on asphalt repair payment item for Utility Trench Cut?

Stormwater Utility Trench repair has been added as a line item. This will only apply to areas being cut that are not open demolition areas.

Waterline Utility Trench repair will be addressed in Addendum 2.

d. Question on payment item for liquid asphalt?

Bid form has been revised to include asphalt binder for plant mix. Contractor to use NCDOT August 1, 2021 for basis of pricing.

e. Question on payment item for temporary pavement markings?

Bid form has been revised to include a line items for temporary pavement markings.

f. Question on curb detail verses curb shown on landscape edging detail? Drawings have been revised.

See updated detail sheets included with addendum 1, the City curb has been revised.

g. Please consider adding an item (select material) to cover replacing unsuitable backfill material required for the storm and utility trenches. The quantity required is a guess, similarly to undercut, and providing an item will cover both the Contractor and the City.

Per NCDOT undercut excavation for trenches and roadway are paid as the same item so there will not be a separate line item for trenches. A undercut excavation item has been added to the bid form. A foundation conditioning and foundation conditioning fabric line item have been added as well.

h. Detail E/20 on Sheet E-502 does not provide any dimensions other than the depth of the grounding rod below grade. The detail states "Contractor to provide complete light pole base detail with all dimensions and requirements sealed by Structural Engineer". This seems like an unreasonable request of the Contractor as Structural Engineers are not willing to provide much information during the bid phase without significant compensation. They would also require all technical data for the light poles to design the bases. Please provide the light standard base dimensions, rebar, etc. so that we may price accordingly.

We do not consider this an unreasonable request. Prior experience with light pole installation should be used as a basis for bid estimation.

i. Can you provide the potential manufacturer(s) or basis of design of the Announcement Kiosk so that our electrical subcontractor can seek a quote and more information on installation?

Signs By Crannie 810-487-0000 www.signsbycrannie.com Manufacturer File Name: McGill-Streetscape-Map Kiosk

j. Item 159 and SP-135 descriptions do not match. Can you please consider itemizing the electrical demolition? Demo duct bank per LF, Handholes per Ea, etc. We and our electrical sub(s) are especially concerned about the underground demolition not being exactly what is shown on the plans.

Items 159 and SP-135 have been coordinated to match. Electrical demolition cannot be itemized and will remain as a lump sum item. Contractors should schedule a field visit with the city to gain a greater understanding of any unknowns concerning the existing electrical system.

k. For the Demo – Concrete Encased Duct bank, please provide more information (size, depth, etc.) so that we may price accordingly.

See attached photos for reference. Contractors should schedule a field visit with the city to gain a greater understanding of any unknowns concerning the existing electrical system.

I. Can you provide an excel spreadsheet of the bid form that we may use to prepare and submit our bid on?

To prevent any accidental errors or omissions on our end Excel spreadsheet will not be provided, contractors are responsible for their bid submittals.

This Addendum Number One is issued this day the 20th of August 2021.

CARRIE CRANWILL, PLA, EI



Shaping Communities Together

1240 19th St. Lane NW Hickory, North Carolina 28601 Firm License No. C-0459







PRE-BID MEETING MINUTES UNION STREET IMPROVEMENTS CONCORD, NORTH CAROLINA

TUESDAY, AUGUST 17, 2021, 2:00 PM

A pre-bid meeting for the project entitled "Union Street Improvements" was held on August 17,2021 at 2:00 pm at the Alfred M Brown Operations Center Ready Room.

<u>Attendance Sheet</u>: A copy of the Attendance Sheet for the Pre-Bid meeting is provided as an attachment to these meeting notes.

1. Project Location and Scope of Work

The **Union Street Improvements** project consists of streetscape improvements from the intersection of Union Street and Killarney Avenue to the intersection of Union Street and Foard Ave and along Barbrick Ave. Work includes but is not limited to removal of existing asphalt, concrete, curbing, water line and sewer line improvements, storm drainage, the installation of concrete sidewalk with brick bands and accents, concrete curbing, seat walls, pavers, fencing, site furnishings, landscaping, street lighting, electrical, irrigation, soil cells, signage, and asphalt paving.

2. Contract items:

A. Bid Opening:

Place: Ready Room Alfred M Brown Operations Center 635 Alfred Brown Jr Court SW

Concord, North Carolina 28026

Date: August 31, 2021

Time: 2:00 PM

B. Register to bid: chestnut@concordnc.gov

C. Technical questions:

Ms. Cranwill will be the main point of contact for questions about the project. Please direct questions in writing to carrie.cranwill@mcgillassociates.com. All questions should be submitted in writing in accordance with the Instructions to Bidders. All questions about the project should be directed to McGill Associates.

- D. Bids to include bid security of 5% of the net price bid.
- E. Contract Time: 540 days from notice to proceed.
- F. Liquated Damages: \$250/day
- G. Alternative product proposals until August 18th.
- H. Bids subject to acceptance for 90 days.
- I. Bidder's Representation.

3. Questions/Comments:

The following project-specific comments and questions were discussed:

- 1. Standard Provisions
 - a. Utilization of standards:

City of Concord

WSAAC

NCDOT for work within the ROW

b. Geotechnical Report:

Geotech report is attached in the Appendix.

c. NCDOT Encroachment Agreement:

Encroachment agreements are attached in the Appendix

d. Hours of work:

For NCDOT ROW standard hours are 9am to 4 pm. Encroachment agreements apply to Cabarrus.

City work hours are limited to 7 am to 7 pm.

Night work to be scheduled in advance.

e. Business ingress and egress:

Contractor is responsible for maintain access to businesses and shop owners during the entirety of the project. Business must be notified 72 hours in advance of any disruptions to access and utility services.

f. Water and sewer service:

Contractor is responsible for maintaining and minimizing disruption of services.

- g. Financial responsibility for sediment and erosion control permit: Contractor will transfer and assume responsibility for the erosion control permit.
- h. Notice of Intent sediment and erosion control permit.
 Contractor is responsible for submitting the Notice of Intent for on the NCDEQ website.
 https://edocs.deq.nc.gov/Forms/NCG01-NOI
- i. Deadline for questions All questions must be submitted by 5:00 pm August 24, 2021.
- j. Question on Owner provided items: All owner provided items will need to be picked up by the Contractor from the Alfred M Brown Operation Center.
- k. Question on Laydown Yard: There will be no City provided laydown yard. Contractor must secure location for use during construction.
- I. Question on Electrical Permits: Contractor is responsible for all permits
- m. Question on Plumbing Permits: Contractor is responsible for all permits
- n. Question on cost of Utility relocation Private Utility providers will need to adjust utilities at no cost to the City and Contractor.
- o. Question on stored materials City will follow NCDOT specifications on stored materials.
- p. Question on limit of subcontracting and minority goals? There are no limits to the amount of subcontract work. There are no set minority

participation goals for this project but using minority subs is encouraged.

- q. Question on temporary paving and sidewalk in front of courthouse? Contractor will install but will not be responsible for removal afterwards.
- r. Question on Water Meters: Are water meters to be purchased or supplied by the City? 2" water meters and smaller will be provided by the City. All meters larger than 2" will be purchased and provided by the Contractor per City Design Requirements.
- s. Question about separating HC ramps as a separate line item? Due to the variety in size and materials HC Ramps will not be a separate pay item. The HC ramps will be paid under the concrete sidewalk, concrete drive, or the brick pavers on 6" concrete line items as a square yard measurement. Descriptions have been modified to clarify they are included in those categories. Railings and domes are a separate payment item as noted previously.
- t. Question on ornamental railing will welding be required? No, fence will be designed for permanent posts and bolted/screwed fence panels.
- u. Will testing be required? City will hire and pay for testing on an as needed basis.
- v. Question on Plumbing fittings: Can fittings provided be foreign? All fittings provided must be domestic.
- w. Comment on unclassified excavation: See Revision to Contract Documents Item 3 Addendum 1
- x. Question on temporary trench cap Is there a detail provided. See Revision to Contract Documents Item 3 Addendum 1
- y. Question on payment item for Utility Trench Cut See Revision to Contract Documents Item 3 Addendum 1
- z. Question on payment item for liquid asphalt See Revision to Contract Documents Item 3 Addendum 1
- aa. Question on payment item for temporary pavement markings See Revision to Contract Documents Item 3 Addendum 1

- bb. Question on curb detail verses curb shown on landscape edging detail.
 See Revision to Contract Documents Item 3 Addendum 1
- cc. Comment: Wood fence installation to take place at same time of wall repair.
- dd. Comment on Landscape plants: Contractor advised to reserve/order plant material at start of project. Plants were available at time of design, there will be no last-minute substitutions because of delay in reserving plant material. Contractor must notify City at the start of the project if they are unable to source any of the plants. Southeastern Plant Nursers located outside of Asheville grows several of the native plants called for. Note specific sizes may be a special order. Landscape material will be installed at the end of the project.
- ee. Comment: Ramp and stairs are shown for reference at 66 Union Street. Installation shown/noted for reference only on sheets.
- ff. Comment: Several other projects are under construction in downtown and certain areas will not be released for construction until Spring of 2022. Please review phasing sheet for additional information. There will only be a partial installation of items at the Courthouse renovation as noted on plans. Remainder of items will be installed in 2024. Refer to drawings for work to be completed in this area.
- gg. Comment: Temporary lighting is to be provided per the contract documents.
- hh. Comment: Phasing of project was discussed. It was also noted that the phasing of the project will be open to changes based on Contractor input as accepted by the City and Engineer.
- ii. Comment: There are several "artistic" items in the scope of the project, please review. Also note the landscape edging will need to contain drainage slots as shown on the detail.
- jj. Comment: There is an existing asbestos cement water line running along Union Avenue that is intended to be removed as part of this project. Please refer to the contract documents for requirements specific to handling and disposal of asbestos cement pipe.
- kk. Comment: The project phasing anticipates installation of the new water lines prior to full street pavement demolition. This phasing would

Union Streets Improvements Pre-Bid Meeting, August 20, 2021 Page 6 of 6

require cutting of existing pavement to install the water lines. Trench backfill within these areas should be capped with asphalt pavement according to the project details.

II. Comment: The announcement kiosk that will hold electrical panels LP-B1 and LP-B2 is a custom item. Contractor should begin early to coordinate this item with the manufacturer.

*Nothing stated at the pre-bid meeting will change the project documents unless a subsequent addendum is issued.



Pre-Bid Meeting Sign-In

Tuesday, August 17, 2021, 2:00 PM

Brown Operations Center 635 Alfred Brown Jr Court SW Concord, NC, 28025

Ready Room

Attendance

Name	Phone Number	Company
JASON BREE	704 522 1102	SEALAND CONTRACTIES COEP.
Carredonull	HENE 305-363	MG.11
Wes Fleming	828-328-2024	McG:11
Mosthew Outling	828-328-2024	McGil
Mark Hoesman	Mod-855-7483	Carolina Sitemorks
SEANSANFORD	980-521-8455	City of Concord
GARY STANSON	704-920-5904	
Brian Morris	704-361-2051	INE'S Construction
Gerald Waren	704-9152199	City of control whom Plury
Speve Osbarne	704.920-5132	Concord Planning
She Hyde	704.920.5401	City of Concord Eng

EXHIBIT A – BID FORM

PROJECT IDENTIFICATION:

Union Street Improvements Project No. 2020-009 (McGill Associates project #19.01726)

THIS BID IS SUBMITTED TO:

Sue Hyde, Engineering Director
City of Concord
635 Alfred Brown Jr Court SW
P.O. Box 308
Concord, North Carolina 28026-0308

- The undersigned Bidder proposes and agrees, if this Bid is accepted, to enter into an
 agreement with Owner in the form included in the Contract Documents to perform and furnish
 all Work as specified or indicated in the Contract Documents within the specified time and for
 the amount indicated in this Bid and in accordance with the other terms and conditions of the
 Contract Documents.
- 2. Bidder accepts all of the terms and conditions of the Invitation to Bid and the Instructions to Bid, including without limitation those dealing with the disposition of the Bid security is required for this project.
- 3. This Bid will remain subject to acceptance for 90 days after the day designated for reception of Bids. Bidder will sign and submit the Agreement with the Bonds and other documents required by the Quoting Documents within 10 days after the date of Owner's Notice of Award.
- 4. In submitting this Bid, Bidder represents that:
 - a. Bidder has examined copies of all the Quoting Documents and of the following Addenda (receipt of all which is hereby acknowledged):

No	Dated
No	Dated

- b. Bidder has visited the site and become familiar with and satisfied itself as to the general, local, and site conditions that may affect cost, progress, performance, and furnishing of the Work.
- c. Bidder is familiar with and has satisfied itself as to all Federal, State, and Local Laws and Regulations that may affect cost, progress, performance, and furnishing of Work.

- Bidder has carefully studied all reports of explorations and tests of subsurface conditions at or contiguous to the site and all drawings of physical conditions in or relating to existing surface or subsurface structures at or contiguous to the site (except underground facilities) which have provided by the owner and under the conditions normally used and identified in the Supplementary Conditions and Special Conditions as provided in Paragraph 4.2.1 of the General Conditions. Bidder accepts the determination set forth in the Supplementary Conditions and Special Conditions of the extent of the "technical data" contained in such reports and drawings upon which Bidder is entitled to rely as provided in Paragraph 4.2 of the General Conditions. Bidder acknowledges that such reports and drawings are not Contract Documents and may not be complete for Bidder's purposes. Bidder acknowledges that Owner and Engineer do not assume responsibility for the accuracy or completeness of information and data shown or indicated in the Quoting Documents with respect to underground facilities at or contiguous to the site. Bidder has obtained and carefully studied (or assumes responsibility for having done so) all such additional or supplementary examinations, investigations. explorations, tests, studies, and data concerning conditions (surface, subsurface, and underground facilities) at or contiguous to the site or otherwise which may affect cost, progress, performance, or furnishing of the Work or which relate to any aspect of the means, methods, techniques, sequences, and procedures of construction to be employed by Bidder and safety precautions and programs incident thereto. Bidder does not consider that any additional examinations, investigations, explorations, tests, studies, or data are necessary for the determination of this Bid for performance and furnishing of the Work in accordance with the time, price, and other terms and conditions of the Contract Documents.
- e. Bidder is aware of the general nature of Work to be performed by Owner and others at the site that relates to Work for which this Bid is submitted as indicated in the Contract Documents.
- f. Bidder has correlated the information known to Bidder, information and observations obtained from visits to the site, reports and drawings identified in the Contract Documents, and all additional examinations, investigations, explorations, tests, studies, and data with the Contract Documents.
- g. Bidder has given Engineer written and verbal notice of all conflicts, errors, ambiguities, or discrepancies that Bidder has discovered in the Contract Documents and the written resolution thereof by Engineer is acceptable to Bidder, and the Contract Documents are generally sufficient to indicate and convey understanding of all terms and conditions for performing and furnishing the Work for which this Bid is submitted.
- h. This Bid is genuine and not made in the interest of or on behalf of any undisclosed person, firm, or corporation and is not submitted in conformity with any agreement or rules of any group, association, organization, or corporation; Bidder has not directly or indirectly induced or solicited any other Bidder to submit a false or sham Bid Bidder has not solicited or induced any person, firm, or corporation to refrain from quoting; and Bidder has not sought by collusion to obtain for itself any advantage over any other Bidder or over Owner.
- 5. Bidder will complete the Work for the following unit prices. Quantities indicated are estimated and not guaranteed; they are solely for comparing Bids and establishing the initial Contract Price. Final payment will be based on actual quantities.

Union Streetscape Site Improvements City Project No. 2020-009 McGill Project No. 19.01726 Addendum 1

No.	Item	Description	Qty.	Units	Unit Price (\$)	Item Total (\$)
		Base Bid - General Work	Items			
1	800	Mobilization (3.0%)	1	LS		
2	801	Construction Surveying	1	LS		
3	SP-01	Vehicular Traffic Control	1	LS		
4	SP-02	Pedestrian Access and Safety	1	LS		
5	SP-03	Comprehensive Grading	1	LS		
6	225	Undercut Excavation	200	CY		
7	607	Variable Asphalt Mill	3,166	SY		
8	520	Aggregate Base Course	4,700	TN		
9	610	S9.5C surface course	923	TN		
10	610	I19.0C Intermediate Course	1,203	TN		
11	610	B25.OC Base Course	134	TN		
12	610	Variable Asphalt Overlay 1.5"-3"	542	TN		
13	620	Asphalt Binder for Plant Mix	180	TN		
14	SP-04	18" Concrete Grade Beam	46	LF		
15	SP-05	6" Concrete Drive Apron/Drive/HC Ramps	326	SY		
16	SP-06	4" Concrete Sidewalk and HC Ramps	4,116	SY		
17	SP-07	Pavers - Light Duty on 4" Concrete Base	276	SY		
18	SP-08	Pavers - Heavy Duty on 6" Concrete Base/HC Ramps	310	SY		
19	SP-09	Brick Band on 4" Concrete Base	3,517	LF		
20	SP-10	Plaza Pavers - Vehicular	230	SY		
21	SP-11	Brick Paver Crosswalk	142	SY		
22	SP-12	Stamped Asphalt Crosswalk	400	SY		
23	SP-13	2'-6" Concrete Curb and Gutter	159	LF		
24	SP-14	6" Concrete Stand-up Curb	582	LF		
25	SP-15	8" Concrete Stand-up Curb	3,038	LF		
26	SP-16	Concrete Landscape Edging	1,013	LF		
27	SP-17	6" Concrete Edge Restraint	1,249	LF		
28	SP-18	Concrete Edge Restraint to Match Plaza	34	LF		
29	SP-19	Granite Edge Restraint	318	LF		
30	SP-20	Bronze Sidewalk Trail Markers	1	LS		
31	SP-21	Detectable Warning Plate	599	SF		
32	SP-22	Metal Handrail at HC Ramps	68	LF		
33	SP-23	Sign Installation	18	EA		

SP-25 Bench Installation (Owner Provided) 16 EA	34	SP-24	Salvaged Wayfinding Sign Installation	1	EA	
SP-26 Irash/Recycling Receptacle Installation (Owner Provided)	-			16		
SP-28 Reinstall Bike Rack 2			Trash/Recycling Receptacle Installation (Owner			
39 SP-29 Drinking Fountain 1 EA	37	SP-27	, ,	1	EA	
40 SP-30 Bollards (Non-lighted) 5 EA	38	SP-28	Reinstall Bike Rack	2	EA	
41 SP-31 Flag Holder	39	SP-29	Drinking Fountain	1	EA	
42 SP-32 Horse Hook Art Installation 1 LS 43 SP-33 Granite Marker for Surveyor Stone 1 LS 44 SP-34 Metal Air Vent Replacement 1 LS 45 1087 4" Thermoplastic Paint - 90 mils 2,010 LF 46 1087 4" Thermoplastic Paint - 120 mils 3,856 LF 47 1087 8" Thermoplastic Paint - 120 mils 1,116 LF 48 1087 24" White Thermoplastic Paint - 120 mils 221 LF 49 1087 Thermoplastic Compass - 120 mils 1 LS 50 1087 Thermoplastic Compass - 120 mils 1 LS 51 1205 4" Temporary Paint 3,856 LF 52 1205 8" Temporary Paint 1,116 LF 53 1205 24" Temporary Paint 1,116 LF 54 1205 Temporary Paint 1,116 LF 55 SP-35 Monolithic Retaining Wall 528	40	SP-30	Bollards (Non-lighted)	5	EA	
43 SP-33 Granite Marker for Surveyor Stone 1 LS 44 SP-34 Metal Air Vent Replacement 1 LS 45 1087 4" Thermoplastic Paint - 120 mils 2,010 LF 46 1087 4" Thermoplastic Paint - 120 mils 3,856 LF 47 1087 8" Thermoplastic Paint - 120 mils 1,116 LF 48 1087 24" White Thermoplastic Paint - 120 mils 221 LF 49 1087 Thermoplastic Compass - 120 mils 1 LS 50 1087 Thermoplastic Compass - 120 mils 1 LS 51 1205 4" Temporary Paint 3,856 LF 52 1205 8" Temporary Paint 1,116 LF 53 1205 24" Temporary Paint 221 LF 54 1205 Temporary Paint Traffic Arrows and Symbols 38 EA 55 SP-35 Monolithic Retaining Wall 528 LF 56 SP-36 Stone Seat Wall <td< td=""><td>41</td><td>SP-31</td><td>Flag Holder</td><td>1</td><td>LS</td><td></td></td<>	41	SP-31	Flag Holder	1	LS	
44 SP-34 Metal Air Vent Replacement 1 LS 45 1087 4" Thermoplastic Paint - 90 mils 2,010 LF 46 1087 4" Thermoplastic Paint - 120 mils 3,856 LF 47 1087 8" Thermoplastic Paint - 120 mils 1,116 LF 48 1087 24" White Thermoplastic Paint - 120 mils 221 LF 49 1087 Thermoplastic Compass - 120 mils 1 LS 50 1087 Thermoplastic Compass - 120 mils 1 LS 51 1205 4" Temporary Paint 3,856 LF 52 1205 8" Temporary Paint 1,116 LF 53 1205 24" Temporary Paint 221 LF 54 1205 Temporary Paint Traffic Arrows and Symbols 38 EA 55 SP-35 Monolithic Retaining Wall 528 LF 56 SP-36 Stone Seat Wall 1 LS 57 SP-37 Concrete Stair and HC Ramp w/ Handrails	42	SP-32	Horse Hook Art Installation	1	LS	
45 1087 4" Thermoplastic Paint - 90 mils 2,010 LF 46 1087 4" Thermoplastic Paint - 120 mils 3,856 LF 47 1087 8" Thermoplastic Paint - 120 mils 1,116 LF 48 1087 24" White Thermoplastic Paint - 120 mils 221 LF 49 1087 Thermoplastic Traffic Arrows and Symbols - 120 mils 1 LS 50 1087 Thermoplastic Compass - 120 mils 1 LS 51 1205 4" Temporary Paint 3,856 LF 52 1205 8" Temporary Paint 1,116 LF 53 1205 24" Temporary Paint 221 LF 54 1205 Temporary Paint Traffic Arrows and Symbols 38 EA 55 SP-35 Monolithic Retaining Wall 528 LF 56 SP-36 Stone Seat Wall 1 LS 57 SP-37 Concrete Stair w/ Handrails 1 LS 58 SP-38 Concrete Stair and HC Ramp w/ Handrails 1 LS 59 SP-39 Wood Fenc	43	SP-33	Granite Marker for Surveyor Stone	1	LS	
46 1087 4" Thermoplastic Paint - 120 mils 3,856 LF 47 1087 8" Thermoplastic Paint - 120 mils 1,116 LF 48 1087 24" White Thermoplastic Paint - 120 mils 221 LF 49 1087 Thermoplastic Compass - 120 mils 1 LS 50 1087 Thermoplastic Compass - 120 mils 1 LS 51 1205 4" Temporary Paint 3,856 LF 52 1205 8" Temporary Paint 1,116 LF 53 1205 24" Temporary Paint 221 LF 54 1205 Temporary Paint Traffic Arrows and Symbols 38 EA 55 SP-35 Monolithic Retaining Wall 528 LF 56 SP-36 Stone Seat Wall 1 LS 57 SP-37 Concrete Stair w/ Handrails 1 LS 58 SP-38 Concrete Stair and HC Ramp w/ Handrails 1 LS 59 SP-39 Wood Fence Replacement w/Gate <td< td=""><td>44</td><td>SP-34</td><td>Metal Air Vent Replacement</td><td>1</td><td>LS</td><td></td></td<>	44	SP-34	Metal Air Vent Replacement	1	LS	
47 1087 8" Thermoplastic Paint - 120 mils 1,116 LF 48 1087 24" White Thermoplastic Paint - 120 mils 221 LF 49 1087 Thermoplastic Traffic Arrows and Symbols - 120 mils 39 EA 50 1087 Thermoplastic Compass - 120 mils 1 LS 51 1205 4" Temporary Paint 3,856 LF 52 1205 8" Temporary Paint 1,116 LF 53 1205 24" Temporary Paint 221 LF 54 1205 Temporary Paint Traffic Arrows and Symbols 38 EA 55 SP-35 Monolithic Retaining Wall 528 LF 56 SP-36 Stone Seat Wall 1 LS 57 SP-37 Concrete Stair w/ Handrails 1 LS 58 SP-38 Concrete Stair and HC Ramp w/ Handrails 1 LS 59 SP-39 Wood Fence Replacement w/Gate 1 LS 60 SP-40 Ornamental Railing Installation 482 LF 61 SP-41 4'x4' Tree Grate<	45	1087	4" Thermoplastic Paint - 90 mils	2,010	LF	
48 1087 24" White Thermoplastic Paint - 120 mils 221 LF 49 1087 Thermoplastic Traffic Arrows and Symbols - 120 mils 39 EA 50 1087 Thermoplastic Compass - 120 mils 1 LS 51 1205 4" Temporary Paint 3,856 LF 52 1205 8" Temporary Paint 1,116 LF 53 1205 24" Temporary Paint 221 LF 54 1205 Temporary Paint Traffic Arrows and Symbols 38 EA 55 SP-35 Monolithic Retaining Wall 528 LF 56 SP-36 Stone Seat Wall 1 LS 57 SP-37 Concrete Stair w/ Handrails 1 LS 58 SP-38 Concrete Stair and HC Ramp w/ Handrails 1 LS 59 SP-39 Wood Fence Replacement w/Gate 1 LS 60 SP-40 Ornamental Railing Installation 482 LF 61 SP-41 4'x4' Tree Grate 24 EA 62 SP-42 Planting Cells 1	46	1087	4" Thermoplastic Paint - 120 mils	3,856	LF	
49 1087 Thermoplastic Traffic Arrows and Symbols - 120 mils 39 EA 50 1087 Thermoplastic Compass - 120 mils 1 LS 51 1205 4" Temporary Paint 3,856 LF 52 1205 8" Temporary Paint 1,116 LF 53 1205 24" Temporary Paint 221 LF 54 1205 Temporary Paint Traffic Arrows and Symbols 38 EA 55 SP-35 Monolithic Retaining Wall 528 LF 56 SP-36 Stone Seat Wall 1 LS 57 SP-37 Concrete Stair w/ Handrails 1 LS 58 SP-38 Concrete Stair and HC Ramp w/ Handrails 1 LS 59 SP-39 Wood Fence Replacement w/Gate 1 LS 60 SP-40 Ornamental Railing Installation 482 LF 61 SP-41 4'x4' Tree Grate 24 EA 62 SP-42 Planting Cells 1 LS 63 SP-43 Regal Prince Oak 11 EA <	47	1087	8" Thermoplastic Paint - 120 mils	1,116	LF	
1087 120 mils 39	48	1087	24" White Thermoplastic Paint - 120 mils	221	LF	
51 1205 4" Temporary Paint 3,856 LF 52 1205 8" Temporary Paint 1,116 LF 53 1205 24" Temporary Paint 221 LF 54 1205 Temporary Paint Traffic Arrows and Symbols 38 EA 55 SP-35 Monolithic Retaining Wall 528 LF 56 SP-36 Stone Seat Wall 1 LS 57 SP-37 Concrete Stair w/ Handrails 1 LS 58 SP-37 Concrete Stair and HC Ramp w/ Handrails 1 LS 59 SP-38 Concrete Stair and HC Ramp w/ Handrails 1 LS 59 SP-39 Wood Fence Replacement w/Gate 1 LS 60 SP-40 Ornamental Railing Installation 482 LF 61 SP-41 4'x4' Tree Grate 24 EA 62 SP-42 Planting Cells 1 LS 63 SP-43 Regal Prince Oak 11 EA 64 SP-44 Japanese Zelkova 8 EA 65<	49	1087	i i	39	EA	
52 1205 8" Temporary Paint 1,116 LF 53 1205 24" Temporary Paint 221 LF 54 1205 Temporary Paint Traffic Arrows and Symbols 38 EA 55 SP-35 Monolithic Retaining Wall 528 LF 56 SP-36 Stone Seat Wall 1 LS 57 SP-37 Concrete Stair w/ Handrails 1 LS 58 SP-38 Concrete Stair and HC Ramp w/ Handrails 1 LS 59 SP-39 Wood Fence Replacement w/Gate 1 LS 60 SP-40 Ornamental Railing Installation 482 LF 61 SP-40 Ornamental Railing Installation 482 LF 61 SP-41 4'x4' Tree Grate 24 EA 62 SP-42 Planting Cells 1 LS 63 SP-43 Regal Prince Oak 11 EA 64 SP-44 Japanese Zelkova 8 EA 65 SP-45 Dwarf Japanese Maple 2 EA 66	50	1087	Thermoplastic Compass - 120 mils	1	LS	
53 1205 24" Temporary Paint 221 LF 54 1205 Temporary Paint Traffic Arrows and Symbols 38 EA 55 SP-35 Monolithic Retaining Wall 528 LF 56 SP-36 Stone Seat Wall 1 LS 57 SP-37 Concrete Stair w/ Handrails 1 LS 58 SP-38 Concrete Stair and HC Ramp w/ Handrails 1 LS 59 SP-39 Wood Fence Replacement w/Gate 1 LS 60 SP-40 Ornamental Railing Installation 482 LF 61 SP-40 Ornamental Railing Installation 482 LF 61 SP-41 4'x4' Tree Grate 24 EA 62 SP-42 Planting Cells 1 LS 63 SP-43 Regal Prince Oak 11 EA 64 SP-44 Japanese Zelkova 8 EA 65 SP-45 Dwarf Japanese Maple 2 EA 66 SP-46 Rising Sun Redbud 4 EA 67	51	1205	4" Temporary Paint	3,856	LF	
54 1205 Temporary Paint Traffic Arrows and Symbols 38 EA 55 SP-35 Monolithic Retaining Wall 528 LF 56 SP-36 Stone Seat Wall 1 LS 57 SP-37 Concrete Stair w/ Handrails 1 LS 58 SP-38 Concrete Stair and HC Ramp w/ Handrails 1 LS 59 SP-39 Wood Fence Replacement w/Gate 1 LS 60 SP-40 Ornamental Railing Installation 482 LF 61 SP-40 Ornamental Railing Installation 482 LF 61 SP-41 4'x4' Tree Grate 24 EA 62 SP-42 Planting Cells 1 LS 63 SP-43 Regal Prince Oak 11 EA 64 SP-44 Japanese Zelkova 8 EA 65 SP-45 Dwarf Japanese Maple 2 EA 66 SP-46 Rising Sun Redbud 4 EA 67 SP-47 Espresso Kentucky Coffee Tree 11 EA 68 </td <td>52</td> <td>1205</td> <td>8" Temporary Paint</td> <td>1,116</td> <td>LF</td> <td></td>	52	1205	8" Temporary Paint	1,116	LF	
55 SP-35 Monolithic Retaining Wall 528 LF 56 SP-36 Stone Seat Wall 1 LS 57 SP-37 Concrete Stair w/ Handrails 1 LS 58 SP-38 Concrete Stair and HC Ramp w/ Handrails 1 LS 59 SP-39 Wood Fence Replacement w/Gate 1 LS 60 SP-40 Ornamental Railing Installation 482 LF 61 SP-41 4'x4' Tree Grate 24 EA 62 SP-42 Planting Cells 1 LS 63 SP-43 Regal Prince Oak 11 EA 64 SP-44 Japanese Zelkova 8 EA 65 SP-45 Dwarf Japanese Maple 2 EA 66 SP-46 Rising Sun Redbud 4 EA 67 SP-47 Espresso Kentucky Coffee Tree 11 EA 68 SP-48 Wildfire Black Gum 9 EA 69 SP-49 Skyline Honeylocust 4 EA	53	1205	24" Temporary Paint	221	LF	
56 SP-36 Stone Seat Wall 1 LS 57 SP-37 Concrete Stair w/ Handrails 1 LS 58 SP-38 Concrete Stair and HC Ramp w/ Handrails 1 LS 59 SP-39 Wood Fence Replacement w/Gate 1 LS 60 SP-40 Ornamental Railing Installation 482 LF 61 SP-41 4'x4' Tree Grate 24 EA 62 SP-42 Planting Cells 1 LS 63 SP-43 Regal Prince Oak 11 EA 64 SP-44 Japanese Zelkova 8 EA 65 SP-45 Dwarf Japanese Maple 2 EA 66 SP-46 Rising Sun Redbud 4 EA 67 SP-47 Espresso Kentucky Coffee Tree 11 EA 68 SP-48 Wildfire Black Gum 9 EA 69 SP-49 Skyline Honeylocust 4 EA	54	1205	Temporary Paint Traffic Arrows and Symbols	38	EA	
57SP-37Concrete Stair w/ Handrails1LS58SP-38Concrete Stair and HC Ramp w/ Handrails1LS59SP-39Wood Fence Replacement w/Gate1LS60SP-40Ornamental Railing Installation482LF61SP-414'x4' Tree Grate24EA62SP-42Planting Cells1LS63SP-43Regal Prince Oak11EA64SP-44Japanese Zelkova8EA65SP-45Dwarf Japanese Maple2EA66SP-46Rising Sun Redbud4EA67SP-47Espresso Kentucky Coffee Tree11EA68SP-48Wildfire Black Gum9EA69SP-49Skyline Honeylocust4EA	55	SP-35	Monolithic Retaining Wall	528	LF	
58SP-38Concrete Stair and HC Ramp w/ Handrails1LS59SP-39Wood Fence Replacement w/Gate1LS60SP-40Ornamental Railing Installation482LF61SP-414'x4' Tree Grate24EA62SP-42Planting Cells1LS63SP-43Regal Prince Oak11EA64SP-44Japanese Zelkova8EA65SP-45Dwarf Japanese Maple2EA66SP-46Rising Sun Redbud4EA67SP-47Espresso Kentucky Coffee Tree11EA68SP-48Wildfire Black Gum9EA69SP-49Skyline Honeylocust4EA	56	SP-36	Stone Seat Wall	1	LS	
59 SP-39 Wood Fence Replacement w/Gate 1 LS 60 SP-40 Ornamental Railing Installation 482 LF 61 SP-41 4'x4' Tree Grate 24 EA 62 SP-42 Planting Cells 1 LS 63 SP-43 Regal Prince Oak 11 EA 64 SP-44 Japanese Zelkova 8 EA 65 SP-45 Dwarf Japanese Maple 2 EA 66 SP-46 Rising Sun Redbud 4 EA 67 SP-47 Espresso Kentucky Coffee Tree 11 EA 68 SP-48 Wildfire Black Gum 9 EA 69 SP-49 Skyline Honeylocust 4 EA	57	SP-37	Concrete Stair w/ Handrails	1	LS	
60 SP-40 Ornamental Railing Installation 482 LF 61 SP-41 4'x4' Tree Grate 24 EA 62 SP-42 Planting Cells 1 LS 63 SP-43 Regal Prince Oak 11 EA 64 SP-44 Japanese Zelkova 8 EA 65 SP-45 Dwarf Japanese Maple 2 EA 66 SP-46 Rising Sun Redbud 4 EA 67 SP-47 Espresso Kentucky Coffee Tree 11 EA 68 SP-48 Wildfire Black Gum 9 EA 69 SP-49 Skyline Honeylocust 4 EA	58	SP-38	Concrete Stair and HC Ramp w/ Handrails	1	LS	
61 SP-41 4'x4' Tree Grate 24 EA 62 SP-42 Planting Cells 1 LS 63 SP-43 Regal Prince Oak 11 EA 64 SP-44 Japanese Zelkova 8 EA 65 SP-45 Dwarf Japanese Maple 2 EA 66 SP-46 Rising Sun Redbud 4 EA 67 SP-47 Espresso Kentucky Coffee Tree 11 EA 68 SP-48 Wildfire Black Gum 9 EA 69 SP-49 Skyline Honeylocust 4 EA	59	SP-39	Wood Fence Replacement w/Gate	1	LS	
62 SP-42 Planting Cells 1 LS 63 SP-43 Regal Prince Oak 11 EA 64 SP-44 Japanese Zelkova 8 EA 65 SP-45 Dwarf Japanese Maple 2 EA 66 SP-46 Rising Sun Redbud 4 EA 67 SP-47 Espresso Kentucky Coffee Tree 11 EA 68 SP-48 Wildfire Black Gum 9 EA 69 SP-49 Skyline Honeylocust 4 EA	60	SP-40	Ornamental Railing Installation	482	LF	
63 SP-43 Regal Prince Oak 64 SP-44 Japanese Zelkova 65 SP-45 Dwarf Japanese Maple 66 SP-46 Rising Sun Redbud 67 SP-47 Espresso Kentucky Coffee Tree 68 SP-48 Wildfire Black Gum 69 SP-49 Skyline Honeylocust 61 EA 62 SP-49 Skyline Honeylocust 63 In EA 65 EA 66 EA 67 SP-48 EA 68 SP-48 Wildfire Black Gum 69 SP-49 Skyline Honeylocust 69 SP-49 Skyline Honeylocust	61	SP-41	4'x4' Tree Grate	24	EA	
64 SP-44 Japanese Zelkova 8 EA 65 SP-45 Dwarf Japanese Maple 2 EA 66 SP-46 Rising Sun Redbud 4 EA 67 SP-47 Espresso Kentucky Coffee Tree 11 EA 68 SP-48 Wildfire Black Gum 9 EA 69 SP-49 Skyline Honeylocust 4 EA	62	SP-42	Planting Cells	1	LS	
65 SP-45 Dwarf Japanese Maple 66 SP-46 Rising Sun Redbud 67 SP-47 Espresso Kentucky Coffee Tree 68 SP-48 Wildfire Black Gum 69 SP-49 Skyline Honeylocust 2 EA 4 EA 5 EA 6 EA 6 EA	63	SP-43	Regal Prince Oak	11	EA	
66SP-46Rising Sun Redbud4EA67SP-47Espresso Kentucky Coffee Tree11EA68SP-48Wildfire Black Gum9EA69SP-49Skyline Honeylocust4EA	64	SP-44	Japanese Zelkova	8	EA	
67 SP-47 Espresso Kentucky Coffee Tree 11 EA 9 EA 68 SP-49 Skyline Honeylocust 4 EA	65	SP-45	Dwarf Japanese Maple	2	EA	
68 SP-48 Wildfire Black Gum 9 EA 69 SP-49 Skyline Honeylocust 4 EA	66	SP-46	Rising Sun Redbud	4	EA	
68SP-48Wildfire Black Gum9EA69SP-49Skyline Honeylocust4EA	67	SP-47	Espresso Kentucky Coffee Tree	11	EA	
	68	SP-48	Wildfire Black Gum	9	EA	
	69	SP-49	Skyline Honeylocust	4	EA	
	70	SP-50		17	EA	

71	SP-51	Jewel Box Distylium	4	EA	
72		Treeform Limelight Hydrangea	9	EA	
73	SP-53	Birchleaf Spirea	14	EA	
74		Gem box Inkberry Holly	36	EA	
75		Anna's Magic Ball Arborvitae	55	EA	
76	SP-56	Virginia Sweetspire	12	EA	
77	SP-57	Purple Pixie Loropetalum	6	EA	
78	SP-58	Chokeberry	72	EA	
79	SP-59	Witherod Viburnum	79	EA	
80	SP-60	Kelsey's Dwarf Red-Osier Dogwood	113	EA	
81	SP-61	Feather Reed Grass	71	EA	
82	SP-62	Dwarf Fountain Grass	114	EA	
83	SP-63	Palace Purple Heuchera	50	EA	
84	SP-64	Tickseed	75	EA	
85	SP-65	Firewitch Dianthus	123	EA	
86	SP-66	Variegated Liriope	109	EA	
87	SP-67	Liriope	727	EA	
88	SP-68	Littleleaf Periwinkle	293	EA	
89	SP-69	Creeping Lily Turf	115	EA	
90	SP-70	Annuals	61	SF	
91	SP-71	Irrigation	1	LS	
92	SP-72	Granite Stormwater Flume Installation	1	LS	
93	SP-73	Straw Wattle Protection	1	LS	
94	SP-74	Mud Mat Construction Entrance	1	LS	
95	SP-75	Silt Sak	1	LS	
96	SP-76	Stone Inlet Protection	27	EA	
97	840	Drop Inlet w/ Frame and Grate	2	EA	
98	840	Curb Inlet w/ Frame, Grate, and Hood	26	EA	
99	840	Stormwater Manhole	5	EA	
100	SP-77	6" Nyoplast Drains	5	EA	
101	SP-78	10" Nyoplast Drains	1	EA	
102	SP-79	3" Cleanouts	5	EA	
103	SP-80	4" Cleanouts	1	EA	
104	SP-81	6" Cleanouts	4	EA	
105	SP-82	8" Cleanouts	2	EA	
106		3" SCH 40 PVC Stormwater	278	LF	
107	SP-84	4" SCH 40 PVC Stormwater	94	LF	
108	SP-85	6" SCH 40 PVC Stormwater	171	LF	
109	SP-86	8" SCH 40 PVC Stormwater	65	LF	
110	300	Foundation Conditioning	10	TN	
111	300	Foundation Conditioning Fabric	100	SY	
112	654	Stormwater Trench Repair	180	TN	

113 310 15" RCP Class IV 159 LF 151 114 310 18" RCP Class IV 373 LF 151 LF 151 115 310 24" RCP Class IV 373 LF 151 LF 151 116 310 30" RCP Class IV 373 LF 151 LF 151 117 310 36" RCP Class IV 32 LF 151 118 310 42" RCP Class IV 32 LF 151 119 WSACC 4' Dia. Sewer MH 1 1 EA			T			T
115 310 24" RCP Class IV 373 LF	113	310	15" RCP Class IV	599	LF	
116 310 30" RCP Class IV 32 LF	114	310	18" RCP Class IV	153	LF	
117 310 36" RCP Class IV 479 LF 118 310 42" RCP Class IV 479 LF 119 WSACC 4" Dia. Sewer MH 1 EA 1	115	310	24" RCP Class IV	373	LF	
118 310 42" RCP Class IV 479 LF 19 WSACC 4" Dia. Sewer MH 1 EA EA	116	310	30" RCP Class IV	623	LF	
119	117	310	36" RCP Class IV	32	LF	
120 SP-87 S' Dia. Doghouse Sewer MH - Flowable Fill Backfill 1 EA	118	310	42" RCP Class IV	479	LF	
120 SP-87 Backfill 1	119	WSACC	4' Dia. Sewer MH	1	EA	
122 SP-89 8" DI Sewer - Flowable Fill Backfill 15	120	SP-87	_	1	EA	
123 SP-90 8" PVC Sewer Service 300 LF 124 SP-91 6" PVC Sewer Service 300 LF 125 SP-92 4" PVC Sewer Service 700 LF 126 SP-93 4" PVC Sewer Service - Flowable Fill Backfill 10 LF 127 SP-94 4" PVC Sewer Service - Class A Arch 128 SP-95 8" Clean-Out with Mini Manhole 1 EA 129 SP-96 6" Clean-Out with Mini Manhole 18 EA 130 SP-97 4" Clean-Out with Mini Manhole 18 EA 131 SP-98 Disconnect and Reconnect Exist Sewer Service 1 EA 132 SP-99 Replace Exist. 12" VCP Sewer Main with 12" 120 LF 133 SP-100 Replace Exist. 8" VCP Sewer Main with 8" DIP Sewer Main 134 SP-101 Concrete Collar 3 EA 135 SP-102 16" Ductile Iron Water Line 1600 LF 136 SP-103 12" Ductile Iron Water Line 30 LF 137 SP-104 8" Ductile Iron Water Line 70 LF 138 SP-105 6" Ductile Iron Water Line 350 LF 139 SP-106 4" Ductile Iron Water Line 120 LF 140 SP-107 Backfill 50 LF 141 SP-108 12" Ductile Iron Water Line - Flowable Fill Backfill 55 LF 143 SP-101 16" Ductile Iron Water Line - Flowable Fill Backfill 55 LF 144 SP-110 16" Gate Valve 15 EA 145 SP-111 12" Gate Valve 2 EA 146 SP-112 8" Gate Valve 2 EA 146 SP-113 6" Gate Valve 2 EA 146 SP-113 6" Gate Valve 2 EA 146 SP-113 6" Gate Valve 18 EA	121	SP-88	8" DI Sewer	200	LF	
124 SP-91 6" PVC Sewer Service 300 LF	122	SP-89	8" DI Sewer - Flowable Fill Backfill	15	LF	
125 SP-92 4" PVC Sewer Service 700 LF 126 SP-93 4" PVC Sewer Service - Flowable Fill Backfill 10 LF 127 SP-94 4" PVC Sewer Service - Class A Arch 128 SP-95 SP-96 Clean-Out with Mini Manhole 1 EA 129 SP-96 6" Clean-Out with Mini Manhole 18 EA 130 SP-97 4" Clean-Out with Mini Manhole 38 EA 131 SP-98 Disconnect and Reconnect Exist Sewer Service 1 EA 132 SP-99 Disconnect and Reconnect Exist Sewer Service 1 EA 133 SP-99 Disconnect and Reconnect Exist Sewer Service 1 EA 134 SP-90 Replace Exist. 12" VCP Sewer Main with 12" 120 LF 135 SP-100 Replace Exist. 8" VCP Sewer Main with 8" DIP Sewer Main 134 SP-101 Concrete Collar 3 EA 135 SP-102 16" Ductile Iron Water Line 1600 LF 136 SP-103 12" Ductile Iron Water Line 30 LF 137 SP-104 8" Ductile Iron Water Line 350 LF 138 SP-105 6" Ductile Iron Water Line 120 LF 140 SP-107 16" Ductile Iron Water Line 120 LF 141 SP-108 12" Ductile Iron Water Line - Flowable Fill 50 LF 142 SP-109 10" Ductile Iron Water Line - Flowable Fill SEA 10" Ductile Iron Water Line - Flowable Fill SEA 10" Ductile Iron Water Line - Flowable Fill SEA 10" Ductile Iron Water Line - Flowable Fill SEA 10" Ductile Iron Water Line - Flowable Fill SEA 10" Ductile Iron Water Line - Flowable Fill SEA 10" Ductile Iron Water Line - Flowable Fill SEA 10" Ductile Iron Water Line - Flowable Fill SEA 10" Ductile Iron Water Line - Flowable Fill SEA 10" Ductile Iron Water Line - Flowable Fill SEA 10" Ductile Iron Water Line - Flowable Fill SEA 10" Ductile Iron Water Line - Flowable Fill SEA 10" Ductile Iron Water Line - Flowable Fill SEA 10" Ductile Iron Water Line - Flowable Fill SEA 10" Ductile Iron Water Line - Flowable Fill SEA 10" Ductile Iron Water Line - Flowable Fill SEA 10" Ductile Iron Water Line - Flowable Fill SEA 10" Ductile Iron	123	SP-90	8" PVC Sewer Service	30	LF	
126 SP-93 4" PVC Sewer Service - Flowable Fill Backfill 10 LF	124	SP-91	6" PVC Sewer Service	300	LF	
127 SP-94 4" PVC Sewer Service - Class A Arch Encasement 150 LF 128 SP-95 8" Clean-Out with Mini Manhole 1 EA 129 SP-96 6" Clean-Out with Mini Manhole 18 EA 130 SP-97 4" Clean-Out with Mini Manhole 38 EA 131 SP-98 Disconnect and Reconnect Exist Sewer Service 1 EA 132 SP-99 Replace Exist. 12" VCP Sewer Main with 12" DIP Sewer Main 133 SP-100 Replace Exist. 8" VCP Sewer Main with 8" DIP Sewer Main 134 SP-101 Concrete Collar 3 EA 135 SP-102 16" Ductile Iron Water Line 1600 LF 136 SP-103 12" Ductile Iron Water Line 30 LF 137 SP-104 8" Ductile Iron Water Line 70 LF 138 SP-105 6" Ductile Iron Water Line 350 LF 139 SP-106 4" Ductile Iron Water Line 120 LF 140 SP-107 16" Ductile Iron Water Line - Flowable Fill Backfill 50 LF 141 SP-108 12" Ductile Iron Water Line - Flowable Fill Backfill 10" Ductile Iron Water Line - Flowable Fill Backfill 10" Ductile Iron Water Line - Flowable Fill Backfill 10" Ductile Iron Water Line - Flowable Fill Backfill 10" Ductile Iron Water Line - Flowable Fill Backfill 25 LF 143 SP-110 16" Gate Valve 15 EA 144 SP-111 12" Gate Valve 2 EA 145 SP-112 8" Gate Valve 2 EA 146 SP-113 6" Gate Valve 2 EA 147 SP-113 6" Gate Valve 18 EA	125	SP-92	4" PVC Sewer Service	700	LF	
127 Sp-94 Encasement 150 LF	126	SP-93	4" PVC Sewer Service - Flowable Fill Backfill	10	LF	
129 SP-96 6" Clean-Out with Mini Manhole 18 EA 130 SP-97 4" Clean-Out with Mini Manhole 38 EA 131 SP-98 Disconnect and Reconnect Exist Sewer Service 1 EA 132 SP-99 Replace Exist. 12" VCP Sewer Main with 12" DIP Sewer Main 120 LF 133 SP-100 Replace Exist. 8" VCP Sewer Main with 8" DIP Sewer Main 50 LF 134 SP-101 Concrete Collar 3 EA 135 SP-102 16" Ductile Iron Water Line 1600 LF 136 SP-103 12" Ductile Iron Water Line 30 LF 137 SP-104 8" Ductile Iron Water Line 70 LF 138 SP-105 6" Ductile Iron Water Line 120 LF 139 SP-106 4" Ductile Iron Water Line - Flowable Fill Backfill 50 LF 140 SP-107 16" Ductile Iron Water Line - Flowable Fill Backfill 55 LF 142 SP-109 10" Ductile Iron Water Line - Flowable Fill Backfill 25 LF 143 SP-110 16" Gate Valve <t< td=""><td>127</td><td>SP-94</td><td></td><td>150</td><td>LF</td><td></td></t<>	127	SP-94		150	LF	
130 SP-97 4" Clean-Out with Mini Manhole 38 EA	128	SP-95	8" Clean-Out with Mini Manhole	1	EA	
131 SP-98 Disconnect and Reconnect Exist Sewer Service 1 EA	129	SP-96	6" Clean-Out with Mini Manhole	18	EA	
132 SP-99 Replace Exist. 12" VCP Sewer Main with 12" 120 LF 133 SP-100 Replace Exist. 8" VCP Sewer Main with 8" DIP Sewer Main 50 LF 134 SP-101 Concrete Collar 3 EA 135 SP-102 16" Ductile Iron Water Line 1600 LF 136 SP-103 12" Ductile Iron Water Line 30 LF 137 SP-104 8" Ductile Iron Water Line 70 LF 138 SP-105 6" Ductile Iron Water Line 350 LF 139 SP-106 4" Ductile Iron Water Line 120 LF 140 SP-107 16" Ductile Iron Water Line - Flowable Fill Backfill 50 LF 141 SP-108 12" Ductile Iron Water Line - Flowable Fill Backfill 25 LF 142 SP-109 10" Ductile Iron Water Line - Flowable Fill Backfill 25 LF 143 SP-110 16" Gate Valve 15 EA 144 SP-111 12" Gate Valve 2 EA 145 SP-112 8" Gate Valve 2 EA 146 SP-113 6" Gate Valve 18 EA	130	SP-97	4" Clean-Out with Mini Manhole	38	EA	
132 SP-99 DIP Sewer Main 120 LF 133 SP-100 Replace Exist. 8" VCP Sewer Main with 8" DIP Sewer Main 3 EA 134 SP-101 Concrete Collar 3 EA 135 SP-102 16" Ductile Iron Water Line 1600 LF 16" Ductile Iron Water Line 30 LF 137 SP-104 8" Ductile Iron Water Line 70 LF 138 SP-105 6" Ductile Iron Water Line 350 LF 139 SP-106 4" Ductile Iron Water Line 120 LF 140 SP-107 16" Ductile Iron Water Line - Flowable Fill Backfill 50 LF 12" Ductile Iron Water Line - Flowable Fill Backfill 55 LF 141 SP-108 10" Ductile Iron Water Line - Flowable Fill Backfill 25 LF 143 SP-110 16" Gate Valve 15 EA 144 SP-111 12" Gate Valve 2 EA 145 SP-112 8" Gate Valve 2 EA 146 SP-113 6" Gate Valve 18 EA 18 EA 18 SP-113 6" Gate Valve 18 EA 18 SP-114 18 SP-115 6" Gate Valve 18 EA 18 SP-116 SP-113 6" Gate Valve 18 EA 18 SP-116 SP-117 ST-12 ST-1	131	SP-98	Disconnect and Reconnect Exist Sewer Service	1	EA	
134 SP-101 Concrete Collar 3 EA 135 SP-102 16" Ductile Iron Water Line 1600 LF 136 SP-103 12" Ductile Iron Water Line 30 LF 137 SP-104 8" Ductile Iron Water Line 70 LF 138 SP-105 6" Ductile Iron Water Line 350 LF 139 SP-106 4" Ductile Iron Water Line 120 LF 140 SP-107 SP-107 SP-108 SP-108 SP-108 SP-108 Backfill SP-108 Backfill SP-109 Backfill SP-109 Backfill SP-109 Backfill SP-109 SP-109	132	\P_99	-	120	LF	
135 SP-102 16" Ductile Iron Water Line 1600 LF 136 SP-103 12" Ductile Iron Water Line 30 LF 137 SP-104 8" Ductile Iron Water Line 70 LF 138 SP-105 6" Ductile Iron Water Line 350 LF 139 SP-106 4" Ductile Iron Water Line 120 LF 140 SP-107 Backfill 50 LF 141 SP-108 12" Ductile Iron Water Line - Flowable Fill Backfill 55 LF 142 SP-109 10" Ductile Iron Water Line - Flowable Fill Backfill 25 LF 143 SP-110 16" Gate Valve 15 EA 144 SP-111 12" Gate Valve 2 EA 145 SP-112 8" Gate Valve 2 EA 146 SP-113 6" Gate Valve 18 EA	133	<p-100< td=""><td></td><td>50</td><td>LF</td><td></td></p-100<>		50	LF	
136 SP-103 12" Ductile Iron Water Line 30 LF 137 SP-104 8" Ductile Iron Water Line 70 LF 138 SP-105 6" Ductile Iron Water Line 350 LF 139 SP-106 4" Ductile Iron Water Line 120 LF 140 SP-107 16" Ductile Iron Water Line - Flowable Fill Backfill 50 LF 141 SP-108 12" Ductile Iron Water Line - Flowable Fill Backfill 55 LF 142 SP-109 10" Ductile Iron Water Line - Flowable Fill Backfill 25 LF 143 SP-110 16" Gate Valve 15 EA 144 SP-111 12" Gate Valve 2 EA 145 SP-112 8" Gate Valve 2 EA 146 SP-113 6" Gate Valve 18 EA	134	SP-101	Concrete Collar	3	EA	
137 SP-104 8" Ductile Iron Water Line 70 LF 138 SP-105 6" Ductile Iron Water Line 350 LF 139 SP-106 4" Ductile Iron Water Line 120 LF 140 SP-107 16" Ductile Iron Water Line - Flowable Fill Backfill 50 LF 141 SP-108 12" Ductile Iron Water Line - Flowable Fill Backfill 55 LF 142 SP-109 10" Ductile Iron Water Line - Flowable Fill Backfill 25 LF 143 SP-110 16" Gate Valve 15 EA 144 SP-111 12" Gate Valve 2 EA 145 SP-112 8" Gate Valve 2 EA 146 SP-113 6" Gate Valve 18 EA	135	SP-102	16" Ductile Iron Water Line	1600	LF	
138 SP-105 6" Ductile Iron Water Line 350 LF 139 SP-106 4" Ductile Iron Water Line 120 LF 140 SP-107 16" Ductile Iron Water Line - Flowable Fill Backfill 50 LF 141 SP-108 12" Ductile Iron Water Line - Flowable Fill Backfill 55 LF 142 SP-109 10" Ductile Iron Water Line - Flowable Fill Backfill 25 LF 143 SP-110 16" Gate Valve 15 EA 144 SP-111 12" Gate Valve 2 EA 145 SP-112 8" Gate Valve 2 EA 146 SP-113 6" Gate Valve 18 EA	136	SP-103	12" Ductile Iron Water Line	30	LF	
139 SP-106 4" Ductile Iron Water Line 120 LF 140 SP-107 16" Ductile Iron Water Line - Flowable Fill Backfill 50 LF 141 SP-108 12" Ductile Iron Water Line - Flowable Fill Backfill 55 LF 142 SP-109 10" Ductile Iron Water Line - Flowable Fill Backfill 25 LF 143 SP-110 16" Gate Valve 15 EA 144 SP-111 12" Gate Valve 2 EA 145 SP-112 8" Gate Valve 2 EA 146 SP-113 6" Gate Valve 18 EA	137	SP-104	8" Ductile Iron Water Line	70	LF	
140 SP-107 16" Ductile Iron Water Line - Flowable Fill Backfill 50 LF 141 SP-108 12" Ductile Iron Water Line - Flowable Fill Backfill 55 LF 142 SP-109 10" Ductile Iron Water Line - Flowable Fill Backfill 25 LF 143 SP-110 16" Gate Valve 15 EA 144 SP-111 12" Gate Valve 2 EA 145 SP-112 8" Gate Valve 2 EA 146 SP-113 6" Gate Valve 18 EA	138	SP-105	6" Ductile Iron Water Line	350	LF	
140 SP-107 Backfill 50 LF 141 SP-108 12" Ductile Iron Water Line - Flowable Fill Backfill 55 LF 142 SP-109 10" Ductile Iron Water Line - Flowable Fill Backfill 25 LF 143 SP-110 16" Gate Valve 15 EA 144 SP-111 12" Gate Valve 2 EA 145 SP-112 8" Gate Valve 2 EA 146 SP-113 6" Gate Valve 18 EA	139	SP-106	4" Ductile Iron Water Line	120	LF	
141 SP-108 Backfill 55 LF 142 SP-109 Backfill 10" Ductile Iron Water Line - Flowable Fill Backfill 25 LF 143 SP-110 16" Gate Valve 15 EA 144 SP-111 12" Gate Valve 2 EA 145 SP-112 8" Gate Valve 2 EA 146 SP-113 6" Gate Valve 18 EA	140	SP-107		50	LF	
142 SP-109 Backfill 25 LF 143 SP-110 16" Gate Valve 15 EA 144 SP-111 12" Gate Valve 2 EA 145 SP-112 8" Gate Valve 2 EA 146 SP-113 6" Gate Valve 18 EA	141	SP-108		55	LF	
144 SP-111 12" Gate Valve 2 EA 145 SP-112 8" Gate Valve 2 EA 146 SP-113 6" Gate Valve 18 EA	142	SP-109		25	LF	
145 SP-112 8" Gate Valve 2 EA 146 SP-113 6" Gate Valve 18 EA	143	SP-110	16" Gate Valve	15	EA	
146 SP-113 6" Gate Valve 18 EA	144	SP-111	12" Gate Valve	2	EA	
	145	SP-112	8" Gate Valve	2	EA	
147 SP-114 4" Gato Valvo	146	SP-113	6" Gate Valve	18	EA	
14 SF-114 4 CA	147	SP-114	4" Gate Valve	4	EA	

1/12	ςp_115	12" Gate Valve - Flowable Fill Backfill	2	EA	
-		Fire Hydrant Assembly	7	EA	
	SP-117	Fire Hydrant Assembly with Tapping Sleeve and Valve		EA	
151	SP-118	Compact DI Fittings	25000	LB	
152	SP-119	16" Connection to Existing Water System	3	EA	
153	SP-120	12" Connection to Existing Water System	1	EA	
154	SP-121	10" Connection to Existing Water System	2	EA	
155	SP-122	8" Connection to Existing Water System	3	EA	
156	SP-123	6" Connection to Existing Water System	1	EA	
157	SP-124	4" Meter Vault	2	EA	
158	SP-125	2" Water Service Tap	61	EA	
159	SP-126	3/4" Water Service Tap	1	EA	
-		2" Copper Water Service Line	1500	LF	
-		3/4" Copper Water Service Line	50	LF	
-		2" Water Meter Box	61	EA	
163	SP-130	2" Pressure Reducing Valve in Meter Box	61	EA	
164	SP-131	3/4" Reduced Pressure Backflow Assembly	2	EA	
165	SP-132	Air Release Valve	2	EA	
166	SP-133	Temporary 2" Water Service	35	EA	
167	SP-134	Remove and Abate Exist. 8" AC Water Line	1500	LF	
168	NP-135	Remove and Abate Exist. 8" AC Water Line - Flowable Fill Backfill	50	LF	
169	SP-136	Demo - Concrete Pole Bases / Footings	22	EA	
170	SP-137	Demo - Existing Circuits, Handholes, Electrical Appliances And Concrete Encased Ductbanks	1	LS	
171	SP-138	Light Poles Type A	18	EA	
172	SP-139	Light Poles Type B	2	EA	
173	SP-140	Wiring Devices and Appliances	1	LS	
174	SP-141	Lighted Bollards	8	EA	
175	SP-142	Exothermic Weld	28	EA	
176	SP-143	Intelligent Panel	2	EA	
177	SP-144	Wiring 600V Copper #12	28000	LF	
178	SP-145	Wiring 600V Copper #10	14000	LF	
179	SP-146	Wiring 600V Copper #8	15000	LF	
180		Wiring 600V Copper #6	36000	LF	
181	SP-148	Conduit RGS 1"	300	LF	
182	SP-149	PVC Schedule 40 1" Conduit	28000	LF	

					1	
183	SP-150	PVC Schedule 40 2" Conduit	2000	LF		
184	SP-151	PVC Schedule 40 4" Conduit	9300	LF		
185	SP-152	Electrical Trenching	16000	LF		
186	SP-153	Announcement Kiosk	1	EA		
187	SP-154	Light Pole Bases / Footings	26	EA		
188	SP-155	Ground Rod 10' x 3/4"	34	EA		
189	SP-156	Electrical Hand Holes	18	EA		
190	SP-157	Communication Manholes	6	EA		
191	SP-158	Fiber Cable	2400	LF		
192	SP-159	Service Panel Enclosure and Concrete Pad	1	EA		
193	SP-160	Grounding Electrode Conductors	1	LS		
194	SP-161	Panelboard LP-B2	1	EA		
195	SP-162	Temporary Lighting	1	LS		
194	SP-163	Concrete Duct Bank Encasement	2500	LF		
197	EC	Erosion Control Application Fee/Permit	1	LS		
		CONSTRUCTION SUBTOTAL			\$	-
		CONTINGENCY (10%)			\$	=
		TOTAL BASE BID SITE IMPROVEMENTS			\$	-
196	840	Add Alt #1 Curb Inlet w/ Frame, Grate, and Hood	1	EA		
197	310	Add Alt #1 15" RCP Class IV	50	LF		
198	SP-76	Add Alt #1 Stone Inlet Protection	1	EA		
		Total ADD ALTERNATE #1			\$	-
		TOTAL SITE IMPROVEMENT COST			\$	-

CONSTRUCTION SUBTOTAL	\$
(WORDS)	
10% CONTINGENCY	<u>\$</u>
(WORDS)	
TOTAL BASE BID SITE IMPROVEMENTS	\$
(WORDS)	
TOTAL ADD ALTERNATE #1	<u>\$</u>
(WORDS)	
TOTAL PROJECT COST	<u>\$</u>
(WORDS)	

- 6. Bidder agrees that all work will be completed and ready for final payment in accordance with Paragraph 14.13 of the General Conditions within 540 days from the date of notice to proceed.
- 7. Liquidated damages are \$250.00 per each day past the contract completion date.

8.	Communications concern	ing this Bid shall be sent to Bidder at the follo	wing address:		
	NAME:				
	ADDRESS:				
	D.O. DOW				
	CITY:				
	STATE:				
	7110				
9.	The terms used in this	s BID, which are defined in the General hem in the General Conditions.	Conditions (S	section II),	have the
SIC	GNATURE OF BIDDER:				
		Contractor's License Number			
		License Expiration Date			
<u>If a</u>	n Individual				
	By				
	<u> </u>	(signature of individual)			
	doing business as			<u>—</u>	
	Business address				
	Phone No.				
	Date		, 20		
	ATTEST	TITLE			
<u>If a</u>	Partnership				
	By	(f')			
		(firm name)			
	Business address	(signature of general partner)			
	Phone No.				
	Date		, 20		
	ATTEST	TITLE			

If a Corporation

By(corporation name)	
(signature of authorized person) (title)	
Business address	
Phone No	
Date	, 20
ATTESTTITLE	
Seal)	
nt Venture (Other party must sign below.) By (name)	
Contractor's License Number	
License Expiration Date	
If an Individual	
Ву	
(signature of individual) doing business as	
Business address	
Phone No	
Date	
ATTESTTITLE	
f a Partnership	
By	
(firm name)	
(signature of general partner) Business address	
Phone No.	

By_	
By(corporation name))
By	
(signature of authorized person	n)(title)
Business address	
Phone No.	
Date	
ATTEST TITLE	

EXHIBIT C - PROJECT SPECIAL PROVISIONS

Union Street Improvements Project No. 2020-009 (Mcgill Associates Project #19.01726)

STANDARD PROVISIONS

- 1) Contractor shall utilize the 2018 NCDOT Standard Specifications & Standard Drawings for Roads and Structures, the City of Concord Technical Standards, and Water & Sewer Authority of Cabarrus County Technical specifications, the most restrictive requirement shall apply unless otherwise noted. WSACC items in the Bid Form and these Project Special Provisions reference the Water & Sewer Authority of Cabarrus County Technical specifications. NCDOT Article Numbers in the Bid Form and these Project Special Provisions reference the NCDOT Standard Specifications for Roadways and Structures.
- 2) The Geotechnical Report is available in Appendix A. It should be noted that the data provided does not reflect the variations in subsurface conditions which could exist between test locations and/or unexplored areas of the site.
- 3) This project is subject to an Encroachment Agreement with NCDOT (see Appendix B).
- 4) Hours of work within NCDOT's ROW are 9:00 am 4:00 pm Monday through Friday, or as required by the Encroachment Agreement. Hours of work outside NCDOT's ROW are 7:00 am 7:00 pm Monday through Friday. Contractor to obtain approval from the City for work to be performed outside of the standard hours and must provide a minimum of 48 hours notice.
- 5) Ingress and egress shall be maintained to all business and dwellings affected by the project. Contractor shall notify the adjacent property owners in writing a minimum of 72 hours in advance of construction at the work site. Driveway work shall be coordinated with the city inspector and the property owner(s).
- 6) Maintain water and sewer service to existing customers during construction. Minimize the duration of any service disruption. Notify the City of Concord Construction Manager at least 48 hours in advance of any scheduled service disruption. Provide notice on a City approved form to City of Concord customers specifying the day and duration of any scheduled disruption, including appropriate City contact numbers. Provide temporary potable water supplies to City of Concord customers when the duration of water service disruption exceeds 4 hours. This work is considered incidental to the project. No additional payment will be made
- 7) The Contractor shall include the cost of any coordination and cooperation of utilities in his bid. No additional compensation shall be allowed for delays or inconvenience sustained by the Contractor due to utility relocation or adjustments. No additional payment will be made for re-mobilization required by the utility's failure to relocate a utility at the request of the Contractor.
- 8) Financial Responsibility, Sedimentation Pollution Control Act: If this project is subject to the "NC Department of Environmental Health and Natural Resources Sediment Pollution Control Act", the City has already acquired the Letter of Approval (see Appendix C). The Contractor, upon recommendation of award, shall complete Part B of the Financial Responsibility/Ownership form provided in Appendix D. The City will then transfer financial responsibility of the erosion control permit to the Contractor. The Contractor will be responsible for any fines levied for violation of the approved erosion control plan
- 9) Notice of Intent –The erosion and sedimentation control plan letter of approval in Appendix C requires that a Notice of Intent (NOI) form is submitted prior to the commencement of any land disturbing activity on the project. The Contractor shall complete and submit the NOI.

SPECIAL PROVISIONS

SP-01: VEHICULAR TRAFFIC CONTROL

1.0 DESCRIPTION

<u>Beginning Work and Street Closings:</u> The Contractor is responsible for notifying the Concord Department of Transportation and NCDOT for any work where the number of travel lanes is reduced from normal conditions.

The Contractor shall install advance warning signs for the Project. These signs shall be in place for one week before construction activity begins. The Contractor shall begin construction activity on a street on the scheduled date for the closing of the travel lane.

<u>Traffic Control Plan:</u> Traffic control will be provided by the Contractor to the City for approval prior to start of construction.

All traffic control devices and procedures shall conform to the requirements of the current edition of the Federal Highway Administration (FHWA) *Manual on Uniform Traffic Control Devices* (MUTCD), the current edition of the North Carolina Department of Transportation (NCDOT) Supplement to the *Manual on Uniform Traffic Control Devices for Streets and Highways*, the NCDOT Roadway Standard Drawings and the current edition of the NCDOT Standard Specifications for Roads and Structures.

The Contractor shall maintain the traffic control as described herein.

Traffic Control Phasing shall be in accordance with the construction sequence shown on the plans. Changes to the sequence shall be discussed and agreed upon by the City prior to the Contractor making changes. Additional signs, cones, drums, barricades and warning devices may be used, but at no time will less than what is specified on the plans or in the standards be acceptable.

<u>Maintenance of Traffic:</u> The Contractor shall maintain all travel lanes in accordance with the Traffic Control Plan sheets.

In areas of drop-offs and low shoulders, the Contractor shall backfill up to the edge and elevation of the existing pavement.

The Contractor will be required to maintain ingress and egress to all businesses and dwellings, and easy access to fire hydrants.

The Contractor shall provide adequate drainage under driveways and within the Project area for the duration of the Project.

The Contractor shall mark all hazards within the Project limits with well-maintained signs, barricades, warning and/or channelizing devices.

<u>Traffic Control Devices:</u> The Contractor shall furnish, install, operate, relocate, maintain and remove all temporary traffic control devices necessary for controlling traffic in accordance with the Traffic Control Plans and standards. All construction signs and barricades shall remain in place until the appropriate permanent signs and pavement markings are installed.

<u>Equipment and Material Storage:</u> During periods of construction inactivity, all construction materials and equipment shall be stored by the Contractor. The right-of-way or temporary project easement may be used for this purpose, but equipment and materials must be placed safely 10 or more feet away from any open travel lane. It is recommended that all construction equipment and materials be stored on private property, which is posted against trespassing. It is the responsibility of the organization performing the work to obtain the permission to use a property for this purpose.

<u>Excavation and Trenches:</u> Excavations and trenches that cannot be properly backfilled and patched prior to the end of the workday shall be secured.

2.0 MEASUREMENT

There will be no separate measurement made for Traffic Control.

3.0 PAYMENT

Traffic Control will be paid at the lump sum price for "Traffic Control". This payment will be full compensation for all elements of work required to complete the Project as specified.

Partial payments will be made as follows:

- 25% of the lump sum price on the first partial payment estimate made after any work has been performed on the item of "Traffic Control".
- 25% of the lump sum price on the first partial payment after work is 25% complete.
- 25% of the lump sum price on the first partial payment after work is 50% complete.
- 25% of the lump sum price on the first partial payment after work is 100% complete.

Payment will be made under:

VEHICULAR TRAFFIC CONTROL.....LS

SP-02: PEDESTRIAN ACCESS AND SAFETY

1.0 DESCRIPTION

Work associated with this line item shall include pedestrian access and safety measures during all phases of construction. Work associated with this line item shall include, but not be limited to providing signs, barricades, cones, and temporary construction fencing to secure work areas from the general public as well as construction of temporary access ramps/drives to provide access to stores and businesses.

2.0 MEASUREMENT

There will be no separate measurement made for pedestrian access and safety.

3.0 PAYMENT

Traffic Control will be paid at the lump sum price for "Pedestrian Access and Safety". This payment will be full compensation for all elements of work required to complete the Project as specified.

Partial payments will be made as follows:

Payment will be made under:

- 25% of the lump sum price on the first partial payment after work is 25% complete.
- 25% of the lump sum price on the first partial payment after work is 50% complete.
- 25% of the lump sum price on the first partial payment after work is 75%% complete.
- 25% of the lump sum price on the first partial payment after work is 100% complete.

PEDESTRIAN ACCESS AND SAFETYLS

SP-03: COMPREHENSIVE GRADING

1.0 DESCRIPTION

This item shall include all elements of work covered by the referenced <u>NCDOT Specifications</u> and the numbered <u>Additional City Specifications</u> provided herein.

NCDOT Specifications

- 225, "Roadway Excavation"
- 250, "Removal of Existing Pavement"
- 260, "Proof Rolling"
- 340, "Pipe Removal"
- 412. "Unclassified Structure Excavation"
- 416, "Channel Excavation"
- 500, "Fine Grading, Sub-grade, Shoulders and Ditches"

545, "Incidental Stone Base" 560, "Shoulder Construction" 1530, "Abandon or Remove Utilities"

Additional City Specifications

- 1. <u>Traffic Bearing Road Plates</u>: The Contractor shall be responsible for all traffic bearing road plates needed in accordance with NCDOT Utility Cut Replacement Detail.
- 2. <u>Fence Removal and Disposal and or Fence Relocation</u>: as shown on the plans and any additional removal or relocation identified by the Contractor's means and methods shall be included in this item.
- 3. <u>Mailboxes and Site Amenities:</u> remove, protect, and reset mailboxes and site amenities. The Contractor shall keep mailboxes in service at all times and allow / provide for other services, including but not limited to trash pickup.
- 4. <u>Existing Road Signs:</u> remove, salvage, protect, reset and/or replace road signs as directed on the drawings and in accordance with the City of Concord transportation department and NCDOT Specifications 903 and 904.
- 5. Removal and Disposal of Existing Infrastructure: concrete curb, sidewalk, miscellaneous concrete, asphalt, driveways, pads, slabs, walls, culverts, structures, catch basins, manholes, etc. within the construction limits as shown on the plans and any additional infrastructure removal identified on the plans or by the Contractor's means and methods shall be included in this item.
- 6. <u>Shoring</u>: The Contractor shall be responsible for all shoring to include means, methods, materials and engineering needed to construct the project.
- 7. <u>Saw Cutting</u>: all saw cutting required to build the Project. Where asphalt or concrete (curb, sidewalk, roadway, driveways, parking lots, etc.) is to be removed, the Contractor shall provide a neat edge along the pavement being retained by sawing the pavement a minimum of 2" deep and 1' wide before breaking and removing adjacent pavement. When the Contractor proposes to saw pavement more than one foot from the proposed pavement (curb, sidewalk, structure, etc.), the Contractor shall obtain approval from the City prior to saw cutting and removing pavement. The cost of sawing asphalt or concrete shall be included in this item.
- 8. <u>Tree Protection</u>: The Contractor shall provide tree protection as shown on the plans, including any pruning which shall be performed by a certified arborist in accordance with proper arboricultural standards, and any additional Tree Protection identified by the Contractor's means and methods shall be in accordance with the City of Concord Landscaping Technical Standards and included in this item.
- 9. <u>Tree and/or Stump Removal and Disposal</u>: as shown on the plans and any additional tree and/or stump removal identified by the Contractor's means and methods

shall be included in this item. Trees to be removed shall be approved by the City prior to removal.

- 10. Water Meter / Sewer Clean Out Protection: all labor and materials required to protect, and replace, if necessary, impacted water meters and sewer clean outs in the work area.
- 11. <u>Utility Pipe/Conduit Removal and Disposal</u>: existing public or private utility pipe / conduit, subsurface and shoulder drainpipe removal and disposal as shown on the plans and any additional utility pipe / conduit removal identified by the Contractor's means and methods shall be included in this item. Trench and excavation backfill shall consist of excavatable flowable fill according to NCDOT Specification Section 1000 within NCDOT (Cabarrus Avenue) Right of Way. Utility cut repair shall be performed according to the Utility Cut Replacement Detail for Pavement Surface Milling and Overlay Areas in areas where surface milling and overlay is to occur and areas of complete road reconstruction where utility trenches are excavated and backfilled prior to full pavement removal.
- 12. <u>Utility Pipe/Conduit Abandonment</u>: existing public or private utility pipe/conduit cutting, disconnection, plugging, and filling with excavatable flowable fill according to NCDOT specification Section 1000 as shown on the drawings and identified by the Contractor's means and methods shall be included in this item.
- 13. <u>Property Access</u>: all labor and materials required to maintain access to properties and businesses during construction.
- 14. <u>Miscellaneous items</u>: Items not shown but necessary for construction of the project shall be included in this item.

2.0 MEASUREMENT

There will be no separate measurement made for Comprehensive Grading.

3.0 PAYMENT

This payment will be full compensation for all elements of work required to complete the Project as specified.

Partial payments will be made as follows:

- 25% of the lump sum price on the first partial payment after work is 25% complete.
- 25% of the lump sum price on the first partial payment after work is 50% complete.
- 25% of the lump sum price on the first partial payment after work is 75%% complete.
- 25% of the lump sum price on the first partial payment after work is 100% complete.

Devement will be made under
Payment will be made under:
COMPREHENSIVE GRADINGLS
SP-04: 18" CONCRETE GRADE BEAM
1.0 DESCRIPTION
NCDOT SPECIFICATIONS:
848 "Concrete Sidewalks, Driveways and Curb Ramps"
Additional City Specifications:
1. Minimum Compressive Strength at 28 day – 4,000 psi
Work associated with this line item shall consist of the installation of concrete grade beams in accordance with the plans and specifications. The unit price will be the full compensation for all work including, but not limited to excavation, fine grading, concrete, rebar, installation, curing, and maintenance during the construction period.
2.0 MEASUREMENT
Measurement shall be made along the top surface of the beam.
3.0 PAYMENT
18" CONCRETE GRADE BEAMLF
SP-05: 6" CONCRETE DRIVE APRON/DRIVE/HC RAMPS 1.0 DESCRIPTION

NCDOT SPECIFICATIONS:

848 "Concrete Sidewalks, Driveways and Curb Ramps"

Additional City Specifications:

- 1. Minimum Compressive Strength at 28 day 4,000 psi
- 2. HC ramps vary in size, location, and layout. Ramps will not be a separate pay item but included in the 6" concrete drive measurement as applicable per the site plans. Tactile plates and handrails associated with ramps are a separate pay item.

Work associated with this line item shall consist of the actual number of square yards of concrete drive apron installed in accordance with the plans and specifications. The unit price will be the full compensation for all work including, but not limited to excavation, fine grading, concrete, and reinforcement as required in details, installation, curing, and maintenance during the construction period.

2.0 MEASUREMENT

Measurement shall be made along the top surface.

3.0 PAYMENT

6" CONCRETE DRIVE APRON/DRIVE...... SY

SP-06: 4" CONCRETE SIDEWALK AND HC RAMPS

1.0 DESCRIPTION

NCDOT SPECIFICATIONS:

848 "Concrete Sidewalks, Driveways and Curb Ramps"

Additional City Specifications:

- 1. Minimum Compressive Strength at 28 day 4,000 psi
- 2. HC ramps vary in size and layout. Ramps will not be a separate pay item but included in the sidewalk measurement. Tactile plates and handrails associated with ramps are a separate pay item.

Work associated with this line item shall consist of the installation of 4" concrete sidewalk and handicap ramp construction in accordance with the plans and specifications. The unit price will be the full compensation for all work including, but not limited to excavation, fine grading, concrete, reinforcement as required in details, installation, curing, and maintenance during the construction period.

2.0 MEASUREMENT

Measurement shall be made along the top surface. HC ramps will not be a separate pay item.

3.0 PAYMENT

4" CONCRETE SIDEWALK SY

SP-07: PAVERS-LIGHT DUTY ON 4" CONCRETE BASE

1.0 DESCRIPTION

NCDOT SPECIFICATIONS:

848 "Concrete Sidewalks, Driveways and Curb Ramps"

Additional City Specifications:

1. Minimum Compressive Strength at 28 day – 4,000 psi

Work associated with this line item shall consist of the installation of pavers including a 4" concrete base at locations and patterns shown in accordance with the plans and specifications. The unit price will be the full compensation for all work including, but not limited to excavation, fine grading, concrete, curing, pavers, sand and maintenance during the construction period.

2.0 MEASUREMENT

Measurement shall be made along the top surface.

3.0 PAYMENT

PAVERS - LIGHT DUTY ON 4" CONCRETE BASE SY

SP-08: PAVERS - HEAVY DUTY ON 6" CONCRETE BASE/HC RAMPS

1.0 DESCRIPTION

NCDOT SPECIFICATIONS:

848 "Concrete Sidewalks, Driveways and Curb Ramps"

Additional City Specifications:

- 1. Minimum Compressive Strength at 28 day 4,000 psi
- 2. HC ramps vary in size, location, and layout. Ramps will not be a separate pay item but included with the pavers heavy duty on 6" concrete as applicable per the site plans. Tactile plates and handrails associated with ramps are a separate pay item.

Work associated with this line item shall consist of the installation of pavers including a 6" concrete base at locations, colors and patterns shown in accordance with the plans and specifications. The unit price will be the full compensation for all work including, but not limited to excavation, fine grading, concrete, curing, pavers, sand and maintenance during the construction period.

2.0 MEASUREMENT

Measurement shall be made along the top surface.

3.0 PAYMENT

PAVERS - HEAVY DUTY ON 6" CONCRETE BASE SY

SP-09: BRICK BAND ON 4" CONCRETE BASE

1.0 DESCRIPTION

NCDOT SPECIFICATIONS:

848 "Concrete Sidewalks, Driveways and Curb Ramps"

Additional City Specifications:

1. Minimum Compressive Strength at 28 day – 4,000 psi

Work associated with this line item shall consist of the installation of pavers including a 4" concrete base at locations and patterns shown in accordance with the plans and specifications. The unit price will be the full compensation for all work including, but not limited to excavation, fine grading, concrete, curing, pavers, mortar and maintenance during the construction period.

2.0 MEASUREMENT

Measurement shall be made along the centerline top surface of the band.

3.0 PAYMENT

BRICK BAND ON 4" CONCRETE BASELF

SP-10: PLAZA PAVERS – VEHICULAR

1.0 DESCRIPTION

NCDOT SPECIFICATIONS:

848 "Concrete Sidewalks, Driveways and Curb Ramps"

Additional City Specifications:

1. Minimum Compressive Strength at 28 day – 4,000 psi

Work associated with this line item shall consist of the installation of pavers including a 6" reinforced concrete base at locations, colors and patterns shown in accordance with the

plans and specifications. The unit price will be the full compensation for all work including, but not limited to excavation, fine grading, metal reinforcement, concrete, curing, pavers, mortar, sand and maintenance during the construction period.

2.0 MEASUREMENT

Measurement shall be made along the top surface.

3.0 PAYMENT

PLAZA PAVERS – VEHICULAR......SY

SP-11: BRICK PAVER CROSSWALK

1.0 DESCRIPTION

NCDOT SPECIFICATIONS:

848 "Concrete Sidewalks, Driveways and Curb Ramps"

Additional City Specifications:

1. Minimum Compressive Strength at 28 day – 4,000 psi

Work included in this line item shall consist of construction and installation of all required and necessary individual items to complete each crosswalk at the designated locations. The work at each crosswalk location shall include traffic control, layout, pedestrian crossing signs, excavation, fine grading, concrete, curing, pavers, concrete edge restraint, sand, protection of crosswalks and striping until cured for traffic.

2.0 MEASUREMENT

Measurement shall be made along the top surface.

3.0 PAYMENT

BRICK PAVER CROSSWALKSY

SP-12: STAMPED ASPHALT CROSSWALK

1.0 DESCRIPTION

Work included in these line items of payment shall consist of construction and installation of all required and necessary individual items to complete each crosswalk at the designated locations. The work at each crosswalk location shall include traffic control,

layout (with owner's approval prior to construction), pedestrian crossing signs, pavement repair, imprinting, protection of crosswalks and striping until cured for traffic.

2.0 MEASUREMENT

Measurement shall be made along the top surface.

3.0 PAYMENT

STAMPED ASPHALT CROSSWALKSY

SP-13: 2'-6" CONCRETE CURB AND GUTTER

1.0 DESCRIPTION

NCDOT SPECIFICATIONS:

848 "Concrete Sidewalks, Driveways and Curb Ramps"

Additional City Specifications:

1. Minimum Compressive Strength at 28 day – 4,000 psi

Work associated with this line item shall consist of the installation of 6" concrete curb installed in accordance with the plans and specifications. The unit price will be the full compensation for all work including, but not limited to excavation, fine grading, concrete, installation, curing, and maintenance during the construction period. Measurement shall be made along the top surface of the curb.

2.0 MEASUREMENT

Measurement shall be made along the top surface.

3.0 PAYMENT

2'-6" CONCRETE CURB AND GUTTERLF

SP-14: 6" CONCRETE STAND-UP CURB

1.0 DESCRIPTION

NCDOT SPECIFICATIONS:

848 "Concrete Sidewalks, Driveways and Curb Ramps"

Additional City Specifications:

1. Minimum Compressive Strength at 28 day – 4,000 psi

Work associated with this line item shall consist of the installation of 6" concrete curb installed in accordance with the plans and specifications. The unit price will be the full compensation for all work including, but not limited to excavation, fine grading, concrete, installation, curing, and maintenance during the construction period. Measurement shall be made along the top surface of the curb.

2.0 MEASUREMENT

Measurement shall be made along the top surface.

3.0 PAYMENT

6" CONCRETE STAND-UP CURBLF

SP-15: 8" CONCRETE STAND-UP CURB

1.0 DESCRIPTION

NCDOT SPECIFICATIONS:

846 "Concrete Curb, Curb and Gutter, Concrete Cutter, Shoulder Berm Gutter, Concrete Expressway Gutter and Concrete Valley Gutter"

Additional City Specifications:

1. Minimum Compressive Strength at 28 day – 4,000 psi

Work associated with this line item shall consist of the installation of 8" concrete curb installed in accordance with the plans and specifications. The unit price will be the full compensation for all work including, but not limited to excavation, fine grading, concrete, installation, curing, and maintenance during the construction period. Measurement shall be made along the top surface of the curb.

2.0 MEASUREMENT

Measurement shall be made along the top surface.

3.0 PAYMENT

8" CONCRETE STAND-UP CURBLF

SP-16: CONCRETE LANDSCAPE EDGING

1.0 DESCRIPTION

NCDOT SPECIFICATIONS:

846 "Concrete Curb, Curb and Gutter, Concrete Cutter, Shoulder Berm Gutter, Concrete Expressway Gutter and Concrete Valley Gutter"

Additional City Specifications:

1. Minimum Compressive Strength at 28 day – 4,000 psi

Work associated with this line item shall consist of the installation of concrete landscape edge installed in accordance with the plans and specifications. The unit price will be the full compensation for all work including, but not limited to excavation, fine grading, concrete, installation, curing, and maintenance during the construction period. Measurement shall be made along the top surface of the curb.

2.0 MEASUREMENT

Measurement shall be made along the top surface.

3.0 PAYMENT

CONCRETE LANDSCAPE EDGINGLF

SP-17 & 18: CONCRETE EDGE RESTRAINT

1.0 DESCRIPTION

NCDOT SPECIFICATIONS:

846 "Concrete Curb, Curb and Gutter, Concrete Cutter, Shoulder Berm Gutter, Concrete Expressway Gutter and Concrete Valley Gutter"

Additional City Specifications:

1. Minimum Compressive Strength at 28 day – 4,000 psi

Work associated with these line items shall consist of the installation of concrete edge restraint in accordance with the plans and specifications. The unit price will be the full compensation for all work including, but not limited to excavation, fine grading, concrete, installation, curing, and maintenance during the construction period. Measurement shall be made along the top surface of the edge restraint.

2.0 MEASUREMENT

Measurement shall be made along the top surface.

3.0 PAYMENT

CONCRETE EDGE RESTRAINTLF

SP-19: GRANITE EDGE RESTRAINT

1.0 DESCRIPTION

Work associated with these line items shall consist of the installation of granite edge restraint in accordance with the plans and specifications. The unit price will be the full compensation for all work including, but not limited to excavation, fine grading, mortar, installation, curing, and maintenance during the construction period. Measurement shall be made along the top surface of the edge restraint.

2.0 MEASUREMENT

Measurement shall be made along the top surface.

3.0 PAYMENT

GRANITE EDGE RESTRAINTLF

SP-20: BRONZE SIDEWALK TRAIL MARKERS

1.0 DESCRIPTION

Work associated with this line item shall consist of the furnishing and installation of bronze sidewalk trail markers at locations shows on the plans.

2.0 MEASUREMENT

Measurement shall be made along the top surface.

3.0 PAYMENT

BRONZE SIDEWALK TRAIL MARKERSLS

SP-21: DETECTABLE WARNING PLATE

1.0 DESCRIPTION

Work associated with this line item shall consist of the installation of composite detectable warning plates in accordance with the plans and specifications.

2.0 MEASUREMENT

Measurement shall be made along the top surface.

3.0 PAYMENT

DETECTABLE WARNING PLATESF

SP-22: METAL HANDRAIL AT HC RAMPS

1.0 DESCRIPTION

Work associated with this line item shall consist of the furnishing and installation of the metal railing, posts, anchors, etc. as shown on the project plans. The price shall include rail, post, concrete, grout, hardware, and all related items.

2.0 MEASUREMENT

Measurement shall be made along the top surface.

3.0 PAYMENT

METAL HANDRAIL AT HC RAMPSLF

SP-23: SIGN INSTALLATION

1.0 DESCRIPTION

Work associated with this line item shall consist of the installation of furnishing and installation of decorative break away street signposts to match existing and installation of street signs provided by the City in accordance with the plans and specifications at locations shown on the plans. signs are to be reinstalled and shall conform to MUTCD and NCDOT requirements.

2.0 MEASUREMENT

Measurement shall be made based of the actual number of signs installed and accepted.

3.0 PAYMENT

SIGN INSTALLATION EA

SP-24: SALVAGED WAYFINDING SIGN INSTALLATION

1.0 DESCRIPTION

Work associated with this line item shall consist of the installation of the salvaged wayfinding signs and furnishing and installation of decorative break away pole systems to match existing. Contractor to provide signed and sealed structural drawings for footing design. Salvaged signs are to be reinstalled and shall conform to MUTCD and NCDOT requirements.

2.0 MEASUREMENT

Measurement shall be made based on the actual number of wayfinding signs installed and accepted.

3.0 PAYMENT

SALVAGED WAYFINDING SIGN INSTALLATION..... EA

SP-25: BENCHES (OWNER PROVIDED, CONTRACTOR INSTALLED)

1.0 DESCRIPTION

This item of work includes the installation of benches at locations as shown on the project plans and in conformance with the details and specifications. Owner to provide benches and contractor to install.

2.0 MEASUREMENT

Measurement shall be made based of the actual number of benches installed and accepted.

3.0 PAYMENT

BENCHES EA

SP-26: TRASH/RECYCLING RECEPTACLE (OWNER PROVIDED, CONTRACTOR INSTALLED)

1.0 DESCRIPTION

This item of work includes the installation of trash/recycling receptacles and foundations at locations as shown on the project plans and in conformance with the details and specifications. The price shall include foundation and all related items as needed for installation. Owner to provide trash/recycling receptacles and contractor to install.

2.0 MEASUREMENT

Measurement shall be made based of the actual number of receptacles installed and accepted.

3.0 PAYMENT

TRASH/RECYCLING RECEPTACLE EA

SP-27: CIGARETTE RECEPTACLE (OWNER PROVIDED, CONTRACTOR INSTALLED)

1.0 DESCRIPTION

This item of work includes the installation of cigarette receptacles at locations as shown on the project plans and in conformance with the details and specifications. The price shall include all related items as needed for installation. Owner to provide benches and contractor to install.

2.0 MEASUREMENT

Measurement shall be made based of the actual number of receptacles installed and accepted.

3.0 PAYMENT

CIGARETTE RECEPTACLE...... EA

SP-28: BIKE RACK INSTALLATION

1.0 DESCRIPTION

This item of work includes the installation of salvaged bike racks and proposed concrete foundations as shown on the project plans and in conformance with the details and specifications. The price shall include the foundation, finishes, and all related items as needed for installation.

2.0 MEASUREMENT

Measurement shall be made based of the actual number of bike racks installed and accepted.

3.0 PAYMENT

BIKE RACK INSTALLATION EA

SP-29: DRINKING FOUNTAIN

1.0 DESCRIPTION

This item of work includes the installation of potable drinking fountain as shown on the project plans and in conformance with the details and specifications. The price shall include the foundation, fountain, and all related items as needed for installation.

2.0 MEASUREMENT

Measurement shall be made based of the actual number of drinking fountains installed and accepted.

3.0 PAYMENT

DRINKING FOUNTAIN EA

SP-30: BOLLARDS (NON-LIGHTED)

This item of work includes the furnishing and installation of bollards at locations as shown on the project plans and in conformance with the details and specifications. The price shall include all related items as needed for installation.

2.0 MEASUREMENT

Measurement shall be made based on the <u>actual number</u> of bollards installed and accepted.

3.0 PAYMENT

BOLLARDS (NON-LIGHTED) EA

SP-31: FLAG HOLDER

1.0 DESCRIPTION

This item of work includes the furnishing and installation of Sch 40 PVC flag holders at locations as shown on the project plans and in conformance with the details and specifications. The price shall include all related items as needed for installation.

2.0 MEASUREMENT

There will be no separate measurement made for Flag Holder Installation.

3.0 PAYMENT

FLAG HOLDER.....LS

SP-32: HORSE HOOKS ART INSTALLATION

1.0 DESCRIPTION

Work associated with this line item shall consist of the installation of the salvaged existing horse hooks, furnishing and installation of bronze horseshoes, and granite plaque as noted on the plans and specifications.

2.0 MEASUREMENT

There will be no separate measurement made for Horse Hooks Art Installation.

3.0 PAYMENT

HORSE HOOKS ART INSTALLATION.....LS

SP-33: GRANITE MARKER FOR SURVEYOR STONE

1.0 DESCRIPTION

Work associated with this line item shall consist of the furnishing and installation of a granite marker for the existing corner stone as shown on the plans.

2.0 MEASUREMENT

There will be no separate measurement made for granite marker surveyor stone.

3.0 PAYMENT

GRANITE MARKER FOR SURVEYOR STONELS

SP-34: METAL AIR VENT REPLACEMENT

1.0 DESCRIPTION

Work associated with this line item shall consist of the furnishing and installation of metal air vent grates to match existing vents.

2.0 MEASUREMENT

There will be no separate measurement made for Metal Air Vent Replacement.

3.0 PAYMENT

METAL AIR VENT REPLACEMENTLS

SP-35: MONOLITHIC RETAINING WALL

1.0 DESCRIPTION

Work associated with this line item shall include the construction of all monolithic retaining walls in accordance with the plans and specifications. The unit price shall be full compensation for all materials and installation including but not limited to concrete, footing, rebar, gravel, landscape edge where noted, and restoration of any surfaces. Measurement shall be made along the top surface of the wall and include a width of 14", height of wall varies. Areas of concrete/pavers installed past the 14" width shall be measure as 4" sidewalk or brick pavers as noted.

2.0 MEASUREMENT

Measurement shall be made at the unit bid price per <u>linear foot</u> (12" length x 14" width, height varies) of work installed and accepted.

3.0 PAYMENT

MONOLITHIC RETAINING WALLLF

SP-36: STONE SEAT WALL

1.0 DESCRIPTION

Work associated with this line item shall include the construction of all seat walls in accordance with the plans and specifications. The unit price shall be full compensation for all materials and installation including but not limited to concrete block, footing, rebar, grout, mortar, veneer, pre-cast concrete wall cap, drainage materials, and restoration of any surfaces.

2.0 MEASUREMENT

There will be no separate measurement made for Stone Seat Wall.

3.0 PAYMENT

STONE SEAT WALL.....LS

SP-37: CONCRETE STAIR WITH HANDRAILS

1.0 DESCRIPTION

Work associated with this line item shall include the construction of all stairs with handrails in accordance with the plans and specifications. The unit price shall be full compensation for all materials and installation including but not limited to concrete, footing, rebar, restoration of any surfaces, rail, post, hardware, and all related items.

2.0 MEASUREMENT

There will be no separate measurement made for Concrete Stair with Handrails.

3.	Λ	D.	Δ٧	M	FI	UΤ
J.	·U		н і	IVI		4 I

CONCRETE STAIR WITH HANDRAILSLS

SP-38: CONCRETE STAIR AND HC RAMP WITH HANDRAILS

1.0 DESCRIPTION

Work associated with this line item shall include the construction of the combined stair and ramp with handrails in accordance with the plans and specifications. The unit price shall be full compensation for all materials and installation including but not limited to brick, concrete, footing, rebar, restoration of any surfaces, rail, post, hardware, and all related items.

2.0 MEASUREMENT

There will be no separate measurement made for Concrete Stair and HC Ramp with Handrails.

3.0 PAYMENT

CONCRETE STAIR AND HC RAMP WITH HANDRAILSLS

SP-39: WOOD FENCE REPLACEMENT WITH GATE

1.0 DESCRIPTION

Work associated with this line item shall consist of the furnishing and installation of the wood fence, posts, anchors, etc. as shown on the project plans. The price shall include wood fencing, access gate, posts, concrete, hardware, and all related items.

2.0 MEASUREMENT

There will be no separate measurement made for Wood Fence Replacement with Gate.

3.0 PAYMENT

WOOD FENCE REPLACEMENT WITH GATELS

SP-40: ORNAMENTAL RAILING INSTALLATION

1.0 DESCRIPTION

Work associated with this line item shall consist of the installation of ornamental railing installation as shown on the plans. Railing to be provided by the City.

2.0 MEASUREMENT

Measurement shall be made along the top surface.

3.0 PAYMENT

ORNAMENTAL RAILING INSTALLATIONLF

SP-41: 4'x4' TREE GRATE

1.0 DESCRIPTION

This item of work includes the furnishing and installation of tree grates at locations as shown on the project plans and in conformance with the details and specifications. The price shall include grate, finish, foundation and all related items.

2.0 MEASUREMENT

Measurement shall be made based of the <u>actual number</u> of tree grates installed and accepted.

3.0 PAYMENT

4'X4' TREE GRATE...... EA

SP-42: PLANTING CELLS

1.0 DESCRIPTION

Work associated with this line item shall consist of the furnishing and installation of planting cells in their entirety as shown on the plans and specifications. Work shall include, but not be limited to, the furnishing, installation and maintenance of devices during the project construction.

2.0 MEASUREMENT

There will be no separate measurement made for planting cells.

3.0 PAYMENT

PL	ANTING	CELLS	 L	S
ᆫ	ANTING	CELLO	 ᆫ	٦

SP-43 THRU 49: TREES

1.0 DESCRIPTION

Work associated with this line item shall consist of furnishing, installation and planting of trees in accordance with the plans and specifications. The work at each tree shall include layout, excavation, planting, staking, soil amendments, mulch, and all related construction.

2.0 MEASUREMENT

Measurement shall be made based of the <u>actual number</u> of trees installed and accepted.

3.0 PAYMENT

TREES EA

SP-50 THRU 64: SHRUBS AND PERENNIALS

1.0 DESCRIPTION

Work associated with this line item shall consist of furnishing, installation and planting of shrubs and perennials in accordance with the plans and specifications. The work at each plant shall include layout, excavation, planting, soil amendments, mulch, and all related construction.

2.0 MEASUREMENT

Measurement shall be made based of the <u>actual number</u> of shrubs and perennials installed and accepted.

3.0 PAYMENT

SHRUBS AND PERENNIALS..... EA

SP-65 THRU 69: GROUNDCOVERS

1.0 DESCRIPTION

Work associated with this line item shall consist of furnishing, installation, and planting of groundcovers in accordance with the plans and specifications. The work associated

with groundcover installation shall include layout, excavation, planting, soi amendments, mulch, and all related construction.

2.0 MEASUREMENT

Measurement shall be made based of the <u>actual number</u> of groundcovers installed and accepted.

3.0 PAYMENT

GROUNDCOVERS EA

SP-70: ANNUALS

1.0 DESCRIPTION

Work associated with this line item shall consist of furnishing, installation and planting of annuals in accordance with the plans and specifications. The work associated with annual installation shall include layout, planting, soil amendments, mulch, and all related construction.

2.0 MEASUREMENT

Measurement shall be made based of the square foot of annuals installed and accepted.

3.0 PAYMENT

ANNUALS SF

SP-71: IRRIGATION

1.0 DESCRIPTION

Work associated with this line item shall consist of furnishing and installing irrigation per the plans and specifications. The price will be full compensation for all labor, equipment, and materials necessary for work associated with irrigation, including but not limited to connection to water line, main line, irrigation lines to all valves, controllers, electrical connection, drip pipe, and all related items as needed for installation.

2.0 MEASUREMENT

There will be no separate measurement made for irrigation.

3.0 PAYMENT

IRRIGATIONLS
SP-72: GRANITE STORMWATER FLUME INSTALLATION
1.0 DESCRIPTION
The work covered by this section consists of the installation of granite stormwater flumes, in accordance with the requirements shown on the plans and specifications. Granite used to be salvaged from the removal of existing curb lines with additional granite being provided by the City. The lump sum price will be the full compensation for all work including, but not limited to excavation, fine grading, mortar, concrete, installation, curing, removal of any sharp edges, and maintenance during the construction period. This includes all special cuts as required for installation.
2.0 MEASUREMENT
There will be no separate measurement made for granite stormwater flume installation.
3.0 PAYMENT
GRANITE STORMWATER FLUME INSTALLATIONLS
SP-73: STRAW WATTLE PROTECTION
1.0 DESCRIPTION
Work associated with this line item shall consist of the furnishing and installation of straw wattles around the perimeter of the work area. Locations will vary based on active work areas. Lump sum price shall include but is not limited to materials, installation, maintenance, replacement, and removal.
2.0 MEASUREMENT
There will be no separate measurement made for straw wattle installation and maintenance.
3.0 PAYMENT
STRAW WATTLE PROTECTIONLS

1.0 DESCRIPTION

SP-74: MUD MAT CONSTRUCTION ENTRANCE

Work associated with this line item shall consist of the furnishing and installation of temporary construction entrance mud mat. Location will vary based on active work areas. Lump sum price shall include but is not limited to furnishing, installation, relocation as needed, replacement as needed, and removal.

2.0 MEASUREMENT

There will be no separate measurement made for mud mat installation and maintenance.

3.0 PAYMENT

MUD MAT CONSTRUCTION ENTRANCELS

SP-75: SILT SAK

1.0 DESCRIPTION

Work associated with this line item shall consist of the furnishing, installation and maintenance of silt saks storm inlets protection devices for proposed and existing structures as noted on the plans or as needed due to phasing of construction. The lump sum price shall include furnishing, installation, replacement, and maintenance of device while in active use and all associated items.

2.0 MEASUREMENT

There will be no separate measurement made for silt sak installation and maintenance.

3.0 PAYMENT

SILT SAK...... LS

SP-76: STONE INLET PROTECTION – STORM INLETS

1.0 DESCRIPTION

Work associated with this line item shall consist of the furnishing and installation of gravel storm inlet protection for proposed and existing structures in accordance with the plans and specifications. Unit bid price shall include but is not limited to excavation, installation, maintenance, gravel and all associated items.

2.0 MEASUREMENT

Measurement shall be made based on the <u>actual number</u> of storm inlets installed and accepted.

3.0 PAYMENT

STONE INLET PROTECTION - STORM INLETS..... EA

SP-77: 6" NYLOPLAST STORM DRAINS

1.0 DESCRIPTION

Work associated with this line item shall consist of the installation of Nyloplast drains associated with roof drain piping. Work includes furnishing all materials necessary for the installation in accordance with the plans and specifications. Unit bid price shall include but is not limited to excavation, installation, storm structures, and backfill.

2.0 MEASUREMENT

Measurement shall be made based on the actual number of drains installed and accepted.

3.0 PAYMENT

6" NYOPLAST STORM DRAINS EA

SP-78: 10" NYLOPLAST STORM DRAINS

1.0 DESCRIPTION

Work associated with this line item shall consist of the installation of Nyloplast drains associated with roof drain piping. Work includes furnishing all materials necessary for the installation in accordance with the plans and specifications. Unit bid price shall include but is not limited to excavation, installation, storm structures, and backfill.

2.0 MEASUREMENT

Measurement shall be made based on the actual number of drains installed and accepted.

3.0 PAYMENT

10" NYOPLAST STORM DRAINS EA

SP-79 THRU 82: PVC CLEANOUTS

1.0 DESCRIPTION

Work associated with this line item shall consist of the furnishing and installation of cleanouts in accordance with the plans and specifications, in sizes as shown on plans.

The unit price bid shall include all excavation, installation, temporary and permanent connections to existing lines, backfill including washed stone around the pipe, compaction, testing, cleanup and removal and disposal of existing materials.

2.0 MEASUREMENT

Measurement shall be made based on the <u>actual number</u> of cleanouts installed and accepted.

3.0 PAYMENT

PVC CLEANOUTS.....EA

SP-83 THRU 86: SCH 40 PVC PIPE

1.0 DESCRIPTION

Work associated with this line item shall consist of the furnishing and installation of Schedule 40 PVC pipe in accordance with the plans and specifications, in sizes as specified on plans. The unit price bid shall include but is not limited to all excavation, pipe installation, temporary and permanent connections to existing lines, backfill including washed stone around the pipe, compaction, testing, cleanup and removal and disposal of existing materials.

2.0 MEASUREMENT

Measurement will be per linear foot from the starting point to the finish point of each section of line along the top of the pipe.

3.0 PAYMENT

SCHEDULE 40 PVC PIPE......LF

SP-87: 5' DIA. CONCRETE DOGHOUSE SEWER MANHOLE – FLOWABLE FILL BACKFILL

1.0 DESCRIPTION

Work associated with this line item shall consist of the complete installation of doghouse sewer manholes according to Water and Sewer Authority of Cabarrus County Standard Specifications dated August 2006 including but not limited to pavement cutting and removal, excavation, sheeting/shoring/bracing, excavation dewatering, foundation preparation, locating existing sewer line, installation, cutting of existing sewer line, flowable fill backfill, concrete, pipe connections (including drop connections and existing pipe connections where applicable), boots, construction of invert, installation of frame and lid (watertight or standard), adjustment rings, backfill, bypass pumping as required,

testing, and all related construction to complete the work as specified. Paving is to be performed simultaneously with street paving and is not included under this bid item.

Additional City Specifications:

1. Backfill shall consist of excavatable flowable fill according to NCDOT Specification Section 1000.

2.0 MEASUREMENT

Measurement shall be made based on the <u>actual number</u> of Doghouse Manholes installed and accepted. Quantities shall be verified in the field by the Owner or the Engineer.

3.0 PAYMENT

5' DIA. CONCRETE DOGHOUSE SEWER MANHOLE - FLOWABLE FILL BACKFILL...... EA

SP-88: 8" DUCTILE IRON GRAVITY SEWER

1.0 DESCRIPTION

Work associated with this line item shall consist of the furnishing and installation of ductile iron slip joint pipe according to Water and Sewer Authority of Cabarrus County Standard Specifications dated August 2006. The unit price bid shall include but is not limited to location of existing utilities, pavement cutting and removal, excavation, excavation dewatering, bypass pumping as required, pipe bedding stone, pipe installation, service wyes, testing, temporary and permanent connections to existing lines, standard compacted backfill, testing, cleanup, removal and disposal of existing materials, and all related construction to complete the work as specified. Paving is to be performed simultaneously with street paving and is not included under this bid item.

2.0 MEASUREMENT

Measurement shall be made according to Water and Sewer Authority of Cabarrus County Standard Specifications dated August 2006 with no depth classification. Quantities shall be verified in the field by the Owner or the Engineer.

3.0 PAYMENT

8" DUCTILE IRON GRAVITY SEWER......LF

SP-89: 8" DUCTILE IRON GRAVITY SEWER – FLOWABLE FILL BACKFILL

1.0 DESCRIPTION

Work associated with this line item shall consist of the furnishing and installation of ductile iron slip joint pipe according to Water and Sewer Authority of Cabarrus County Standard Specifications dated August 2006. The unit price bid shall include but is not limited to location of existing utilities, pavement cutting and removal, excavation, excavation dewatering, bypass pumping as required, pipe bedding stone, pipe installation, service wyes, testing, temporary and permanent connections to existing lines, backfill, testing, cleanup, removal and disposal of existing materials, and all related construction to complete the work as specified. Paving is to be performed simultaneously with street paving and is not included under this bid item.

Additional City Specifications:

1. Backfill shall consist of excavatable flowable fill according to NCDOT Specification Section 1000.

2.0 MEASUREMENT

Measurement shall be made according to Water and Sewer Authority of Cabarrus County Standard Specifications dated August 2006 with no depth classification. Quantities shall be verified in the field by the Owner or the Engineer.

3.0 PAYMENT

8" DUCTILE IRON GRAVITY SEWER - FLOWABLE FILL BACKFILL......LF

SP-90 THRU 92: PVC SEWER SERVICE

1.0 DESCRIPTION

Work associated with this line item shall consist of the furnishing and installation of C-900 DR-14 PVC slip joint sewer service pipe according to Water and Sewer Authority of Cabarrus County Standard Specifications dated August 2006. The unit price bid shall include but is not limited to location of existing utilities, excavation, excavation dewatering, removal of existing sewer service line for replacement as shown on drawings, bypass pumping as required, pipe bedding stone, pipe installation, fittings, testing, temporary and permanent connections to existing lines, backfill, testing, cleanup, removal and disposal of existing materials, and all related construction to complete the work as specified. Paving is to be performed simultaneously with street paving and is not included under this bid item.

2.0 MEASUREMENT

Measurement will be per <u>linear foot</u> from the starting point to the finish point of each section of line along the top of the pipe. Quantities shall be verified in the field by the Owner or the Engineer.

3.0 PAYMENT

" PVC SEWER SERVICE.....LF

SP-93: PVC SEWER SERVICE - FLOWABLE FILL BACKFILL

1.0 DESCRIPTION

Work associated with this line item shall consist of the furnishing and installation of C-900 DR-14 PVC slip joint sewer service pipe according to Water and Sewer Authority of Cabarrus County Standard Specifications dated August 2006. The unit price bid shall include but is not limited to location of existing utilities, excavation, excavation dewatering, removal of existing sewer service line for replacement as shown on drawings, bypass pumping as required, pipe bedding stone, pipe installation, fittings, testing, temporary and permanent connections to existing lines, backfill, testing, cleanup, removal and disposal of existing materials, and all related construction to complete the work as specified. Paving is to be performed simultaneously with street paving and is not included under this bid item.

Additional City Specifications:

1. Backfill shall consist of excavatable flowable fill according to NCDOT Specification Section 1000.

2.0 MEASUREMENT

Measurement will be per linear foot from the starting point to the finish point of each section of line along the top of the pipe. Quantities shall be verified in the field by the Owner or the Engineer.

3.0 PAYMENT

" PVC SEWER SERVICE – FLOWABLE FILL BACKFILL.....LF

SP-94: PVC SEWER SERVICE-CLASS A ARCH ENCASEMENT

1.0 DESCRIPTION

Work associated with this line item shall consist of the furnishing and installation of C-900 DR-14 PVC slip joint sewer service pipe according to Water and Sewer Authority of Cabarrus County Standard Specifications dated August 2006. The unit price bid shall include but is not limited to location of existing utilities, excavation, excavation dewatering, removal of existing sewer service line for replacement as shown on drawings, bypass pumping as required, removal of existing sewer service line as shown on drawings, pipe bedding stone, pipe installation, fittings, excavatable concrete arch

encasement according to NCDOT Specification Section 1000, testing, temporary and permanent connections to existing lines, standard compacted backfill, testing, cleanup, removal and disposal of existing materials, and all related construction to complete the work as specified. Paving is to be performed simultaneously with street paving and is not included under this bid item.

2.0 MEASUREMENT

Measurement will be per linear foot from the starting point to the finish point of each section of line along the top of the pipe. Quantities shall be verified in the field by the Owner or the Engineer.

3.0 PAYMENT

____" PVC SEWER SERVICE - CLASS A ARCH ENCASEMENT.....LF

SP-95 THRU 97: SEWER CLEAN-OUT WITH MINI MANHOLE

1.0 DESCRIPTION

Work associated with this line item shall consist of the furnishing and installation of sewer cleanouts according to Water and Sewer Authority of Cabarrus County Standard Specifications dated August 2006, in sizes as shown on plans. The unit price bid shall include but is not limited to location of existing utilities, excavation, excavation dewatering, bypass pumping as required, pipe bedding stone, installation, temporary and permanent connections to existing lines, standard compacted backfill, mini manhole frame and lid, testing, final adjustment, cleanup, removal and disposal of existing materials, and all related construction to complete the work as specified. Paving is to be performed simultaneously with street paving and is not included under this bid item.

2.0 MEASUREMENT

Measurement will be based on the actual number of cleanouts with mini-manhole installed and accepted. Quantities shall be verified in the field by the Owner or the Engineer.

3.0 PAYMENT

____ " SEWER CLEAN-OUT WITH MINI MANHOLE.....EA

SP-98: DISCONNECT AND RECONNECT EXIST. SEWER SERVICE

1.0 DESCRIPTION

Work associated with this line item shall consist of disconnecting existing sewer service from existing sewer main to be abandoned and re-connecting to sewer line to remain along Cabarrus Avenue according to Water and Sewer Authority of Cabarrus County Standard Specifications dated August 2006. The unit price bid shall include but is not limited to location of existing utilities, excavation, disconnection of existing sewer service, plugging abandoned end of sewer service with flowable fill plug, tapping saddle, reconnection of sewer service to live sewer main, flowable fill backfill, cleanup, and all related construction to complete the work as specified. Related pavement patching and restoration of areas outside of the Union Street/Cabarrus Avenue intersection that are otherwise not being reconstructed shall be included under this item.

Additional City Specifications:

1. Backfill shall consist of excavatable flowable fill according to NCDOT Specification Section 1000.

2.0 MEASUREMENT

Measurement shall be made at the unit bid price per each existing sewer service disconnected and reconnected. Quantities shall be verified in the field by the Owner or the Engineer.

3.0 PAYMENT

DISCONNECT AND RECONNECT EXIST. SEWER SERVICE.....EA

SP-99 THRU 100: REPLACE EXISTING VCP SEWER MAIN WITH DIP SEWER MAIN

1.0 DESCRIPTION

Work associated with this line item shall consist of replacement of VCP sewer main with ductile iron slip joint pipe according to Water and Sewer Authority of Cabarrus County Standard Specifications dated August 2006, in sizes as specified on plans. Ductile iron slip joint pipe shall be of the same nominal size as the existing VCP sewer and be installed along the same alignment and grade. Measurement will be from the starting point to the finish point of each section of line. The unit price bid shall include but is not limited to location of existing utilities, pavement cutting and removal, excavation, excavation dewatering, bypass pumping as required, removal of existing sewer, pipe bedding stone, pipe installation, transition couplings, testing, temporary and permanent connections to existing lines, standard compacted backfill, testing, cleanup, removal and disposal of existing materials, and all related construction to complete the work as specified. Paving is to be performed simultaneously with street paving and is not included under this bid item.

2.0 MEASUREMENT

Measurement will be per linear foot from the starting point to the finish point of each section of line along the top of the pipe. Quantities shall be verified in the field by the Owner or the Engineer.

3.0 PAYMENT

REPLACE EXIST. ____" VCP SEWER MAIN WITH ___" DIP SEWER MAIN......LF

SP-101: CONCRETE COLLAR

1.0 DESCRIPTION

Work associated with this line item shall consist of construction of concrete collars where new sewer lines connect to existing brick manholes as shown on the drawings and according to the specifications. The unit price bid shall include connection of the sewer pipe to the existing manhole and installation of the concrete collar.

Additional City Specifications:

1. Concrete shall consist of excavatable flowable fill according to NCDOT Specification Section 1000.

2.0 MEASUREMENT

Measurement shall be made at the unit bid price per <u>each</u> concrete collar installed and accepted. Quantities shall be verified in the field by the Owner or the Engineer.

3.0 PAYMENT

CONCRETE COLLAR.....EA

SP-102 THRU 106: DUCTILE IRON WATER LINE

1.0 DESCRIPTION

Work associated with this line item shall consist of ductile iron water line according to Water and Sewer Authority of Cabarrus County Standard Specifications dated August 2006, in sizes as specified on plans. Price and payment shall constitute full compensation for furnishing all equipment, tools, labor and materials to complete the work as specified, including but not limited to the following items:

- a. Site Preparation
- b. Location of Existing Utilities
- c. Common Excavation, and Trench Backfilling with Standard Compacted Backfill
- d. Dewatering of Excavated Areas
- e. Rock Excavation, unless otherwise noted
- f. Waste Material Disposal

- g. Restraining gaskets or glands (as applicable)
- h. Pipe wrap
- i. Pipe Installation, disinfection, and Applicable Testing
- j. Trench cap surface restoration
- k. Installation of temporary fencing as needed, along with repair and/or replacement of fencing.

2.0 MEASUREMENT

Measurement of waterline shall be the actual number of linear feet of pipe water line installed by pipe joint type, and wrap type (if shown), which has been properly incorporated into the completed and accepted work. Quantities of pipe shall be verified in the field by the Owner or the Engineer. Pipe length shall be measured by horizontal linear feet in place measured along the pipe center line with no deduction for fittings, valves, etc. Separate measurement items shall be made for each different size pipe.

3.0 PAYMENT

____" DUCTILE IRON WATER LINE.....LF

<u>SP-107 THRU 109: DUCTILE IRON WATER LINE – FLOWABLE FILL BACKFILL</u>

1.0 DESCRIPTION

Work associated with this line item shall consist of ductile iron water line according to Water and Sewer Authority of Cabarrus County Standard Specifications dated August 2006, in sizes as specified on plans. Price and payment shall constitute full compensation for furnishing all equipment, tools, labor and materials to complete the work as specified, including but not limited to the following items:

- a. Site Preparation
- b. Location of Existing Utilities
- c. Common Excavation, and Trench Backfilling with Backfill
- d. Dewatering of Excavated Areas
- e. Rock Excavation, unless otherwise noted
- f. Waste Material Disposal
- g. Restraining gaskets or glands (as applicable)
- h. Pipe wrap
- i. Pipe Installation, disinfection, and Applicable Testing
- j. Trench cap surface restoration
- k. Installation of temporary fencing as needed, along with repair and/or replacement of fencing.

Additional City Specifications:

1. Backfill shall consist of excavatable flowable fill according to NCDOT Specification Section 1000.

2.0 MEASUREMENT

Measurement of waterline shall be the actual number of linear feet of pipe water line installed by pipe joint type, and wrap type (if shown), which has been properly incorporated into the completed and accepted work. Quantities of pipe shall be verified in the field by the Owner or the Engineer. Pipe length shall be measured by horizontal linear feet in place measured along the pipe center line with no deduction for fittings, valves, etc. Separate measurement items shall be made for each different size pipe.

3.0 PAYMENT

____" DUCTILE IRON WATER LINE – FLOWABLE FILL BACKFILL.....LF

SP-110 THRU 114: GATE VALVES AND BOXES:

1.0 DESCRIPTION

Work associated with this item shall include all costs related to construction of gate valves and boxes according to Water and Sewer Authority of Cabarrus County Standard Specifications dated August 2006, in sizes as specified on plans, including, but not limited to excavation, valve support pads, materials, valve box, installation, extension stems as directed by the Owner or Engineer, standard backfill and compaction, and site restoration.

2.0 MEASUREMENT

Measurement will be made at the unit price bid for the actual number and size of valve installed and accepted. Quantities shall be verified in the field by the Owner or the Engineer.

3.0 PAYMENT

____" GATE VALVES AND BOXES.....EA

<u>SP-115: GATE VALVES AND BOXES – FLOWBLE FILL BACKFILL</u>

1.0 DESCRIPTION

Work associated with this item shall include all costs related to construction of gate valves and boxes according to Water and Sewer Authority of Cabarrus County Standard Specifications dated August 2006, in sizes as specified on plans, including, but not limited to excavation, valve support pads, materials, valve box, installation, extension stems as directed by the Owner or Engineer, backfill, and site restoration.

Additional City Specifications:

1. Backfill shall consist of excavatable flowable fill according to NCDOT Specification Section 1000.

2.0 MEASUREMENT

Measurement will be made at the unit price bid for the actual number and size of valve installed and accepted. Quantities shall be verified in the field by the Owner or the Engineer.

3.0 PAYMENT

____ " GATE VALVES AND BOXES – FLOWABLE FILL.....EA

SP-116: FIRE HYDRANT ASSEMBLY:

1.0 DESCRIPTION

Work associated with this item shall include all costs related to construction of fire hydrants according to Water and Sewer Authority of Cabarrus County Standard Specifications dated August 2006, including, but not limited to hydrant, hydrant extension, excavation, hydrant support pads, backfill and compaction, joint restraint, site restoration, and all related appurtenances.

2.0 MEASUREMENT

Measurement will be made based on the actual number of hydrants, complete with all appurtenances, installed and accepted. Quantities shall be verified in the field by the Owner or the Engineer.

3.0 PAYMENT

FIRE HYDRANT ASSEMBLY.....EA

SP-117: FIRE HYDRANT ASSEMBLY WITH TAPPING SLEEVE AND VALVE:

1.0 DESCRIPTION

Work associated with this item shall include all costs related to construction of fire hydrants according to Water and Sewer Authority of Cabarrus County Standard Specifications dated August 2006, including, but not limited to hydrant, hydrant extension, excavation, hydrant support pads, hydrant leg, valve box, precast concrete valve box protector, tapping sleeve and valve in lieu of hydrant tee, backfill and compaction, joint restraint and thrust blocking, site restoration, and all related appurtenances as shown on the Typical Fire Hydrant Assembly Detail.

2.0 MEASUREMENT

Measurement will be made based on the actual number of hydrants, complete with all appurtenances, installed and accepted. Quantities shall be verified in the field by the Owner or the Engineer.

3.0 PAYMENT

FIRE HYDRANT ASSEMBLY WITH TAPPING SLEEVE AND VALVE.....EA

SP-118: COMPACT DUCTILE IRON FITTINGS:

1.0 DESCRIPTION

Work associated with this item shall include all costs related to furnishing and installing compact ductile iron fittings of the type and size shown on the Plans according to Water and Sewer Authority of Cabarrus County Standard Specifications dated August 2006, including, but not limited to excavation, materials, installation including restrained retainer glands or deadmen as shown on the plans, backfill and compaction, and site restoration.

2.0 MEASUREMENT

Measurement will be made based on the actual number of pounds of compact ductile iron fittings installed and accepted. The contractor shall compute the number of pounds installed based upon the weight of each fitting. Weight basis shall be manufacturer's standard published information for weight of compact fittings. Weights shall be computed for each fitting excluding accessories, retainer glands and blocking.

3.0 PAYMENT

COMPACT DUCTILE IRON FITTINGS.....LB

SP-119 THRU 123: CONNECTION TO EXISTING WATER SYSTEM

1.0 DESCRIPTION

Work associated with this item shall include all costs related to furnishing and installing permanent connections to the existing water system according to Water and Sewer Authority of Cabarrus County Standard Specifications dated August 2006, including, but not limited to excavation, dewatering the existing water main between the connection and the nearest existing sectionalizing valves, removing the existing water main pipe plug, cutting and removing the section of existing water main piping, all pipe, fittings, adapters, connecting valve, and associated work in replacing the section of main which was removed or furnished, jointing materials including gaskets and bolts, temporary jumpers and appurtenances, and all other work required for installation of the

connection complete, tested, and placed into satisfactory service, in accordance with the Contract Documents and plans.

This item shall also include any materials, labor, and costs associated with installation and removal of temporary connections to the existing water system required to maintain domestic and fire protection water service through various phases of project construction.

This item does not include connection of domestic or fire service lines.

2.0 MEASUREMENT

The quantity of permanent connections to existing water systems to be paid will be actual number and size of permanent connections installed as shown on the drawings, with restrained sleeves and all appurtenances necessary to provide a complete and water tight connection to an existing water line as indicated on the drawings. Quantities shall be verified in the field by the Owner or the Engineer.

No separate measurement will be made for temporary connections to the existing water system in support of construction phasing.

3.0 PAYMENT

" CONNECTION TO EXISTING WATER SYSTEM.....EA

SP-124: 4" METER VAULT:

1.0 DESCRIPTION

Work associated with this item shall include all costs related to furnishing and installing the vault, vault access doors, excavation, stone base, valves and piping inside the vault, pipe supports, drain piping, compacted backfill, and all related appurtenances as shown on the meter vault detail on the plans.

The meter shall be provided by the Owner.

2.0 MEASUREMENT

The quantity of 4" meter vaults to be paid will be the actual number of meter vaults, complete with all appurtenances, installed and accepted. Quantities shall be verified in the field by the Owner or the Engineer.

3.0 PAYMENT

4" METER VAULT.....EA

SP-125 & 126: WATER SERVICE TAP:

1.0 DESCRIPTION

Work associated with this item shall include all costs related to furnishing and installing permanent water service taps by tap size according to Water and Sewer Authority of Cabarrus County Standard Specifications dated August 2006 and includes water service taps and service gate valves where indicated on the drawings, excavation, tapping saddle, corporation stop, gate valve, valve box, and compacted backfill.

2.0 MEASUREMENT

Measurement of water service taps shall be the actual number and size of permanent water service taps installed which have been properly incorporated into the completed and accepted work. Separate measurement items shall be made for each different size. Quantities shall be verified in the field by the Owner or the Engineer.

3.0 PAYMENT

" WATER SERVICE TAPE

SP-127 & 128: COPPER WATER SERVICE LINE:

1.0 DESCRIPTION

Work associated with this item shall include all costs related to furnishing and installing permanent Type K copper water service lines by size according to Water and Sewer Authority of Cabarrus County Standard Specifications dated August 2006 and includes all costs for excavation, Type K copper service line, fittings, transitions, connection to existing service line, removal of existing service line, and compacted backfill.

2.0 MEASUREMENT

Measurement of copper water service lines shall be the actual number of linear feet and size of permanent copper pipe water line installed which has been properly incorporated into the completed and accepted work. Pipe length shall be measured by horizontal linear feet in place measured along the pipe center line with no deduction for fittings, valves, etc. Separate measurement items shall be made for each different size pipe. Quantities shall be verified in the field by the Owner or the Engineer. No measurement will be made for temporary water service lines under this item.

3.0 PAYMENT

|--|

SP-129: 2" WATER METER BOX

1.0 DESCRIPTION

Work associated with this item shall include all costs related to furnishing and installing water meter boxes according to Water and Sewer Authority of Cabarrus County Standard Specifications dated August 2006 and project drawings. This item includes all costs for the meter boxes, excavation, stone base, and all related appurtenances as shown on the meter box detail on the plans.

The meter and meter valve flange shall be provided by the Owner.

2.0 MEASUREMENT

The quantity of 2" water meter boxes to be paid will be the actual number of permanent meter boxes, complete with all appurtenances, installed and accepted. Quantities shall be verified in the field by the Owner or the Engineer. No measurement will be made for temporary water meter box installations under this item.

3.0 PAYMENT

2" WATER METER BOX.....EA

SP-130: 2" PRESSURE REDUCING VALVE IN METER BOX

1.0 DESCRIPTION

Work associated with this item shall include all costs related to furnishing and installing permanent 2" pressure reducing valves in meter boxes and includes meter boxes, excavation, stone base, pressure reducing valve, curb stop valve, and all related appurtenances as shown on the meter box detail on the plans.

2.0 MEASUREMENT

Measurement shall be made based on the actual number of permanent installations, complete with all appurtenances, installed and accepted. Quantities shall be verified in the field by the Owner or the Engineer. No measurement will be made for temporary pressure reducing valve installations under this item.

3.0 PAYMENT

2" PRESSURE REDUCING VALVE IN METER BOX......EA

SP-131: 3/4" REDUCED PRESSURE BACKFLOW ASSEMBLY

1.0 DESCRIPTION

Work associated with this item shall include all costs related to furnishing and installing permanent 3/4" reduced pressure backflow assemblies, complete with all appurtenances and includes excavation, concrete base, fittings, supports, insulated

enclosure, electrical wiring and conduit, heating source, and all related appurtenances as required by the drawings and specifications.

2.0 MEASUREMENT

Measurement shall be made based on the actual number of permanent installations, complete with all appurtenances, installed and accepted. Quantities shall be verified in the field by the Owner or the Engineer.

3.0 PAYMENT

3/4" REDUCED PRESSURE BACKFLOW ASSEMBLY......EA

SP-132: AIR RELEASE VALVE

1.0 DESCRIPTION

Work associated with this item shall include all costs related to furnishing and installing permanent air release valve assemblies, complete with all appurtenances and includes excavation, corporation stop, tapping saddle, copper piping, meter box, gate valve, stone base, base, fittings, supports, backfill, and all related appurtenances as required by the drawings and specifications.

2.0 MEASUREMENT

Measurement shall be made based on the actual number of permanent installations, complete with all appurtenances, installed and accepted. Quantities shall be verified in the field by the Owner or the Engineer.

3.0 PAYMENT

AIR RELEASE VALVE.....EA

SP-133: TEMPORARY 2" WATER SERVICE

1.0 DESCRIPTION

Work associated with this item shall include all costs related to furnishing and installing temporary 2" water services including excavation, temporary Type K copper service line, tie-ins, fittings, transitions, meter boxes for temporary meter sets, compacted backfill, adjustments to previously installed temporary water services, and removal of previously installed temporary water services.

2.0 MEASUREMENT

Measurement shall be made based on the actual number of temporary services installed, complete with all appurtenances. The Contractor shall receive approval from the Owner prior to installing temporary water services. Quantities shall be verified in the field by the Owner or the Engineer.

3.0 PAYMENT

TEMPORARY 2" WATER SERVICE.....EA

SP-134 & 135: REMOVE AND ABATE EXISTING 8" ASBESTOS CEMENT WATER LINE:

1.0 DESCRIPTION

Work associated with this item shall include all costs related to removal, abatement, and disposal of existing asbestos cement water line, excavation, backfill by type (either standard compacted backfill or flowable fill backfill), and all work and materials as required by the drawings and specifications.

Additional City Specifications:

1. Flowable fill backfill shall consist of excavatable flowable fill according to NCDOT Specification Section 1000.

Guidelines and Procedures

The Contractor shall follow the requirements in the "Abatement of Asbestos-Cement Piping Guidelines and Procedures" document included in the appendix.

The Contractor shall obtain approval from the Engineer prior to removing any section of AC pipe.

Final clearance testing (if needed) will be paid for by the City of Concord.

Additional Insurance Requirements for Asbestos Abatement Contractors/Subcontractors

In addition to the insurance requirements set forth in the Construction Contract, asbestos abatement contractors/subcontractors are required to provide additional insurance coverages as follows:

<u>Asbestos Abatement Liability Insurance:</u>

Asbestos abatement liability coverage including coverage for liability for bodily injury and property damage arising from the encapsulation, removal, handling, storage, transportation, and disposal of asbestos containing materials with a limit of \$1,000,000 per accident; \$1,000,000 disease per employee; and

\$1,000,000 disease policy limit, with a combined single limit of at least \$2,000,000 per occurrence.

The policy must be a claims-made policy and the coverage period shall be determined by the following formula: continuous coverage for life of the Contract, plus one (1) year (to provide coverage for the warranty period), with an extended discovery period for a minimum of five (5) years which shall not commence until the expiration of the longest warranty period(s).

Asbestos abatement liability insurance shall comply with the requirements in Section 8 of the Construction Contract, including listing the City as additional insured. Asbestos abatement liability insurance shall also include a Waiver of Subrogation in favor of the City of Concord.

2.0 MEASUREMENT

Measurement shall be made based on the actual number of linear feet removed and abated. Separate measurements will be made for standard compacted trench backfill and flowable fill backfill. Quantities shall be verified in the field by the Owner or the Engineer.

3.0 PAYMENT

REMOVE AND ABATE EXIST. 8" AC WATER LINE.....LF

REMOVE AND ABATE EXIST. 8" AC WATER LINE – FLOWABLE FILL
BACKFILL.....LF

SP-136: DEMO - CONCRETE POLE BASES / FOOTINGS

1.0 DESCRIPTION

Work associated with this line item shall consist of the demolition of existing pole bases for light poles being replaced along Union Street, including any associated ground rods.

2.0 MEASUREMENT

Measurement shall be made based upon the actual number of pole bases demolished.

3.0 PAYMENT

DEMOLISHED LIGHT POLE BASES EA

<u>SP-137: DEMO - EXISTING CIRCUITS, HANDHOLES, ELECTRICAL APPLIANCES</u> AND CONCRETE ENCASED DUCTBANKS

1.0 DESCRIPTION

Work associated with this line item shall consist of the demolition of all electrical circuits and electrical appliances located on Union Street and Barbrick Avenue as shown on the drawings. This shall include demolition of existing feeder and branch circuits including wiring, conduit, and ductbanks; demolition of existing electrical handholes; demolition of existing wiring appliances, and tree lighting circuits, etc.

2.0 MEASUREMENT

There will be no separate measurement made for demolition of existing circuits, handholes, and electrical appliances.

3.0 PAYMENT

DEMOLISHED CIRCUITS, HANDHOLES AND ELECTRICAL APPLIANCES LS

SP-138: INSTALLATION OF LIGHT POLES, TYPE A

1.0 DESCRIPTION

Work associated with this line item shall include all labor required for the installation of Type 'A' light poles (light poles provided by others). This scope shall include installation only and shall not include connecting power and communication circuits.

2.0 MEASUREMENT

Measurement shall be made based upon the actual number of Type A light poles installed.

3.0 PAYMENT

TYPE A LIGHT POLE INSTALLATION EA

SP-139: INSTALLATION OF LIGHT POLES, TYPE B

1.0 DESCRIPTION

Work associated with this line item shall include all labor required for the installation of Type 'B' light poles (light poles provided by others). This scope shall include installation only and shall not include connecting power and communication circuits.

2.0 MEASUREMENT

Measurement shall be made based upon the actual number of Type B light poles installed

3.0 PAYMENT

TYPE B LIGHT POLE INSTALLATION EA

SP-140: WIRING DEVICES AND APPLIANCES

1.0 DESCRIPTION

Work associated with this line item shall include the procurement and installation of all wiring devices including vendor receptacles, tree lighting receptacles, special outlets, up-light fixtures, and heat tracing shown on plans, including all appurtenances required for complete installation.

2.0 MEASUREMENT

There will be no separate measurement made for this line item.

3.0 PAYMENT

WIRING DEVICES INSTALLATIONLS

SP-141: LIGHTED BOLLARDS

1.0 DESCRIPTION

Work associated with this line item shall include the procurement and installation of lighted bollards, including all appurtenances required for complete installation.

2.0 MEASUREMENT

Measurement shall be made based upon the actual number of Lighted Bollards installed.

3.0 PAYMENT

LIGHTED BOLLARD INSTALLATION EA

SP-142: EXOTHERMIC WELD

1.0 DESCRIPTION

Work associated with this line item shall include the exothermic weld connections of all grounding electrode conductors to all grounding electrodes including all listed appurtenances and components required.

2.0 MEASUREMENT

Measurement shall be made based upon the actual number of ground rods welded to grounding electrode conductors.

3.0 PAYMENT

WELDED GROUND RODS	. E	Α
--------------------	-----	---

SP-143: INTELLIGENT LIGHTING PANELS

1.0 DESCRIPTION

Work associated with this line item shall include the procurement and installation of intelligent lighting panels including service feeder conductors and conduit from the utility transformer or meter base to the panel. This scope shall also include all branch circuit breakers and all appurtenances required for the installation and operation of the panel. This scope shall also include the procurement and installation of surge protective devices (SPD) for each panel.

2.0 MEASUREMENT

Measurement shall be made based upon the actual number of Intelligent Lighting Panels installed.

3.0 PAYMENT

INTELLIGENT LIGHTING PANELS EA

SP-144: NO. 12 AWG COPPER WIRING

1.0 DESCRIPTION

Work associated with this line item shall include the procurement and installation in conduit of all No. 12 AWG copper wire for designated branch circuits as shown on plans. This shall include all required terminations at electrical components for a complete and working electrical circuit.

2.0 MEASUREMENT

Measurement shall be made along the top surface.

3.0 PAYMENT

NO. 12 AWG WIRE INSTALLATIONLF

SP-145: NO. 10 AWG COPPER WIRING

1.0 DESCRIPTION

Work associated with this line item shall include the procurement and installation in conduit of all No. 10 AWG copper wire for designated branch circuits as shown on plans. This shall include all required terminations at electrical components for a complete and working electrical circuit.

2.0 MEASUREMENT

Measurement shall be made along the top surface.

3.0 PAYMENT

NO.10 AWG WIRE INSTALLATIONLF

SP-146: NO. 8 AWG COPPER WIRING

1.0 DESCRIPTION

Work associated with this line item shall include the procurement and installation in conduit of all No. 8 AWG copper wire for designated branch circuits as shown on plans. This shall include all required terminations at electrical components for a complete and working electrical circuit.

2.0 MEASUREMENT

Measurement shall be made along the top surface.

3.0 PAYMENT

NO. 8 AWG WIRE INSTALLATIONLF

SP-147: NO. 6 AWG COPPER WIRING

1.0 DESCRIPTION

Work associated with this line item shall include the procurement and installation in conduit of all No. 6 AWG copper wire for designated branch circuits as shown on plans. This shall include all required terminations at electrical components for a complete and working electrical circuit.

2.0 MEASUREMENT

Measurement sh	all be made	e along the	top surface.

3.0 PAYMENT

NO. 6 AWG WIRE INSTALLATIONLF

SP-148: RGS CONDUIT 1" TRADE SIZE

1.0 DESCRIPTION

Work associated with this line item shall include the procurement and installation of 1" RGS conduit as shown on the plans. This shall include all conduit fixtures, supports, and appliances required for the installation of conduit per plans and specifications. This shall include nylon pull cable in all installed conduit.

2.0 MEASUREMENT

Measurement shall be made along the top surface.

3.0 PAYMENT

RGS CONDUIT 1" INSTALLATIONLF

SP-149: PVC SCHEDULE 40 CONDUIT 1" TRADE SIZE

1.0 DESCRIPTION

Work associated with this line item shall include the procurement and installation of 1" PVC Schedule 40 conduit as shown on the plans. This shall include all conduit fixtures, supports, and appliances required for the installation of conduit per plans and specifications. This shall include nylon pull cable in all installed conduit.

2.0 MEASUREMENT

Measurement shall be made along the top surface.

3.0 PAYMENT

PVC SCHEDULE 40 1" INSTALLATIONLF

SP-150: PVC SCHEDULE 40 CONDUIT 2" TRADE SIZE

1.0 DESCRIPTION

Work associated with this line item shall include the procurement and installation of 2" PVC Schedule 40 conduit as shown on the plans. This shall include all conduit fixtures, supports, and appliances required for the installation of conduit per plans and specifications. This shall include nylon pull cable in all installed conduit.

2.0 MEASUREMENT

Measurement shall be made along the top surface.

3.0 PAYMENT

PVC SCHEDULE 40 2" INSTALLATIONLF

SP-151: PVC SCHEDULE 40 CONDUIT 4" TRADE SIZE

1.0 DESCRIPTION

Work associated with this line item shall include the procurement and installation of 4" PVC Schedule 40 conduit as shown on the plans. This shall include all conduit fixtures, supports, and appliances required for the installation of conduit per plans and specifications. This shall include nylon pull cable in all installed conduit.

2.0 MEASUREMENT

Measurement shall be made along the top surface.

3.0 PAYMENT

PVC SCHEDULE 40 4" INSTALLATIONLF

SP-152: TRENCHING

1.0 DESCRIPTION

Work associated with this line item shall include all required trenching for the installation of ductbanks including ductbanks located beneath sidewalks and ductbanks located within roadways. This scope of work shall also include the procurement of all required equipment and the backfill of all trenches. Repair of all roadway crossings shall be repaired all the way back to the current top asphalt surface at the time of trenching including but not limited to suitable compacted backfill and base and surface asphalt as applicable.

2.0 MEASUREMENT

Measurement shall be made along the top surface.

3.0 PAYMENT

ELECTRICAL TRENCHINGLF

SP-153: ANNOUNCEMENT KIOSK

1.0 DESCRIPTION

Work associated with this line item shall include the procurement and installation of the announcement kiosk together with all required supports, anchors, and appurtenances required for complete installation.

2.0 MEASUREMENT

Measurement shall be made based upon the complete installation of the Announcement Kiosk.

3.0 PAYMENT

ANNOUNCEMENT KIOSK INSTALLATION EA

SP-154: LIGHT POLE BASES / FOOTINGS

1.0 DESCRIPTION

Work associated with this line item shall include the procurement and installation of all light pole footings, including but not limited to concrete, rebar, and all appurtenances required for complete installation.

2.0 MEASUREMENT

Measurement shall be made based upon the actual number of light pole bases installed.

3.0 PAYMENT

LIGHT POLE BASE INSTALLATION EA

SP-155: GROUND RODS

1.0 DESCRIPTION

Work associated with this line item shall include the procurement and installation of grounding electrode rods for service entrance grounding, light pole grounding, and grounding of manholes, including all appurtenances and equipment required for complete installation.

2.0 MEASUREMENT

Measurement shall be made based upon the actual number of ground rods installed.

3.0 PAYMENT

GROUND ROD INSTALLATION EA

SP-156: ELECTRICAL HAND HOLES

1.0 DESCRIPTION

Work associated with this line item shall include the procurement and installation of all electrical hand holes as shown on plans, including all appurtenances required for complete installation.

2.0 MEASUREMENT

Measurement shall be made based upon the actual number of hand holes installed.

3.0 PAYMENT

HAND HOLE INSTALLATION EA

SP-157: COMMUNICATION MANHOLES

1.0 DESCRIPTION

Work associated with this line item shall include the procurement and installation of communication manholes as shown on the plans, including all appurtenances required for complete installation.

2.0 MEASUREMENT

Measurement shall be made based upon the actual number of manholes installed.

3.0 PAYMENT

MANHOLE INSTALLATION EA

SP-158: FIBEROPTIC CABLE

1.0 DESCRIPTION

Work associated with this line item shall include the procurement and installation of all fiberoptic cable in conduit, including termination, and including all appurtenances and appliances required for complete installation.

2.0 MEASUREMENT

Measurement shall be made along the top surface.

3.0 PAYMENT

FIBEROPTIC CABLE INSTALLATIONLF

SP-159: SERVICE PANEL ENCLOSURE AND CONCRETE PAD

1.0 DESCRIPTION

Work associated with this line item shall include the procurement and installation of the NEMA rated enclosure for housing service entrance panel LP-A, concrete housekeeping pad and all appurtenances required for complete installation.

2.0 MEASUREMENT

Measurement shall be made based upon the complete installation of Service Panel Enclosure.

3.0 PAYMENT

SERVICE PANEL ENCLOSURE INSTALLATION EA

SP-160: GROUNDING ELECTRODE CONDUCTORS

1.0 DESCRIPTION

Work associated with this line item shall include the procurement and installation of all grounding electrode conductors or jumpers for grounding of the service entrance, light poles, and manholes, including all appurtenances required for complete installation.

2.0 MEASUREMENT

There will be no separate measurement made for this line item.

3.0 PAYMENT

GROUNDING ELECTRODE CONDUCTORS INSTALLATIONLS

SP-161: PANELBOARD LP-B2

1.0 DESCRIPTION

Work associated with this line item shall include the procurement and installation of panel LP-B2, including all appurtenances required for complete installation. Also included are all integral circuit breakers and electrical components as well as the connection of all branch or feeder circuits within the panel.

2.0 MEASUREMENT

Measurement shall be made based upon the complete installation of Panel LP-B2.

3.0 PAYMENT

PANEL LP-B2 INSTALLATION EA

SP-162: TEMPORARY LIGHTING

1.0 DESCRIPTION

Work associated with this line item shall include the procurement and operation of temporary lighting fixtures for use on Union Street. This scope shall also include the cost of generators and fuel, when necessary, for the recharging of battery stations. This scope shall also include the relocation of said lighting fixtures when required to meet the temporary lighting needs of the city whenever permanent light fixtures along Union Street are out of service. This scope covers temporary lighting requirements for the duration of the project. The scope of work in this line item shall be considered complete when temporary lighting is no longer required as agreed upon by the owner and engineer.

2.0 MEASUREMENT

There will be no separate measurement made for this line item.

3.0 PAYMENT

TEMPORARY LIGHTINGLS

SP-163: CONCRETE DUCT BANK ENCASEMENT

1.0 DESCRIPTION

Work associated with this line item shall include the procurement and installation of concrete encasement for electrical duct banks, including concrete and rebar and all other necessary items for complete concrete ductbank installation.

2.0	MEASUREMENT
Meası	urement shall be made along the top surface.
3.0	PAYMENT
CONC	CRETE DUCT BANK ENCASEMENTLF
	END OF SECTION

Job Address: 23 UNION ST S, CONCORD NC 28025 Conditions for record PRS2021-01915

but is not limited to removal of existing asphalt, concrete, and curbing, water line and sewer line improvements, storm drainage, the installation of concrete sidewalk with intersection of Union Street and Foard Ave and along Barbrick Ave. Work includes brick bands and accents, concrete curbing, seat walls, site furnishings, landscaping, improvements from the intersection of Union Street and Killarney Avenue to the Job Description: The Union Street Improvements project consists of streetscape street lighting, signage, and asphalt paving.

Discipline	Status	Details	Attached To	Created By
		Specific Comments		
Fire	Open	1. Any reduction in street width as shown in design shall be discussed with Fire prior to implementation 2. Any utility modifications that could impact existing fire protection systems shall be discussed with fire prior to implementation. 3. Relocation of any FDC locations shall be discussed with fire prior to implementation.	NOT	Travis McGaha
Fire	Open	General Comments	N0T	Travis
		1. This jurisdiction abides by and enforces the requirements of NFPA 241 for construction projects. A document we refer to as an NFPA 241 letter is required verifying that all parties involved in this project know of and agree, to abide by the provision requiring water, hydrants, and access roads be in operation prior to vertical combustible construction. 2. When fire apparatus access roads or a water supply for fire protection is required to be installed, such protection shall be installed and made serviceable prior to and during the time of construction except when approved alternative methods of protection are provided. (NCFC 501.4) 3. Needed Fire Flow for the structure must be provided and maintained. 4. The site address shall be posted in a temporary form and upon completion in a permanent form in a		

8/18/2021

apparatus access shall extend to within 150 feet of all portions of the facility as measured by an approved route around the exterior of the facility. (NCFC Fire Department Connections (FDC) shall be provided for sprinkler systems the exterior of the building, on-site fire hydrant and mains shall be provided shall be determined by the fire official. (NCFC 503.2.4) 9. Dead end access 503.2.1) 7. Fire access roads shall have unobstructed clearance of 13 foot 6 and be remote from the building with signage. (NCFC 912.1). The location exceeding three stories or 30 feet in height shall have at least two means of department specifications and approved prior to installation. (NCFC 503.3) where required by the fire code official. (NCFC 507.5.1) 12. Fire Hydrants painted Red. All new hydrants shall be equipped with a 5" Storz fitting. 13. inches. (NCFC 503.2.1) 8. The required turning radius of fire access roads Blockage to access after construction may result in future requirements for 503.1.1) 6. Access roads to building are required to be 20 feet in width for moved into or within the jurisdiction is more than 400 feet from a hydrant required for access to the structure are required to be stripped and marked sprinklers shall have two access roads placed a distance apart equal to not on a fire apparatus access road, as measured by an approved route around visible location in 6-inch characters in a reflective material & contrasting stripping and signage. Contact Concord Fire Prevention Division prior to Buildings exceeding 62,000 sqft. without sprinklers or 124,000 sqft. with may not obstruct access to the buildings for other fire apparatus due hose extinguishers on site during construction. 16. Fire apparatus access roads connection (NCFC 912.2) see section 912 for details on FDC's. 14. Fire - Public hydrants shall be painted yellow and Private Hydrants shall be coads in excess of 150 feet in length shall be provided with an approved ane stripping for details. All lanes shall be marked in accordance with fire apparatus access for each structure. (NCFC D105.1 & D105.2) 18. provided for every facility or building within the jurisdiction. The fire 11. Where a portion of the facility or building hereafter constructed or buildings up to 30 feet high and 26 feet for those over 30 feet. (NCFC color. (NCFC 505.1) 5. Approved fire apparatus access roads shall be area for turning around fire apparatus. (NCFC 503.2.5) 10. Fire lanes Hydrants are required within 200 feet of the location of the FDC. 15. shall not exceed 10 percent in grade. (NCFC D103.2) 17. Buildings by signs prohibiting parking in areas where access may be blocked. Structures under construction are required to have temporary fire

8/18/2021


Print View


	less than one half of the length of the maximum overall diagonal dimension of the property or area to be served, measured in a straight line between accesses. (NCFC D104.2 & D104.3) 19. Multiple-family residential developments having more than 100 dwelling units shall be equipped throughout with two separate and approved fire apparatus access roads. Projects equipped throughout with approved automatic sprinkler systems may have one entrance up to 200 units and above 200 must have a second remote entrance (NCFC D106.1 & D106.2) 20. One or Two-family residential developments. Developments where the number of dwelling units exceeds 30 shall be provided with separate and approved fire apparatus access roads and shall meet the required, they shall be placed a distance apart equal to not less than one half of the length of the maximum overall diagonal dimension of the property or area to be served, measure in a straight line between accesses. (NCFC D104.3) 22. Please see Concord Fire Prevention Division's Web Page for details and specifications (http://www.concordnc.gov/Departments/Fire/Fire-Prevention-Division/Fire-Prevention-Division-Downloads). Please understand that approval of these documents in no way relieves the owner, architect, or engineer from responsibility related to violations of the governing codes and regulations not found by our office or other reviewing agencies. When such violations are found they must be corrected. • The Occupancy of the building/upfit area shall not be conducted prior to a Certificate of Compliance & Occupancy being obtained from the Cabarrus County Building Inspection Department.		
Electric Open	Feed traffic light	ED-102	Brandon
Utility	Will need to field coordinate how to feed traffic light at Union/Cabarrus with City electric department.		Hargett
	Street lighting		
Electric Open Utility	Will need to field co-ordinate with City electric department on how to keep feed to existing City street lighting on Union towards Foard outside the limits of this project.	E-104	Brandon Hargett


8/18/2021

Print View

Discipline	Status	Details	Attached To	Created By
		General comments		
Electric Utility	Open	All electrical installations must comply with City of Concord technical standards manual. Coordinate all electrical demolition and installation with City electric department.	G-002	Brandon Hargett
		NCDOT 2-Party Utility Encroachment		Cherry
Engineering	Open	NCDOT 2-Party Utility Encroachment Authorization - Conditions imposed by NCDOT shall be considered incorporated herein.	NOT	Moore
		Phasing of Underground Utilities and Infrastructure		
Engineering	Open	Phasing of Underground Utilities and Infrastructure – The phasing of the underground utilities and infrastructure extensions/modifications is to be closely coordinate with the designated City Construction Inspector, Water Resources, the applicable City Departments, and outside agencies. The sequencing and phasing of the underground utilities and infrastructure extensions and modifications must minimize the disruptions to the existing customer's service and operations; and minimize the number temporary fittings and interim interconnections to the existing active mains.	G-003	Sherri Moore

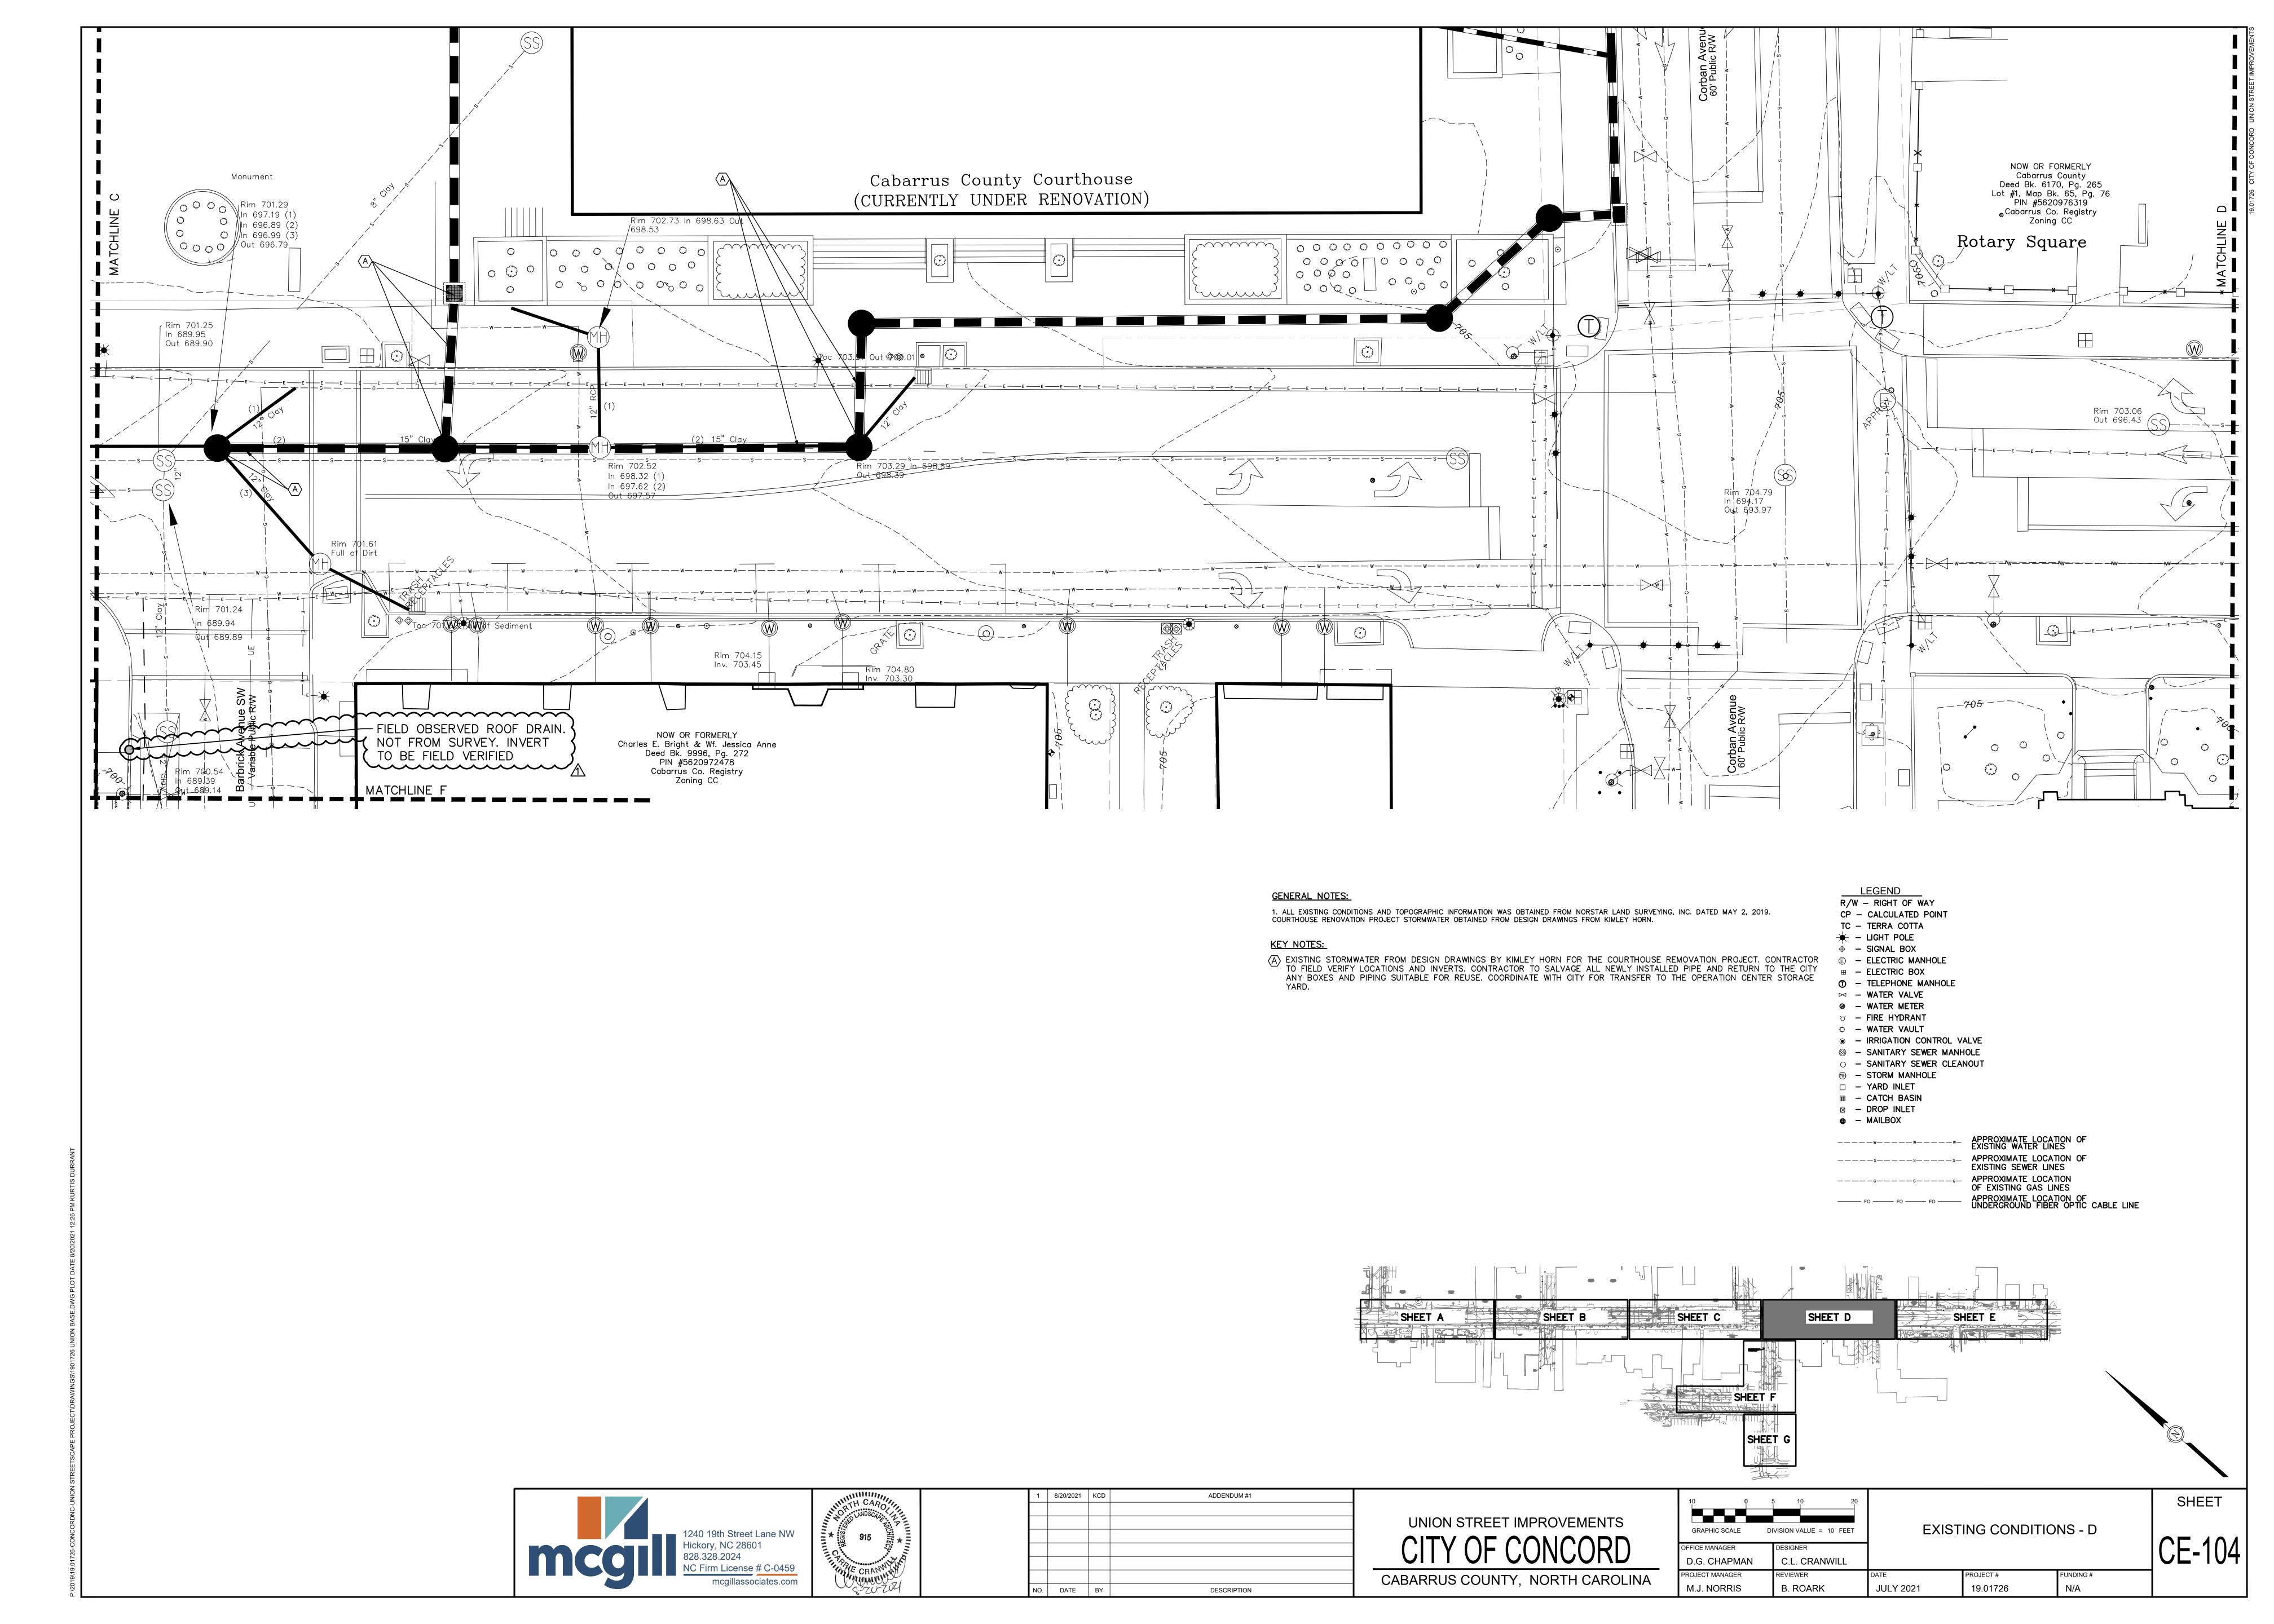

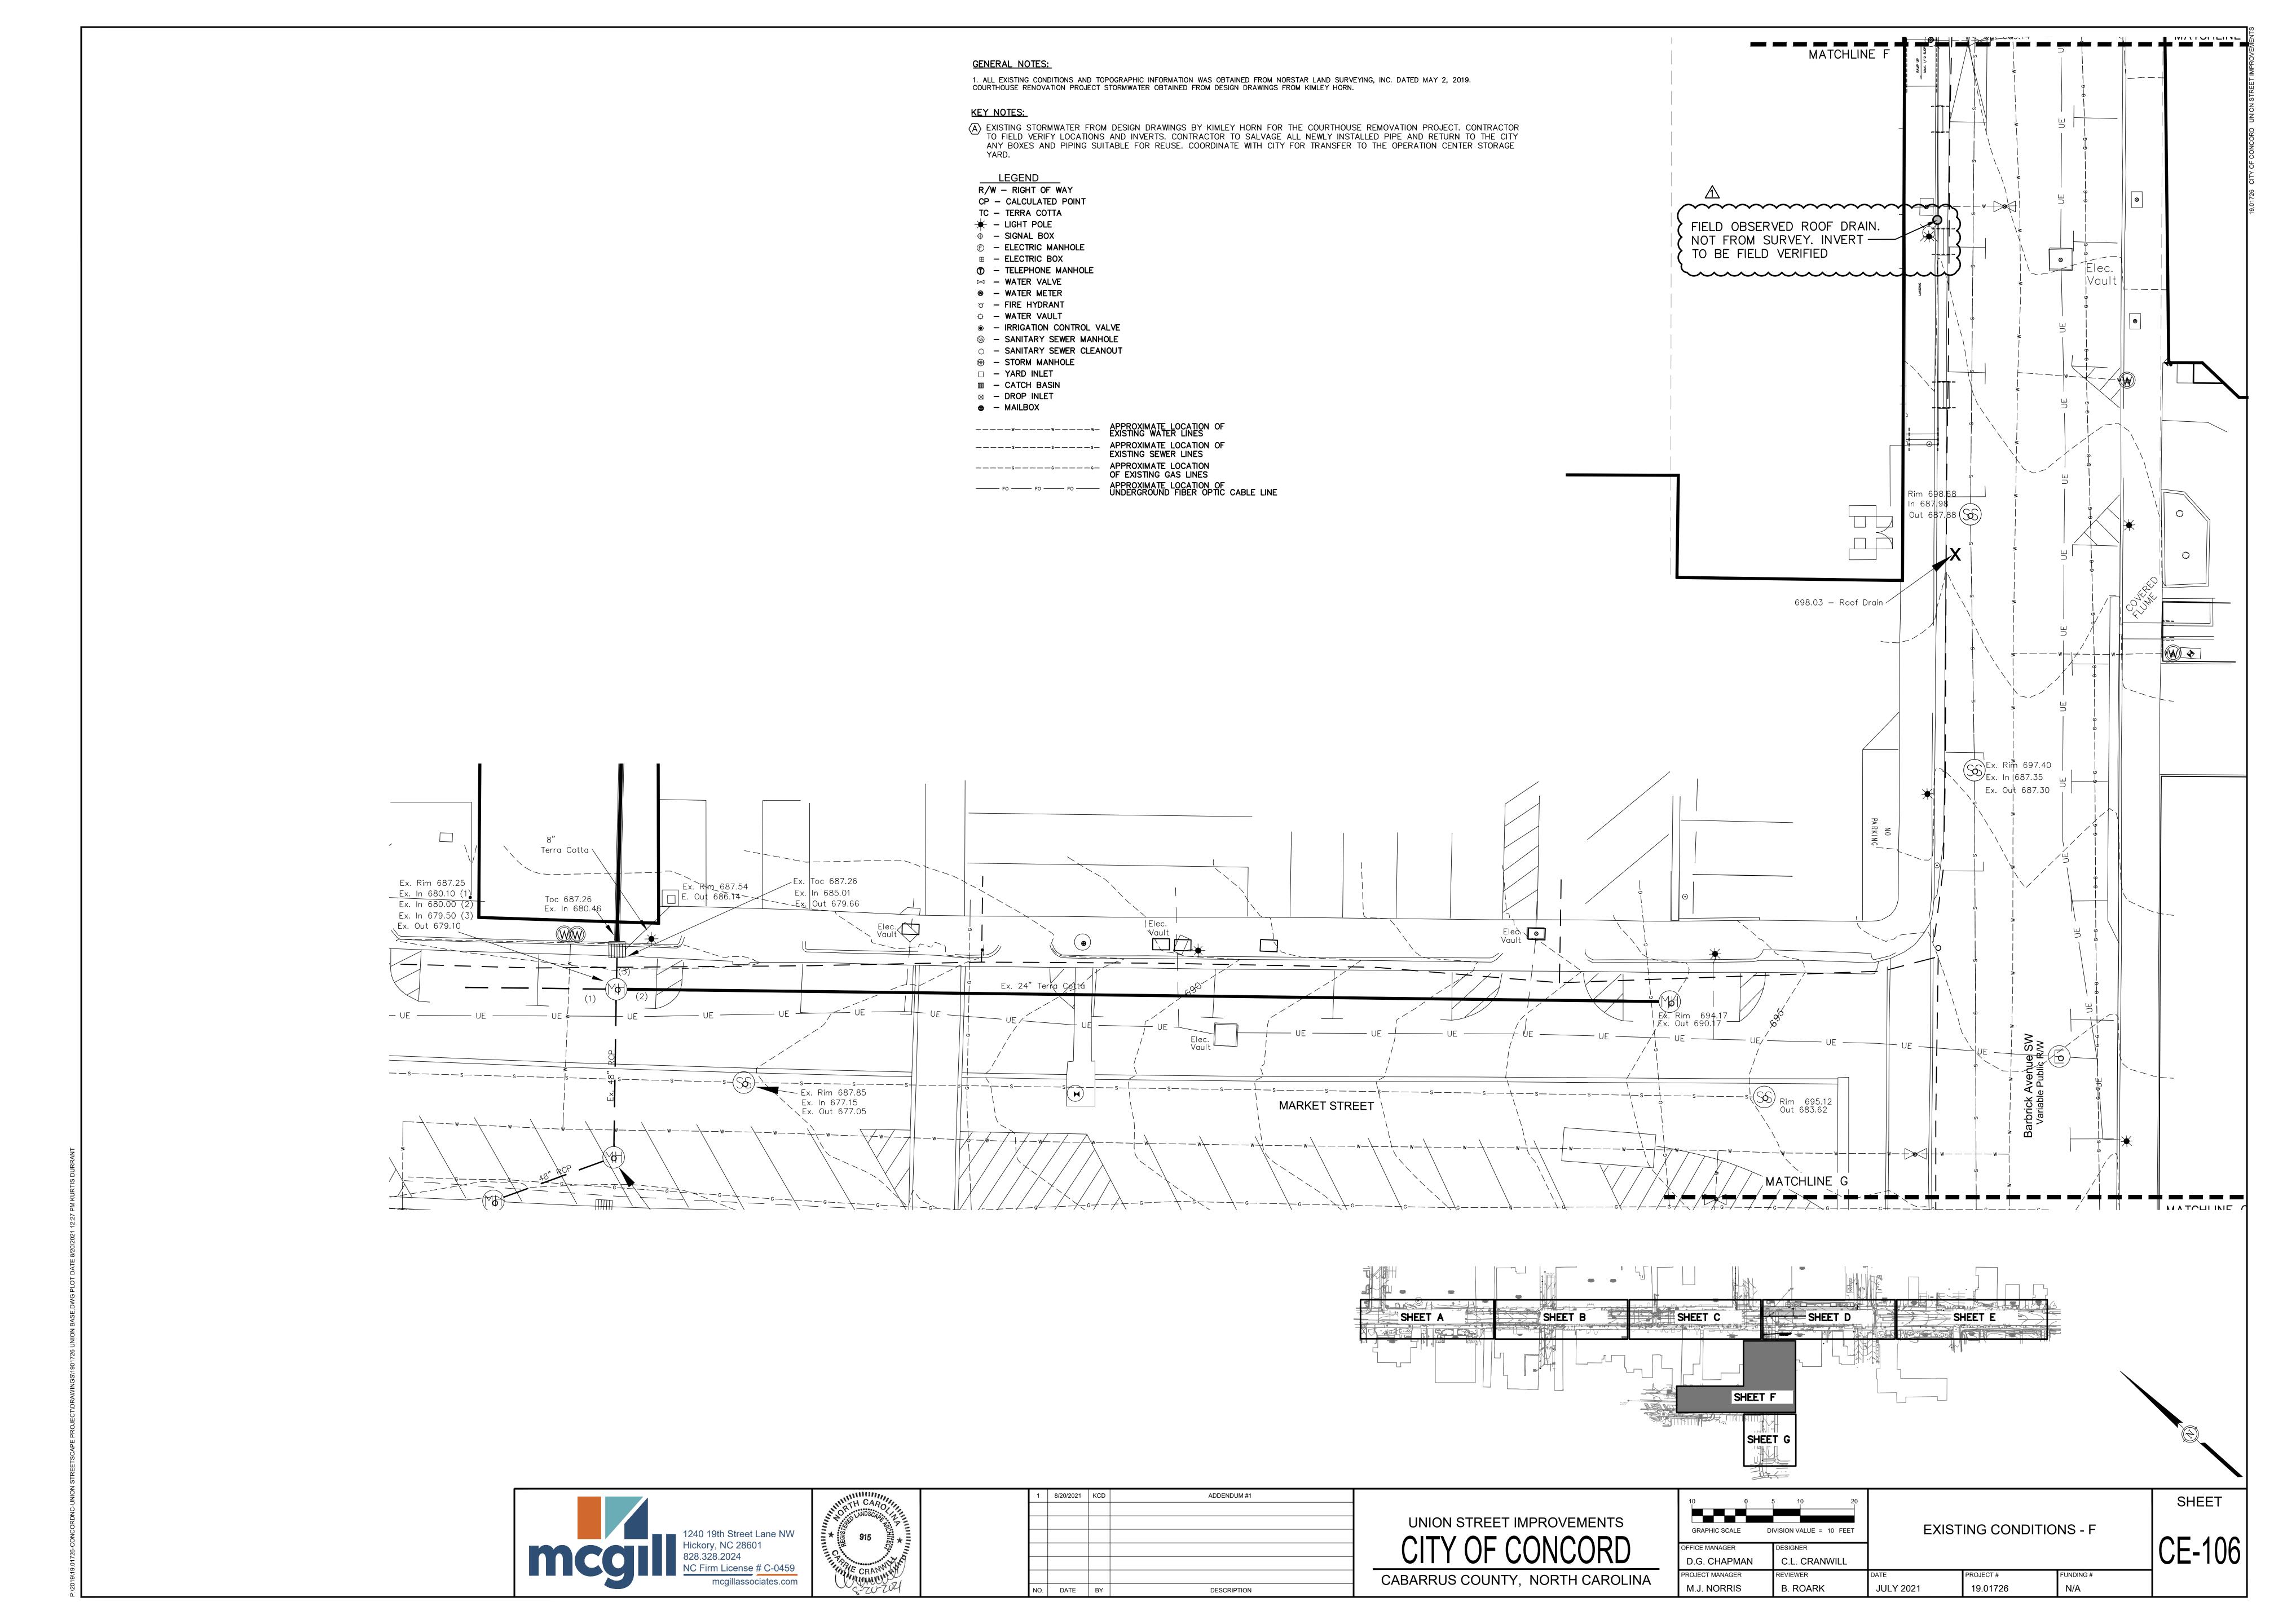

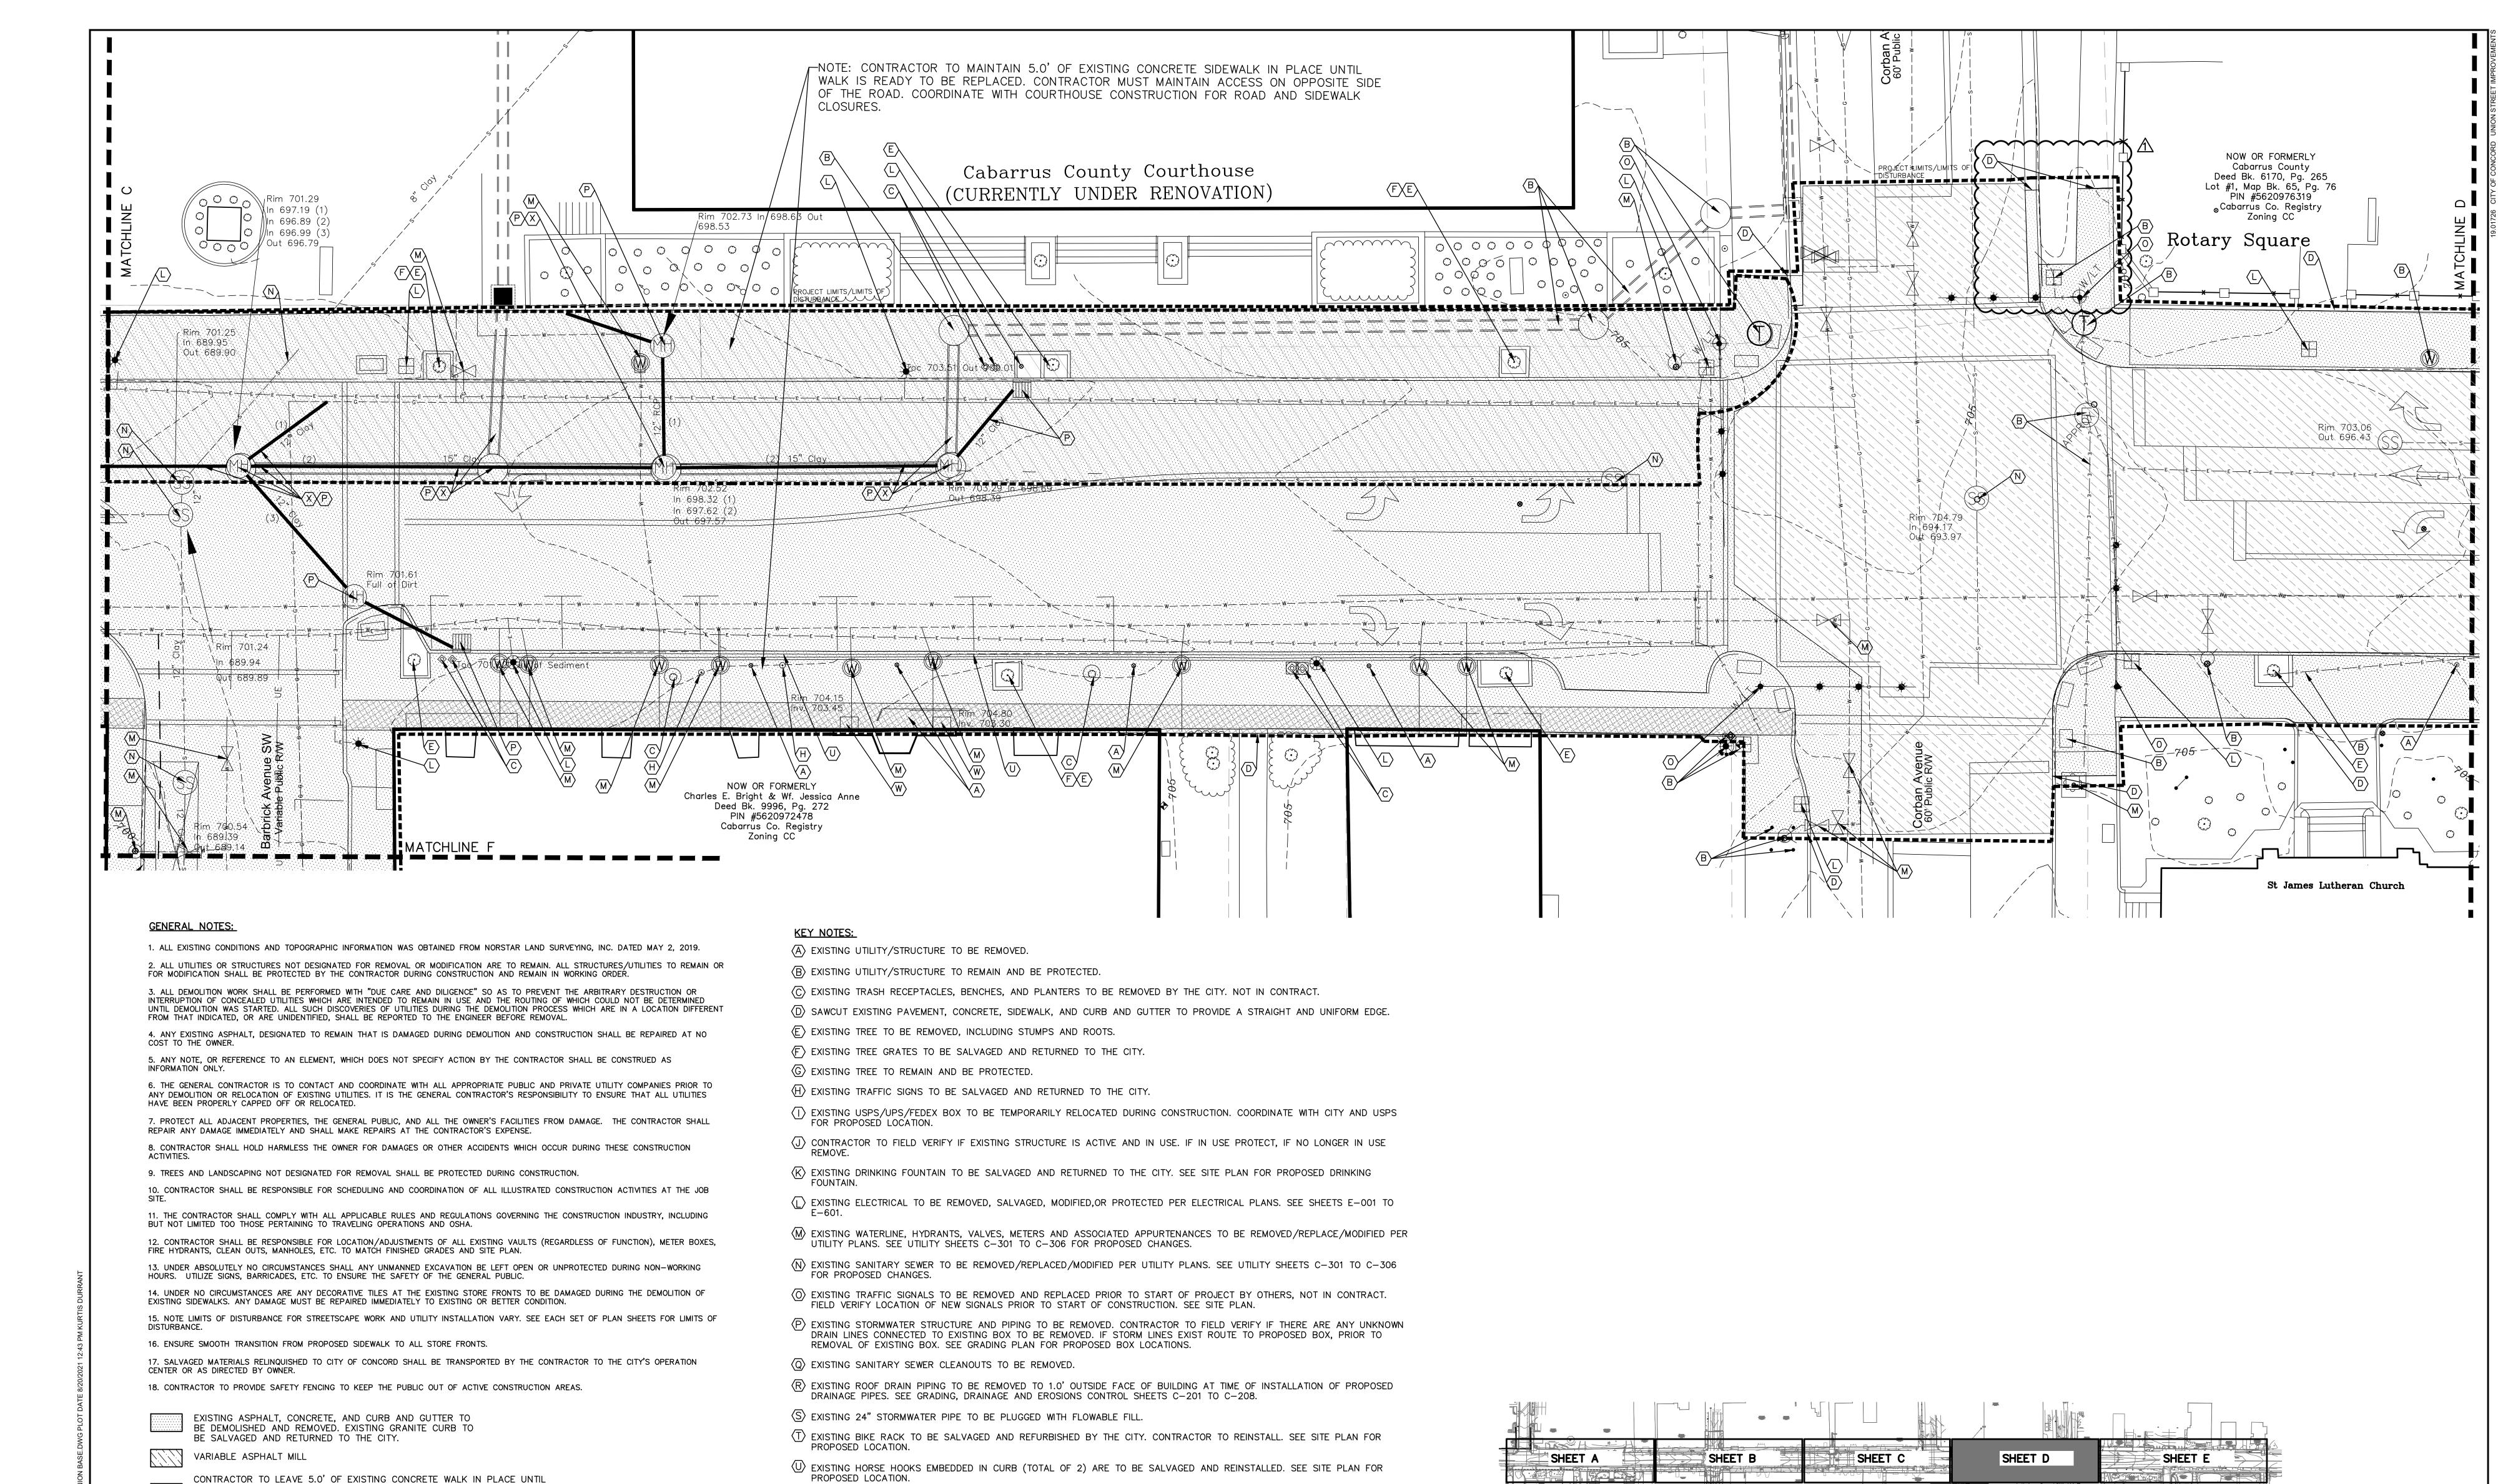


1240 19th Street Lane NW
Hickory, NC 28601
828.328.2024
NC Firm License # C-0459
mcgillassociates.com

WALK IS READY TO BE REPLACED. AS WALK IS REMOVED CONTRACTOR

MUST REPLACE EACH SECTION WITH A NON-SLIP ACCESSIBLE SURFACE

FOR STORE ACCESS UNTIL NEW WALK IS INSTALLED.

STORMWATER AND UTILITY TRENCH ASPHALT REMOVAL

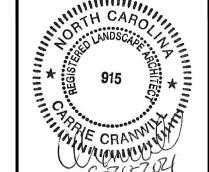

COORDINATE WITH COURTHOUSE PROJECT CONTRACTOR.


▼ STORMWATER PIPE DEMOLITION TO BE COMPLETED BY OTHERS AS PART OF THE COURTHOUSE PROJECT, CONTRACTOR TO

EXISTING DRAINAGE STRUCTURE TO BE REMOVED FOR THE FIRST 5.0 FEET AND THE REMAINDER CAPPED FOR A MINIMUMOF 5' WITH FLOWABLE FILL AND ABANDONED IN PLACE. REMOVE STORM DRAIN TO EXISTING CURB INLET.

X EXISTING STORMWATER PIPES AND BOXES INSTALLED/MODIFIED AS PART OF THE COURTHOUSE RENOVATION TO BE

(W) EXISTING GRATE TO BE REMOVED AND REPLACED WITH NEW GRATE TO MATCH EXITING SIZE AND STYLE.

REMOVED/REPLACED AS PROPOSED STORMWATER PIPES/STRUCTURES ARE INSTALLED.

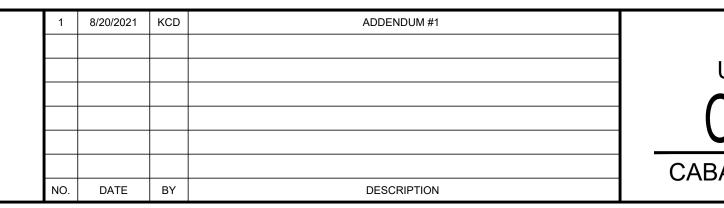

UNION STREET IMPROVEMENTS

CITY OF CONCORD

CABARRUS COUNTY, NORTH CAROLINA

GRAPHIC SCALE DIVISION VALUE = 10 FEET

DEMOLITION PLAN - D

OFFICE MANAGER

D.G. CHAPMAN

C.L. CRANWILL

ROJECT MANAGER

M.J. NORRIS

B. ROARK


DEMOLITION PLAN - D

PROJECT # FUNDING #

N/A

SHEET

CD-104

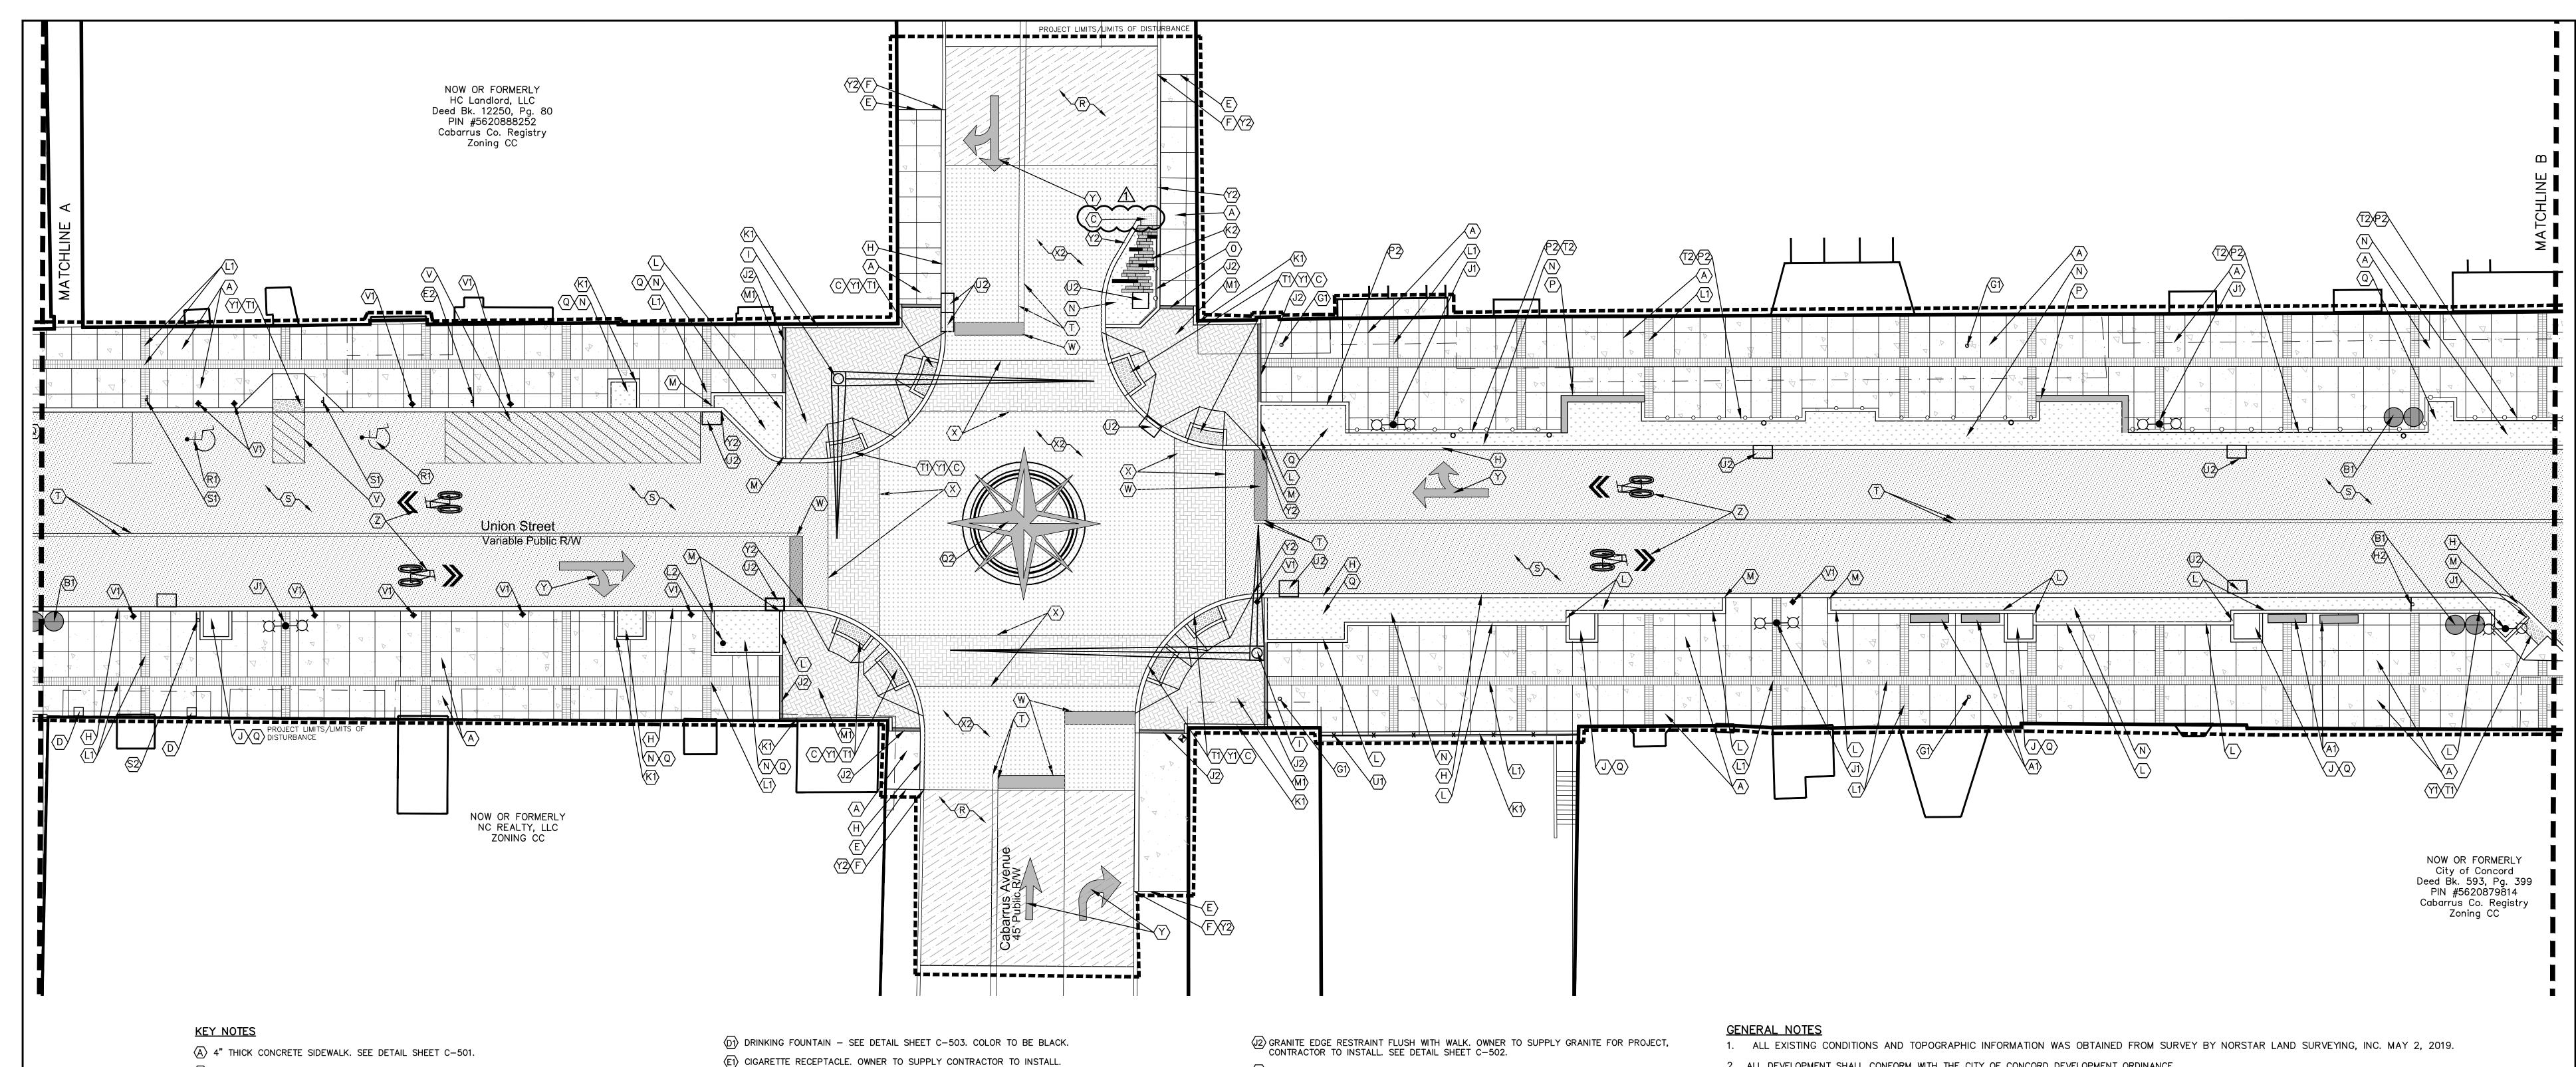

(B) TAPER CURB FLUSH WITH WALK.

C CONCRETE DRIVE APRON. GENERAL CONTRACTOR TO MATCH EXISTING ELEVATIONS AND ENSURE SMOOTH TRANSITION TO EXISTING DRIVES AND STREET. SEE CONCRETE SECTION DETAIL SHEET C-501.

(D) METAL AIR VENT GRATES TO MATCH EXISITNG. CONTRACTOR TO FIELD VERIFY DIMENSION OF EXISTING GRATES. PROVID ADA ACCESSIBLE GRATE.

(E) MATCH EXISTING SURFACE WITH SMOOTH TRANSITION, USE ISOLATION JOINT AT INTERFACE OF EXISTING AND PROPOSED SIDEWALKS AND VERTICAL SURFACES.

(F) TIE PROPOSED CURB TO EXISTING CURB AND/OR CURB AND GUTTER WITH SMOOTH TRANSITION. USE CONSTRUCTION JOINT AT INTERFACE OF EXISTING AND PROPOSED. TAPER PROPOSED CURB AS NECESSARY TO MATCH EXISTING TOP OF CURB.

(G) 30" CURB AND GUTTER. NOTE HEIGHT OF CURB VARIES. SEE GRADING PLAN. SEE DETAIL SHEET C-501.

(H) 8" STAND UP CURB. SEE DETAIL SHEET C-501.

(I) TRAFFIC SIGNAL INSTALLED BY OTHERS AFTER SURVEY WAS COMPLETED. CONTRACTOR TO FIELD VERIFY LOCATIONS AND NOTIFY ENGINEER/LANDSCAPE ARCHITECT IF LOCATIONS DIFFER FROM THOSE SHOWN ON PLANS. CONTRACTOR TO COORDINATE WITH CITY FOR INSTALLATION OF PEDESTRIAN HEADS TO BE INSTALLED DURING THE STREETSCAPE CONSTRUCTION...

(J) 4'X4' TREE GRATE AND FRAME WITH CONCRETE EDGE RESTRAINT. SEE DETAIL SHEET C-503.

 $\langle K \rangle$ EXISTING TREE TO BE PROTECTED.

(L) 3" CONCRETE LANDSCAPE EDGE WITH DRAINAGE SLOTS. SEE DETAIL SHEET C-501.

(M) TAPER LANDSCAPE EDGING FLUSH IN 6". ALL LANDSCAPE EDGING ADJOINING CURB AT ROADWAY SHOULD BE TAPERED FLUSH.

(N) LANDSCAPE AREA. SEE LANDSCAPE SHEETS L-101 TO L-106.

(O) ELECTRICAL PANEL AND DIGITAL DISPLAY. SEE ELECTRICAL SHEETS E101-E107.

P SEAT WALL. SEE DETAIL SHEET C-501

② SOIL CELLS. SEE SHEETS I-101 TO I-104 AND LANDSCAPE SHEETS L-101 TO L-106 FOR TREE LOCATIONS.

 $\langle \mathbb{R} \rangle$ variable asphalt overlay. See detail sheet C-501. S FULL DEPTH ASPHALT PAVING. SEE DETAIL SHEET C-501.

T 4" CENTER LINE, YELLOW THERMOPLASTIC PAINT, 120 MILS. SEE DETAIL SHEET C-506.

4" PAVEMENT STRIPE, WHITE THERMOPLASTIC PAINT, 120 MILS. SEE DETAIL SHEET C-506.

√ 4" PAVEMENT STRIPE, WHITE THERMOPLASTIC PAINT, 90 MILS (TYPICAL). SEE DETAIL SHEET C-506.

② 24" WIDE STOP BAR, WHITE THERMOPLASTIC PAINT, 120 MILS. EXTEND ACROSS LANE WIDTH. SEE DETAIL

STAMPED ASPHALT CROSSWALK WITH 8" WHITE THERMOPLASTIC STRIPE, 120 MILS. SEE DETAIL SHEET C-504. TRAFFIC ARROWS AND SYMBOLS, WHITE THERMOPLASTIC PAINT, 90 MILS. SEE DETAIL SHEET DETAIL SHEET

D BICYCLE SHARED LANE MARKINGS, WHITE THERMOPLASTIC PAINT, 90 MILS. SEE DETAIL SHEET C-503.

BENCH. OWNER TO PROVIDE AND CONTRACTOR TO INSTALL.

TRASH/RECYCLING RECEPTACLES. OWNER TO PROVIDE AND CONTRACTOR TO INSTALL.

C1) RELOCATED BIKE RACK.

(F1) BOLLARDS. SEE DETAIL SHEET C-501.

(G1) BRONZE CAROLINA THREAD TRAIL TRAIL MARKERS. TRAIL MARKERS TO BE MORTARED IN PLACE AND FLUSH WITH PROPOSED CONCRETE SIDEWALK. SEE DETAIL SHEET C-504.

BRONZE DOWNTOWN GREENWAY LOOP TRAIL MARKERS. TRAIL MARKERS TO BE MORTARED IN PLACE AND FLUSH WITH PROPOSED CONCRETE SIDEWALK. SEE DETAIL SHEET C-504.

(11) RELOCATED USPS/UPS/FEDEX BOX.

DETAIL SHEET C-502.

PROPOSED LIGHT POLE/LIGHTED BOLLARD. SEE ELECTRICAL SHEETS E-001 TO E-107.

(K1) 6" CONCRETE EDGE RESTRAINT, FLUSH WITH WALK. SEE DETAIL SHEET C-502.

BRICK BAND - PINEHALL BRICK PATHWAY RED. SEE DETAIL SHEET C-502.

MI) BRICK PAVERS - PINEHALL BRICK PATHWAY AUTUMN, HERRINGBONE PATTERN, HEAVY DUTY. SEE DETAIL

(N1) BRICK PAVERS - PINEHALL BRICK PATHWAY AUTUMN, HERRINGBONE PATTERN, LIGHT DUTY. SEE DETAIL

(01) PLAZA PAVERS, PINEHALL BRICK PATHWAY AUTUMN, HERRINGBONE PATTERN STREET SECTION. SEE

(P1) BRICK PAVER CROSSWALK WITH 8" CONCRETE EDGE RESTRAINT. 8" WHITE THERMOPLASTIC STRIPE, 120 MILS, PAVER TO BE PINEHALL BRICK PATHWAY RED. SEE DETAIL SHEET C-504.

(Q1) 18" CONCRETE GRADE BEAM. SEE DETAIL SHEET C-502.

(R1) HC PARKING. SEE DETAIL SHEET C-503.

(S1) HC PARKING SIGN. SEE DETAIL SHEET C-503. (T1) HC RAMP, LAYOUT OF RAMPS VARY. SEE DETAIL SHEET C-503.

(U1) WOOD FENCE. SEE DETAILS SHEET C-501.

(VI) FLAG HOLDER, 2" SCHEDULE 40 PVC SLEEVE SET IN CONCRETE. 6" DEPTH. SEE DETAIL SHEET C-506.

(WI) HORSE HOOKS, DECORATIVE HORSESHOES AND GRANITE PLAQUE. HORSESHOES TO BE SET FLUSH WITH PROPOSED CONCRETE SIDEWALK. SEE DETAIL SHEET C-506.

XI) STORMWATER TRENCH REPAIR. SEE DETAIL SHEET C-504.

(Y1) BRICK RED COMPOSITE DETECTABLE WARNING PLATE, SET IN CONCRETE. 6" CONCRETE BAND AROUND DOME INSET. SEE HANDICAP DETAIL SHEET C-503.

(Z1) CONCRETE STAIR WITH HANDRAIL. SEE DETAIL SHEET C-502.

(A2) CONCRETE STAIR AND RAMP STORE ENTRANCE ACCESS. SEE DETAIL SHEET C-502.

82 NO PARKING SIGN. SEE SIGN INSTALLATION DETAIL SHEET C-503.

RELOCATED WAYFINDING SIGN, SALVAGED REINSTALL. CONTRACTOR TO PROVIDE SIGNED AND SEALED STRUCTURAL DRAWINGS FOR FOOTING AND POLE INSTALLATION.

♦ STREET SIGN. SEE SIGN INSTALLATION DETAIL SHEET C-503.

(E2) LOADING ZONE SIGN. SEE SIGN INSTALLATION DETAIL SHEET C-503.

(F2) ADOPT A STREET SIGN. SEE SIGN INSTALLATION DETAIL SHEET C-503. © CONCORD HISTORIC DISTRICT SIGN. SEE SIGN INSTALLATION DETAIL SHEET C-503.

(H2) ORIGINAL CITY LIMIT SIGN. SEE SIGN INSTALLATION DETAIL SHEET C-503. $\langle 12 \rangle$ HISTORICAL SIGN. SEE SIGN INSTALLATION DETAIL SHEET C-503.

GRANITE STORMWATER FLUME. OWNER TO SUPPLY GRANITE FOR PROJECT, CONTRACTOR TO INSTALL. SEE DETAIL SHEET C-504.

PROPOSED FUTURE CLOCK, CLOCK NOT IN CONTRACT. SEE ELECTRICAL PLANS FOR CONDUIT LOCATIONS.

(M2) MOSAIC LIGHT STRUCTURES. SEE ELECTRICAL PLANS PROVIDED BY THE CITY.

(N2) GRANITE MARKER FOR ORIGINAL SURVEYORS STONE. SEE DETAIL SHEET C-506 ©2 CONCRETE EDGE RESTRAINT TO MATCH LOCATION AND WIDTH OF PROPOSED PLAZA CONCRETE BANDS. VERIFY LOCATION OF BANDS WITH CURRENT SET OF COURTHOUSE RENOVATION PLANS BY

KIMLEY HORN. PLANS TO BE PROVIDED BY THE CITY. MONOLITHIC RETAINING WALL WITH LANDSCAPE CURB OR METAL RAILING. SEE DETAIL SHEET C-506.

Q2 THERMOPLASTIC COMPASS SYMBOL, 120 MIL. SEE DETAIL SHEET C-506.

R2 HC RAMP WITH HANDRAILS. SEE DETAILS SHEET C-503.

\$2 PUBLIC PARKING DIRECTION SIGN. SEE DETAIL SHEET C-503.

 $\langle T2 \rangle$ 18" METAL RAILING/TREE GUARD TO BE PROVIDED BY THE OWNER AND CONTRACTOR INSTALLED. SEE DETAIL C-506.

(U2) STORMWATER STRUCTURE. SEE GRADING, DRAINAGE AND EROSION CONTROL PLANS.

(V2) RIGHT TURN PROHIBITED SIGN. SEE DETAIL SHEET C-503.

(w2) 6" STAND UP CURB. SEE DETAIL SHEET C-501.

(2) NCDOT ASPHALT PAVING. SEE DETAIL SHEET C-501. Y2 NCDOT 8" STAND UP CURB. SEE DETAIL SHEET C-501. 2. ALL DEVELOPMENT SHALL CONFORM WITH THE CITY OF CONCORD DEVELOPMENT ORDINANCE.

3. SITE SIGNAGE SHALL CONFORM WITH APPLICABLE CODES AND ORDINANCES.

4. ALL PAINT STRIPING, PAVEMENT MARKINGS, AND SIGNAGE SHALL CONFORM TO THE LATEST "MANUAL ON UNIFORM TRAFFIC CONTROL DEVICES" AND CITY OF CONCORD STANDARDS.

5. ALL DIMENSIONS ARE FACE OF CURB, EDGE OF PAVEMENT AND FACE OF WALL, UNLESS OTHERWISE NOTED.

6. THIS SITE IS NOT LOCATED IN ANY FLOOD ZONE.

7. ALL IMPROVEMENTS AND CONSTRUCTION SHALL BE IN ACCORDANCE WITH NORTH CAROLINA STATE STANDARDS. ALL IMPROVEMENTS SHALL COMPLY WITH THE CITY OF CONCORD STANDARDS FOR STORM DRAINAGE, SIGNAGE, LANDSCAPE, PLANTING, UTILITY AND PARKING REQUIREMENTS. 8. ANY DISCREPANCIES FOUND IN THE FIELD SHALL BE CALLED TO THE ATTENTION OF THE OWNER/ENGINEER/DESIGNER PRIOR TO PROCEEDING WITH

9. THE GENERAL CONTRACTOR SHALL CONTACT ALL OWNERS OF EASEMENTS, UTILITIES AND RIGHT OF WAYS, PUBLIC OR PRIVATE, PRIOR TO WORKING IN THESE AREAS.

10. HATCHING OF HARD SURFACE MATERIALS SUCH AS BRICK AND CONCRETE ARE FOR GENERAL INFORMATION PURPOSES. IN NO INSTANCE IS A UTILITY LID, COVER OR ACCESS POINT TO BE COVERED OVER AND CONCEALED BY THE PROPOSED SURFACE MATERIAL. ANY HIDDEN UTILITY BOXES, COVERS, ETC DISCOVERED DURING CONSTRUCTION SHALL BE ADJUSTED TO MATCH PROPOSED GRADE ELEVATIONS.

11. PROVIDE CONSTRUCTION JOINTS AT ALL INTERFACES BETWEEN PROPOSED AND EXISTING SURFACES/BUILDINGS. ALL CONSTRUCTION JOINTS ARE TO BE SEALED.


12. ENSURE SMOOTH TRANSITION FROM PROPOSED SIDEWALK TO ALL STORE FRONTS

13. ALL UTILITY BOXES AND TREE GRATES ARE TO BE ALIGNED WITH PROPOSED CONCRETE SCORING PATTERN.

14. NOTE LIMITS OF DISTURBANCE FOR STREETSCAPE WORK AND UTILITY INSTALLATION VARY. SEE EACH SET OF PLANS FOR LIMITS OF DISTURBANCE.

15. CONTRACTOR MUST PROVIDE SECURE, NON-SLIP ADA ACCESSIBLE SURFACES/STRUCTURES AND MAINTAIN ACCESS TO BUSINESSES DURING CONSTRUCTION.

16. CONTRACTOR TO PROVIDE MINIMUM OF FOUR PROJECT IDENTIFICATION SIGNS.

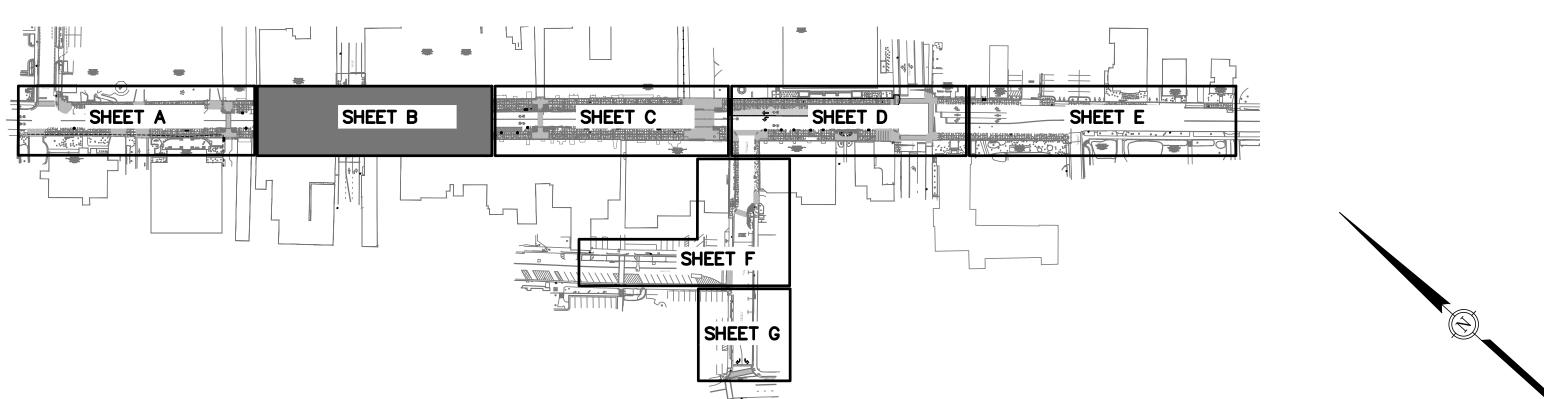




1	8/20/2021	KCD	ADDENDUM #1
NO.	DATE	BY	DESCRIPTION

UNION STREET IMPROVEMENTS CITY OF CONCORD CABARRUS COUNTY, NORTH CAROLINA

		δ				
10 0 5 10 20 GRAPHIC SCALE DIVISION VALUE = 10 FEET OFFICE MANAGER DESIGNER				SITE PLAN - B		
D.G. CHAPMAN C.L. CRANWILL						
	PROJECT MANAGER	REVIEWER	DATE	PROJECT#	FUNDING #	
M.J. NORRIS		B. ROARK	JULY 2021	19.01726	N/A	

SHEET

C-102

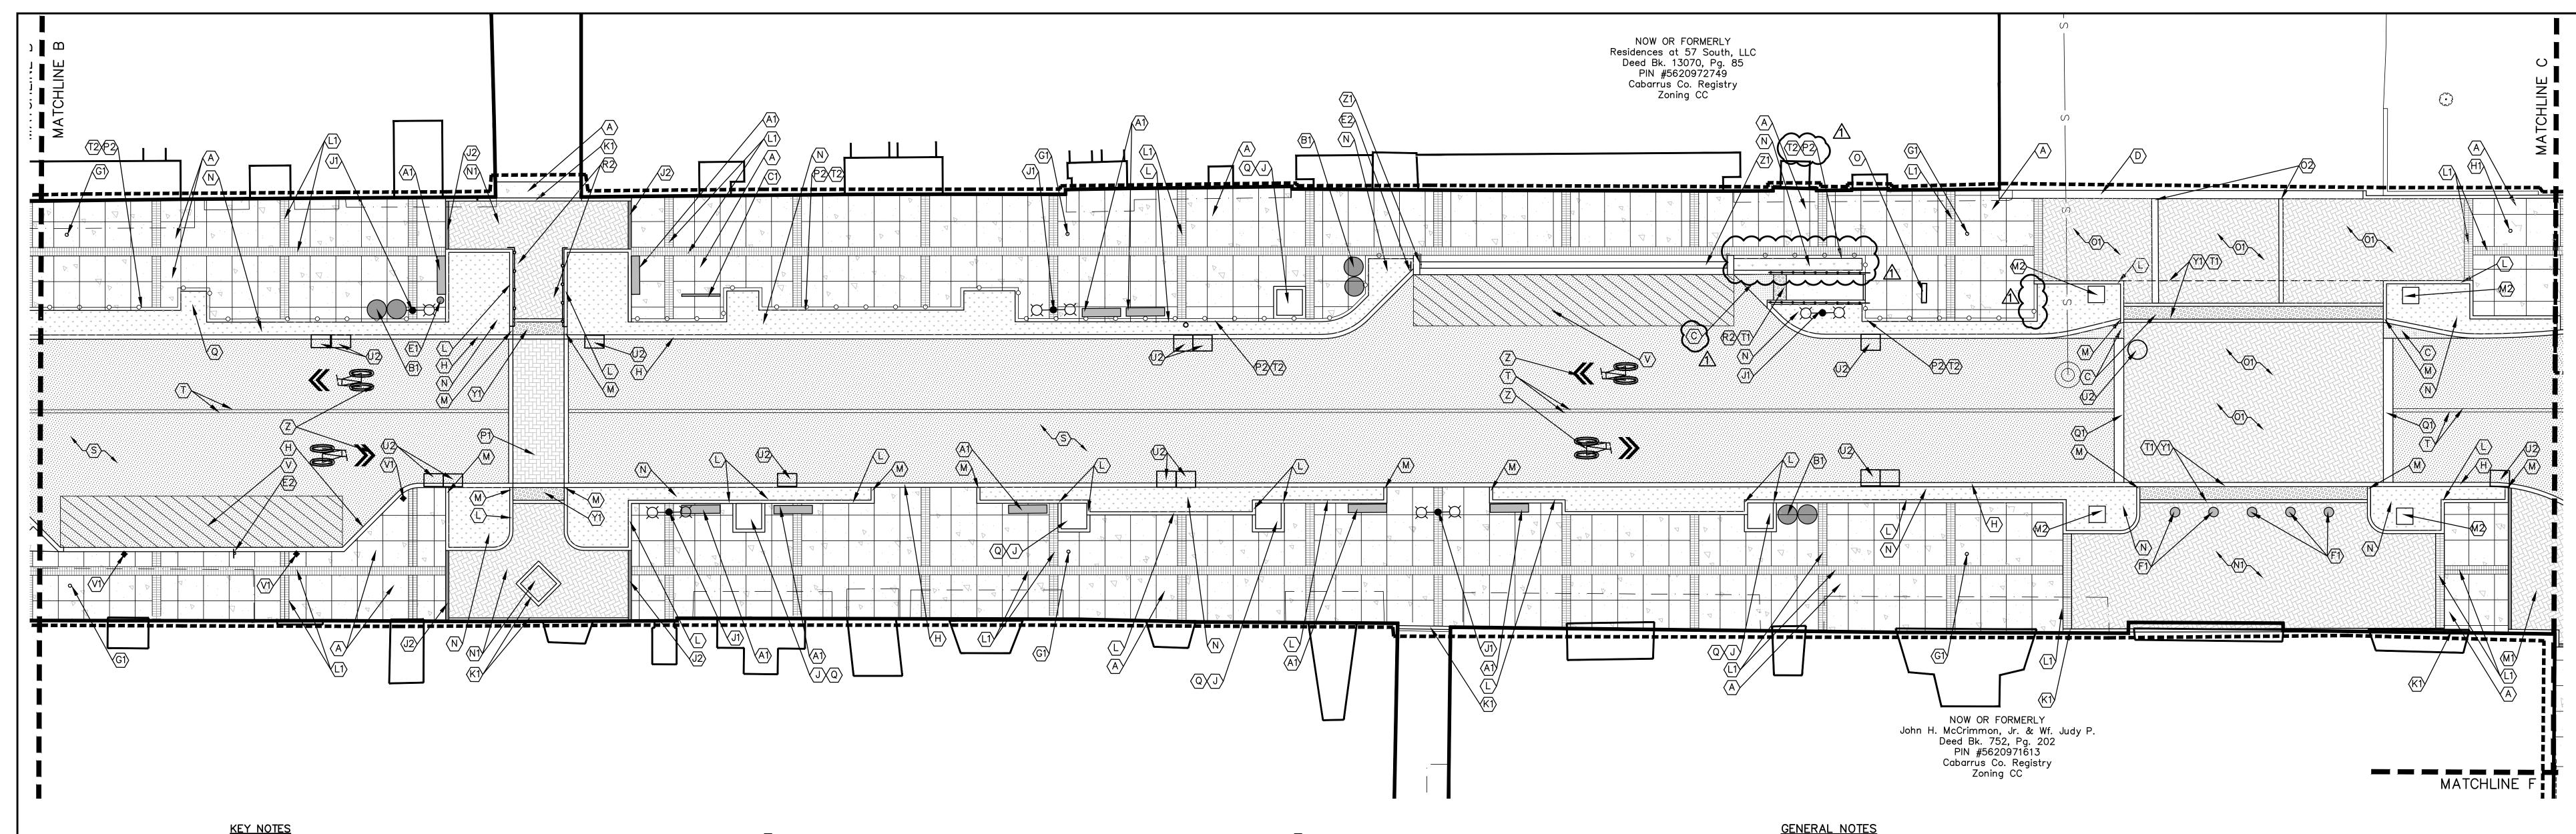

(A) 4" THICK CONCRETE SIDEWALK. SEE DETAIL SHEET C-501.

(B) TAPER CURB FLUSH WITH WALK.

⟨C⟩ CONCRETE DRIVE APRON. GENERAL CONTRACTOR TO MATCH EXISTING ELEVATIONS AND ENSURE SMOOTH TRANSITION TO EXISTING DRIVES AND STREET. SEE CONCRETE SECTION DETAIL SHEET C-501.

(D) METAL AIR VENT GRATES TO MATCH EXISITNG. CONTRACTOR TO FIELD VERIFY DIMENSION OF EXISTING GRATES. PROVID ADA ACCESSIBLE GRATE.

(E) MATCH EXISTING SURFACE WITH SMOOTH TRANSITION, USE ISOLATION JOINT AT INTERFACE OF EXISTING AND PROPOSED SIDEWALKS AND VERTICAL SURFACES.

(F) TIE PROPOSED CURB TO EXISTING CURB AND/OR CURB AND GUTTER WITH SMOOTH TRANSITION. USE CONSTRUCTION JOINT AT INTERFACE OF EXISTING AND PROPOSED. TAPER PROPOSED CURB AS NECESSARY TO MATCH EXISTING TOP OF CURB.

(G) 30" CURB AND GUTTER. NOTE HEIGHT OF CURB VARIES. SEE GRADING PLAN. SEE DETAIL SHEET C-501.

(H) 8" STAND UP CURB. SEE DETAIL SHEET C-501.

TRAFFIC SIGNAL INSTALLED BY OTHERS AFTER SURVEY WAS COMPLETED. CONTRACTOR TO FIELD VERIFY LOCATIONS AND NOTIFY ENGINEER/LANDSCAPE ARCHITECT IF LOCATIONS DIFFER FROM THOSE SHOWN ON PLANS. CONTRACTOR TO COORDINATE WITH CITY FOR INSTALLATION OF PEDESTRIAN HEADS TO BE INSTALLED DURING THE STREETSCAPE CONSTRUCTION..

(J) 4'X4' TREE GRATE AND FRAME WITH CONCRETE EDGE RESTRAINT. SEE DETAIL SHEET C-503.

(K) EXISTING TREE TO BE PROTECTED.

 $\langle L \rangle$ 3" CONCRETE LANDSCAPE EDGE WITH DRAINAGE SLOTS. SEE DETAIL SHEET C-501.

M TAPER LANDSCAPE EDGING FLUSH IN 6". ALL LANDSCAPE EDGING ADJOINING CURB AT ROADWAY SHOULD BE TAPERED FLUSH.

N LANDSCAPE AREA. SEE LANDSCAPE SHEETS L-101 TO L-106.

© ELECTRICAL PANEL AND DIGITAL DISPLAY. SEE ELECTRICAL SHEETS E101-E107.

P SEAT WALL. SEE DETAIL SHEET C-501

Q SOIL CELLS. SEE SHEETS I-101 TO I-104 AND LANDSCAPE SHEETS L-101 TO L-106 FOR TREE LOCATIONS.

R VARIABLE ASPHALT OVERLAY. SEE DETAIL SHEET C-501.

S FULL DEPTH ASPHALT PAVING. SEE DETAIL SHEET C-501.

T 4" CENTER LINE, YELLOW THERMOPLASTIC PAINT, 120 MILS. SEE DETAIL SHEET C-506.

4" PAVEMENT STRIPE, WHITE THERMOPLASTIC PAINT, 120 MILS. SEE DETAIL SHEET C-506.

 \bigcirc 4" PAVEMENT STRIPE, WHITE THERMOPLASTIC PAINT, 90 MILS (TYPICAL). SEE DETAIL SHEET C-506.

24" WIDE STOP BAR, WHITE THERMOPLASTIC PAINT, 120 MILS. EXTEND ACROSS LANE WIDTH. SEE DETAIL SHEET C-506.

STAMPED ASPHALT CROSSWALK WITH 8" WHITE THERMOPLASTIC STRIPE, 120 MILS. SEE DETAIL SHEET C-504. TRAFFIC ARROWS AND SYMBOLS, WHITE THERMOPLASTIC PAINT, 90 MILS. SEE DETAIL SHEET DETAIL SHEET

C-505. ☑ BICYCLE SHARED LANE MARKINGS, WHITE THERMOPLASTIC PAINT, 90 MILS. SEE DETAIL SHEET C-503.

(A) BENCH. OWNER TO PROVIDE AND CONTRACTOR TO INSTALL.

(B) TRASH/RECYCLING RECEPTACLES. OWNER TO PROVIDE AND CONTRACTOR TO INSTALL. © RELOCATED BIKE RACK.

(D1) DRINKING FOUNTAIN - SEE DETAIL SHEET C-503. COLOR TO BE BLACK.

(E1) CIGARETTE RECEPTACLE. OWNER TO SUPPLY CONTRACTOR TO INSTALL.

(F1) BOLLARDS. SEE DETAIL SHEET C-501.

(G1) BRONZE CAROLINA THREAD TRAIL TRAIL MARKERS. TRAIL MARKERS TO BE MORTARED IN PLACE AND FLUSH WITH PROPOSED CONCRETE SIDEWALK. SEE DETAIL SHEET C-504.

(H1) BRONZE DOWNTOWN GREENWAY LOOP TRAIL MARKERS. TRAIL MARKERS TO BE MORTARED IN PLACE AND FLUSH WITH PROPOSED CONCRETE SIDEWALK. SEE DETAIL SHEET C-504.

(11) RELOCATED USPS/UPS/FEDEX BOX.

SHEET C-502.

(J1) PROPOSED LIGHT POLE/LIGHTED BOLLARD. SEE ELECTRICAL SHEETS E-001 TO E-107.

6" CONCRETE EDGE RESTRAINT, FLUSH WITH WALK. SEE DETAIL SHEET C-502.

(L1) BRICK BAND - PINEHALL BRICK PATHWAY RED. SEE DETAIL SHEET C-502. (MI) BRICK PAVERS - PINEHALL BRICK PATHWAY AUTUMN, HERRINGBONE PATTERN, HEAVY DUTY. SEE DETAIL

SHEET C-502. (NI) BRICK PAVERS - PINEHALL BRICK PATHWAY AUTUMN, HERRINGBONE PATTERN, LIGHT DUTY. SEE DETAIL

(01) PLAZA PAVERS, PINEHALL BRICK PATHWAY AUTUMN, HERRINGBONE PATTERN STREET SECTION. SEE DETAIL SHEET C-502.

(P1) BRICK PAVER CROSSWALK WITH 8" CONCRETE EDGE RESTRAINT. 8" WHITE THERMOPLASTIC STRIPE, 120

MILS, PAVER TO BE PINEHALL BRICK PATHWAY RED. SEE DETAIL SHEET C-504.

(Q1) 18" CONCRETE GRADE BEAM. SEE DETAIL SHEET C-502.

(R1) HC PARKING. SEE DETAIL SHEET C-503.

(S1) HC PARKING SIGN. SEE DETAIL SHEET C-503.

(T1) HC RAMP, LAYOUT OF RAMPS VARY. SEE DETAIL SHEET C-503.

(U1) WOOD FENCE. SEE DETAILS SHEET C-501.

(V1) FLAG HOLDER, 2" SCHEDULE 40 PVC SLEEVE SET IN CONCRETE. 6" DEPTH. SEE DETAIL SHEET C-506. (WI) HORSE HOOKS, DECORATIVE HORSESHOES AND GRANITE PLAQUE. HORSESHOES TO BE SET FLUSH WITH

PROPOSED CONCRETE SIDEWALK. SEE DETAIL SHEET C-506.

DOME INSET. SEE HANDICAP DETAIL SHEET C-503.

X1) STORMWATER TRENCH REPAIR. SEE DETAIL SHEET C-504. (Y1) BRICK RED COMPOSITE DETECTABLE WARNING PLATE, SET IN CONCRETE. 6" CONCRETE BAND AROUND

(Z1) CONCRETE STAIR WITH HANDRAIL. SEE DETAIL SHEET C-502.

(A2) CONCRETE STAIR AND RAMP STORE ENTRANCE ACCESS. SEE DETAIL SHEET C-502.

(\$2) NO PARKING SIGN. SEE SIGN INSTALLATION DETAIL SHEET C-503.

© RELOCATED WAYFINDING SIGN, SALVAGED REINSTALL. CONTRACTOR TO PROVIDE SIGNED AND SEALED STRUCTURAL DRAWINGS FOR FOOTING AND POLE INSTALLATION.

(12) HISTORICAL SIGN. SEE SIGN INSTALLATION DETAIL SHEET C-503.

Ф2 STREET SIGN. SEE SIGN INSTALLATION DETAIL SHEET C-503. (E2) LOADING ZONE SIGN. SEE SIGN INSTALLATION DETAIL SHEET C-503.

(F2) ADOPT A STREET SIGN. SEE SIGN INSTALLATION DETAIL SHEET C-503.

© CONCORD HISTORIC DISTRICT SIGN. SEE SIGN INSTALLATION DETAIL SHEET C-503.

(H2) ORIGINAL CITY LIMIT SIGN. SEE SIGN INSTALLATION DETAIL SHEET C-503.

(J2) GRANITE EDGE RESTRAINT FLUSH WITH WALK. OWNER TO SUPPLY GRANITE FOR PROJECT, CONTRACTOR TO INSTALL. SEE DETAIL SHEET C-502.

(42) GRANITE STORMWATER FLUME. OWNER TO SUPPLY GRANITE FOR PROJECT, CONTRACTOR TO INSTALL. SEE DETAIL SHEET C-504.

(2) PROPOSED FUTURE CLOCK, CLOCK NOT IN CONTRACT. SEE ELECTRICAL PLANS FOR CONDUIT

(M2) MOSAIC LIGHT STRUCTURES. SEE ELECTRICAL PLANS PROVIDED BY THE CITY.

(N2) GRANITE MARKER FOR ORIGINAL SURVEYORS STONE. SEE DETAIL SHEET C-506 ⟨O2⟩ CONCRETE EDGE RESTRAINT TO MATCH LOCATION AND WIDTH OF PROPOSED PLAZA CONCRETE

BANDS. VERIFY LOCATION OF BANDS WITH CURRENT SET OF COURTHOUSE RENOVATION PLANS BY KIMLEY HORN. PLANS TO BE PROVIDED BY THE CITY.

MONOLITHIC RETAINING WALL WITH LANDSCAPE CURB OR METAL RAILING. SEE DETAIL SHEET

(2) THERMOPLASTIC COMPASS SYMBOL, 120 MIL. SEE DETAIL SHEET C-506.

R2) HC RAMP WITH HANDRAILS. SEE DETAILS SHEET C-503.

\$2 PUBLIC PARKING DIRECTION SIGN. SEE DETAIL SHEET C-503.

(12) 18" METAL RAILING/TREE GUARD TO BE PROVIDED BY THE OWNER AND CONTRACTOR INSTALLED. SEE DETAIL C-506.

(U2) STORMWATER STRUCTURE. SEE GRADING, DRAINAGE AND EROSION CONTROL PLANS.

⟨V2⟩ RIGHT TURN PROHIBITED SIGN. SEE DETAIL SHEET C-503.

(W2) 6" STAND UP CURB. SEE DETAIL SHEET C-501. ⟨x2⟩ NCDOT ASPHALT PAVING. SEE DETAIL SHEET C-501.

LOCATIONS.

Y2 NCDOT 8" STAND UP CURB. SEE DETAIL SHEET C-501.

GENERAL NOTES

1. ALL EXISTING CONDITIONS AND TOPOGRAPHIC INFORMATION WAS OBTAINED FROM SURVEY BY NORSTAR LAND SURVEYING, INC. MAY 2, 2019.

2. ALL DEVELOPMENT SHALL CONFORM WITH THE CITY OF CONCORD DEVELOPMENT ORDINANCE. 3. SITE SIGNAGE SHALL CONFORM WITH APPLICABLE CODES AND ORDINANCES.

4. ALL PAINT STRIPING, PAVEMENT MARKINGS, AND SIGNAGE SHALL CONFORM TO THE LATEST "MANUAL ON UNIFORM TRAFFIC CONTROL DEVICES" AND

CITY OF CONCORD STANDARDS.

5. ALL DIMENSIONS ARE FACE OF CURB, EDGE OF PAVEMENT AND FACE OF WALL, UNLESS OTHERWISE NOTED.

6. THIS SITE IS NOT LOCATED IN ANY FLOOD ZONE.

ALL IMPROVEMENTS AND CONSTRUCTION SHALL BE IN ACCORDANCE WITH NORTH CAROLINA STATE STANDARDS. ALL IMPROVEMENTS SHALL COMPLY WITH THE CITY OF CONCORD STANDARDS FOR STORM DRAINAGE, SIGNAGE, LANDSCAPE, PLANTING, UTILITY AND PARKING REQUIREMENTS.

8. ANY DISCREPANCIES FOUND IN THE FIELD SHALL BE CALLED TO THE ATTENTION OF THE OWNER/ENGINEER/DESIGNER PRIOR TO PROCEEDING WITH

9. THE GENERAL CONTRACTOR SHALL CONTACT ALL OWNERS OF EASEMENTS, UTILITIES AND RIGHT OF WAYS, PUBLIC OR PRIVATE, PRIOR TO WORKING IN THESE AREAS.

10. HATCHING OF HARD SURFACE MATERIALS SUCH AS BRICK AND CONCRETE ARE FOR GENERAL INFORMATION PURPOSES. IN NO INSTANCE IS A UTILITY LID, COVER OR ACCESS POINT TO BE COVERED OVER AND CONCEALED BY THE PROPOSED SURFACE MATERIAL. ANY HIDDEN UTILITY BOXES, COVERS, ETC DISCOVERED DURING CONSTRUCTION SHALL BE ADJUSTED TO MATCH PROPOSED GRADE ELEVATIONS.

11. PROVIDE CONSTRUCTION JOINTS AT ALL INTERFACES BETWEEN PROPOSED AND EXISTING SURFACES/BUILDINGS. ALL CONSTRUCTION JOINTS ARE TO BE SEALED.


12. ENSURE SMOOTH TRANSITION FROM PROPOSED SIDEWALK TO ALL STORE FRONTS

ALL UTILITY BOXES AND TREE GRATES ARE TO BE ALIGNED WITH PROPOSED CONCRETE SCORING PATTERN.


14. NOTE LIMITS OF DISTURBANCE FOR STREETSCAPE WORK AND UTILITY INSTALLATION VARY. SEE EACH SET OF PLANS FOR LIMITS OF DISTURBANCE.

15. CONTRACTOR MUST PROVIDE SECURE, NON-SLIP ADA ACCESSIBLE SURFACES/STRUCTURES AND MAINTAIN ACCESS TO BUSINESSES DURING CONSTRUCTION.

16. CONTRACTOR TO PROVIDE MINIMUM OF FOUR PROJECT IDENTIFICATION SIGNS.

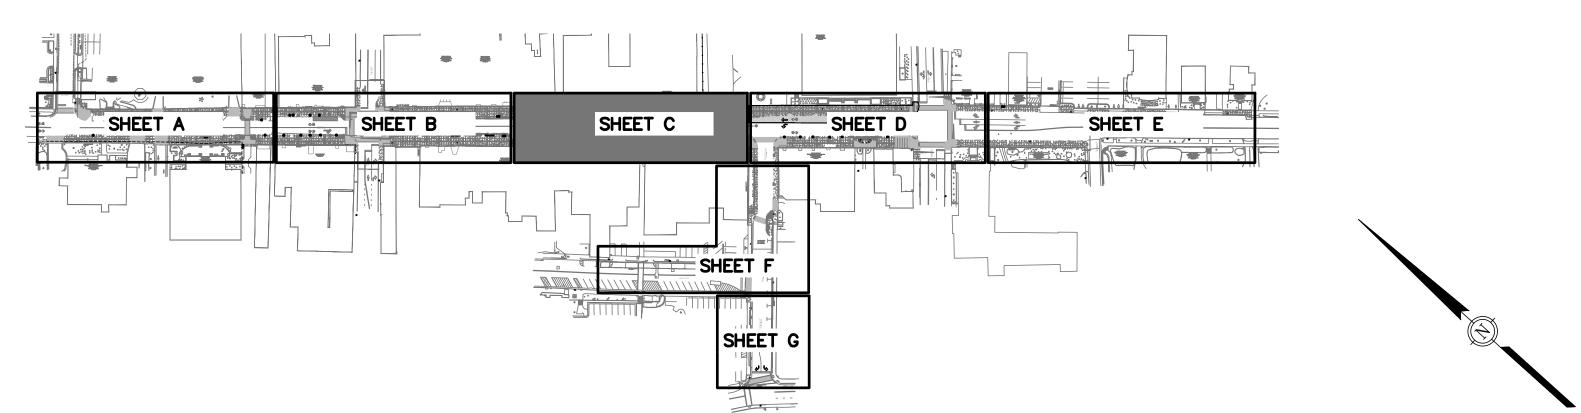



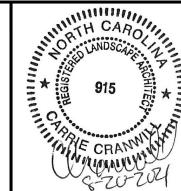


1	8/20/2021	KCD	ADDENDUM #1	
				UNIC
				CABARR
NO.	DATE	BY	DESCRIPTION	

ION STREET IMPROVEMENTS TY OF CONCORD RUS COUNTY, NORTH CAROLINA

SITE PLAN - C D.G. CHAPMAN C.L. CRANWILL B. ROARK M.J. NORRIS JULY 2021 19.01726

SHEET

C-103

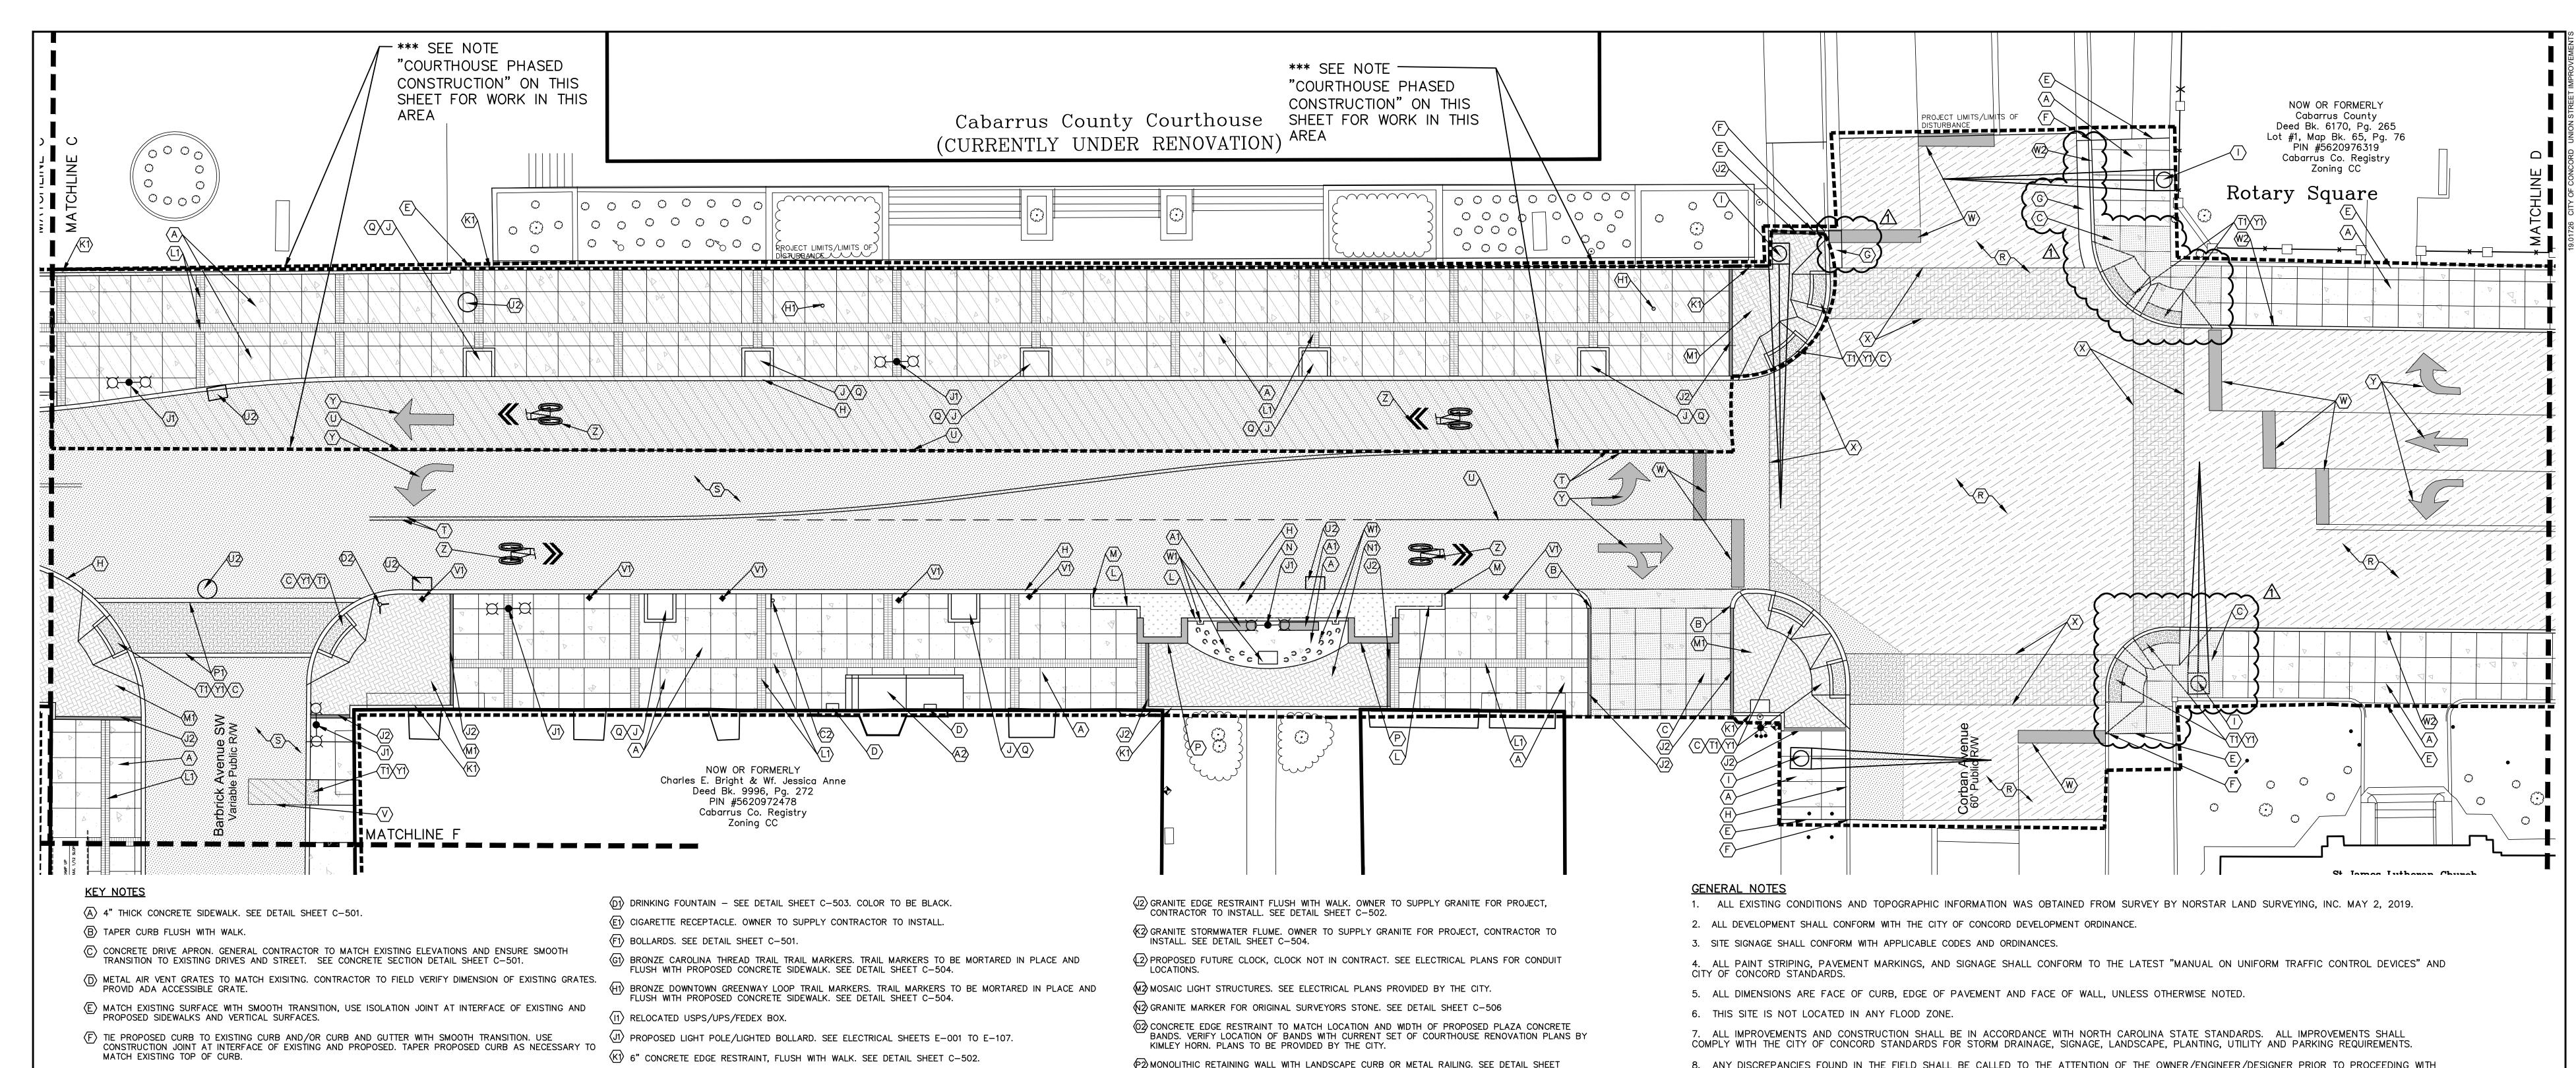

- (G) 30" CURB AND GUTTER. NOTE HEIGHT OF CURB VARIES. SEE GRADING PLAN. SEE DETAIL SHEET C-501. (H) 8" STAND UP CURB. SEE DETAIL SHEET C-501.
- (1) TRAFFIC SIGNAL INSTALLED BY OTHERS AFTER SURVEY WAS COMPLETED. CONTRACTOR TO FIELD VERIFY LOCATIONS AND NOTIFY ENGINEER/LANDSCAPE ARCHITECT IF LOCATIONS DIFFER FROM THOSE SHOWN ON PLANS. CONTRACTOR TO COORDINATE WITH CITY FOR INSTALLATION OF PEDESTRIAN HEADS TO BE INSTALLED DURING THE STREETSCAPE CONSTRUCTION..
- (J) 4'X4' TREE GRATE AND FRAME WITH CONCRETE EDGE RESTRAINT. SEE DETAIL SHEET C-503.
- (K) EXISTING TREE TO BE PROTECTED.
- (L) 3" CONCRETE LANDSCAPE EDGE WITH DRAINAGE SLOTS. SEE DETAIL SHEET C-501.
- M TAPER LANDSCAPE EDGING FLUSH IN 6". ALL LANDSCAPE EDGING ADJOINING CURB AT ROADWAY SHOULD BE
- (N) LANDSCAPE AREA. SEE LANDSCAPE SHEETS L-101 TO L-106.
- (O) ELECTRICAL PANEL AND DIGITAL DISPLAY. SEE ELECTRICAL SHEETS E101-E107.
- (P) SEAT WALL. SEE DETAIL SHEET C-501
- SOIL CELLS. SEE SHEETS I-101 TO I-104 AND LANDSCAPE SHEETS L-101 TO L-106 FOR TREE LOCATIONS.
- (R) VARIABLE ASPHALT OVERLAY. SEE DETAIL SHEET C-501.
- S FULL DEPTH ASPHALT PAVING. SEE DETAIL SHEET C-501.
- (T) 4" CENTER LINE, YELLOW THERMOPLASTIC PAINT, 120 MILS. SEE DETAIL SHEET C-506.
- 4" PAVEMENT STRIPE, WHITE THERMOPLASTIC PAINT, 120 MILS. SEE DETAIL SHEET C-506.
- ⟨V⟩ 4" PAVEMENT STRIPE, WHITE THERMOPLASTIC PAINT, 90 MILS (TYPICAL). SEE DETAIL SHEET C-506.

W 24" WIDE STOP BAR, WHITE THERMOPLASTIC PAINT, 120 MILS. EXTEND ACROSS LANE WIDTH. SEE DETAIL

- ⟨X⟩ STAMPED ASPHALT CROSSWALK WITH 8" WHITE THERMOPLASTIC STRIPE, 120 MILS. SEE DETAIL SHEET C-504.
- TRAFFIC ARROWS AND SYMBOLS, WHITE THERMOPLASTIC PAINT, 90 MILS. SEE DETAIL SHEET DETAIL SHEET
- BICYCLE SHARED LANE MARKINGS, WHITE THERMOPLASTIC PAINT, 90 MILS. SEE DETAIL SHEET C-503.
- (A) BENCH. OWNER TO PROVIDE AND CONTRACTOR TO INSTALL.
- (B1) TRASH/RECYCLING RECEPTACLES. OWNER TO PROVIDE AND CONTRACTOR TO INSTALL. ©1) RELOCATED BIKE RACK.

SHEET C-506.

- BRICK BAND PINEHALL BRICK PATHWAY RED. SEE DETAIL SHEET C-502.
- M) BRICK PAVERS PINEHALL BRICK PATHWAY AUTUMN, HERRINGBONE PATTERN, HEAVY DUTY. SEE DETAIL
- 🕪 BRICK PAVERS PINEHALL BRICK PATHWAY AUTUMN, HERRINGBONE PATTERN, LIGHT DUTY. SEE DETAIL
- (01) PLAZA PAVERS, PINEHALL BRICK PATHWAY AUTUMN, HERRINGBONE PATTERN STREET SECTION. SEE DETAIL SHEET C-502.
- (P1) BRICK PAVER CROSSWALK WITH 8" CONCRETE EDGE RESTRAINT. 8" WHITE THERMOPLASTIC STRIPE, 120
- MILS, PAVER TO BE PINEHALL BRICK PATHWAY RED. SEE DETAIL SHEET C-504. (Q1) 18" CONCRETE GRADE BEAM. SEE DETAIL SHEET C-502.
- (R1) HC PARKING. SEE DETAIL SHEET C-503.
- $\langle S1 \rangle$ HC PARKING SIGN. SEE DETAIL SHEET C-503.
- (T1) HC RAMP, LAYOUT OF RAMPS VARY. SEE DETAIL SHEET C-503.
- (U1) WOOD FENCE. SEE DETAILS SHEET C-501.
- ⟨VI⟩ FLAG HOLDER, 2" SCHEDULE 40 PVC SLEEVE SET IN CONCRETE. 6" DEPTH. SEE DETAIL SHEET C-506. (WI) HORSE HOOKS, DECORATIVE HORSESHOES AND GRANITE PLAQUE. HORSESHOES TO BE SET FLUSH WITH PROPOSED CONCRETE SIDEWALK. SEE DETAIL SHEET C-506.
- $\langle X1 \rangle$ STORMWATER TRENCH REPAIR. SEE DETAIL SHEET C-504.
- (Y1) BRICK RED COMPOSITE DETECTABLE WARNING PLATE, SET IN CONCRETE. 6" CONCRETE BAND AROUND DOME INSET. SEE HANDICAP DETAIL SHEET C-503.
- (Z1) CONCRETE STAIR WITH HANDRAIL. SEE DETAIL SHEET C-502.
- (A2) CONCRETE STAIR AND RAMP STORE ENTRANCE ACCESS. SEE DETAIL SHEET C-502.
- (2) NO PARKING SIGN. SEE SIGN INSTALLATION DETAIL SHEET C-503.
- ©2 RELOCATED WAYFINDING SIGN, SALVAGED REINSTALL. CONTRACTOR TO PROVIDE SIGNED AND SEALED STRUCTURAL DRAWINGS FOR FOOTING AND POLE INSTALLATION.
- (D2) STREET SIGN. SEE SIGN INSTALLATION DETAIL SHEET C-503.
- (E2) LOADING ZONE SIGN. SEE SIGN INSTALLATION DETAIL SHEET C-503.
- (F2) ADOPT A STREET SIGN. SEE SIGN INSTALLATION DETAIL SHEET C-503. © CONCORD HISTORIC DISTRICT SIGN. SEE SIGN INSTALLATION DETAIL SHEET C-503.
- \langle 12 \rangle HISTORICAL SIGN. SEE SIGN INSTALLATION DETAIL SHEET C-503.

(P2) MONOLITHIC RETAINING WALL WITH LANDSCAPE CURB OR METAL RAILING. SEE DETAIL SHEET

(Q2) THERMOPLASTIC COMPASS SYMBOL, 120 MIL. SEE DETAIL SHEET C-506.

(R2) HC RAMP WITH HANDRAILS. SEE DETAILS SHEET C-503.

\$2 PUBLIC PARKING DIRECTION SIGN. SEE DETAIL SHEET C-503.

18" METAL RAILING/TREE GUARD TO BE PROVIDED BY THE OWNER AND CONTRACTOR INSTALLED. SEE DETAIL C-506.

(U2) STORMWATER STRUCTURE. SEE GRADING, DRAINAGE AND EROSION CONTROL PLANS.

⟨V2⟩ RIGHT TURN PROHIBITED SIGN. SEE DETAIL SHEET C-503.

(W2) 6" STAND UP CURB. SEE DETAIL SHEET C-501 ⟨x2⟩ NCDOT ASPHALT PAVING. SEE DETAIL SHEET C-501.


Y2 NCDOT 8" STAND UP CURB. SEE DETAIL SHEET C-501.

- 8. ANY DISCREPANCIES FOUND IN THE FIELD SHALL BE CALLED TO THE ATTENTION OF THE OWNER/ENGINEER/DESIGNER PRIOR TO PROCEEDING WITH
- 9. THE GENERAL CONTRACTOR SHALL CONTACT ALL OWNERS OF EASEMENTS, UTILITIES AND RIGHT OF WAYS, PUBLIC OR PRIVATE, PRIOR TO WORKING IN THESE AREAS.
- 10. HATCHING OF HARD SURFACE MATERIALS SUCH AS BRICK AND CONCRETE ARE FOR GENERAL INFORMATION PURPOSES. IN NO INSTANCE IS A UTILITY LID, COVER OR ACCESS POINT TO BE COVERED OVER AND CONCEALED BY THE PROPOSED SURFACE MATERIAL. ANY HIDDEN UTILITY BOXES, COVERS, ETC DISCOVERED DURING CONSTRUCTION SHALL BE ADJUSTED TO MATCH PROPOSED GRADE ELEVATIONS.
- 11. PROVIDE CONSTRUCTION JOINTS AT ALL INTERFACES BETWEEN PROPOSED AND EXISTING SURFACES/BUILDINGS. ALL CONSTRUCTION JOINTS ARE TO BE SEALED.
- 12. ENSURE SMOOTH TRANSITION FROM PROPOSED SIDEWALK TO ALL STORE FRONTS
- 13. ALL UTILITY BOXES AND TREE GRATES ARE TO BE ALIGNED WITH PROPOSED CONCRETE SCORING PATTERN.
- 14. NOTE LIMITS OF DISTURBANCE FOR STREETSCAPE WORK AND UTILITY INSTALLATION VARY. SEE EACH SET OF PLANS FOR LIMITS OF DISTURBANCE.
- 15. CONTRACTOR MUST PROVIDE SECURE, NON-SLIP ADA ACCESSIBLE SURFACES/STRUCTURES AND MAINTAIN ACCESS TO BUSINESSES DURING CONSTRUCTION.
- 16. CONTRACTOR TO PROVIDE MINIMUM OF FOUR PROJECT IDENTIFICATION SIGNS.

COURTHOUSE PHASED CONSTRUCTION:

DUE TO THE RENOVATION OF THE COURTHOUSE, ONLY PART OF THE ILLUSTRATED CONSTRUCTION ACTIVITIES WILL BE INSTALLED UNDER THIS CONTRACT. THE REMAINING ITEMS WILL BE INSTALLED UNDER SEPARATE CONTRACT AFTER THE COMPLETION OF THE COURTHOUSE RENOVATION IN 2024. ITEMS UNDER THIS CONTRACT INCLUDE: COMPREHENSIVE GRADING, ELECTRICAL DEMOLITION, ASPHALT PAVING, STRIPING, TEMPORARY CONCRETE SIDEWALK, HC RAMPS, TACTILE PLATES, STORMWATER INSTALLATION, AND WATER LINES AS NOTED ON THE UTILITY SHEET. THIS AREA IS TO BE GRADED TO PROPOSED ELEVATIONS AND THE

GRADES TAPERED DOWN TO MEET EXISTING ELEVATIONS AT THE COURTHOUSE STEPS. EXISTING DRAINAGE STRUCTURES TO BE UTILIZED FOR DRAINAGE FOR TEMPORARY PAVING SEE DETAIL SHEET C-510.

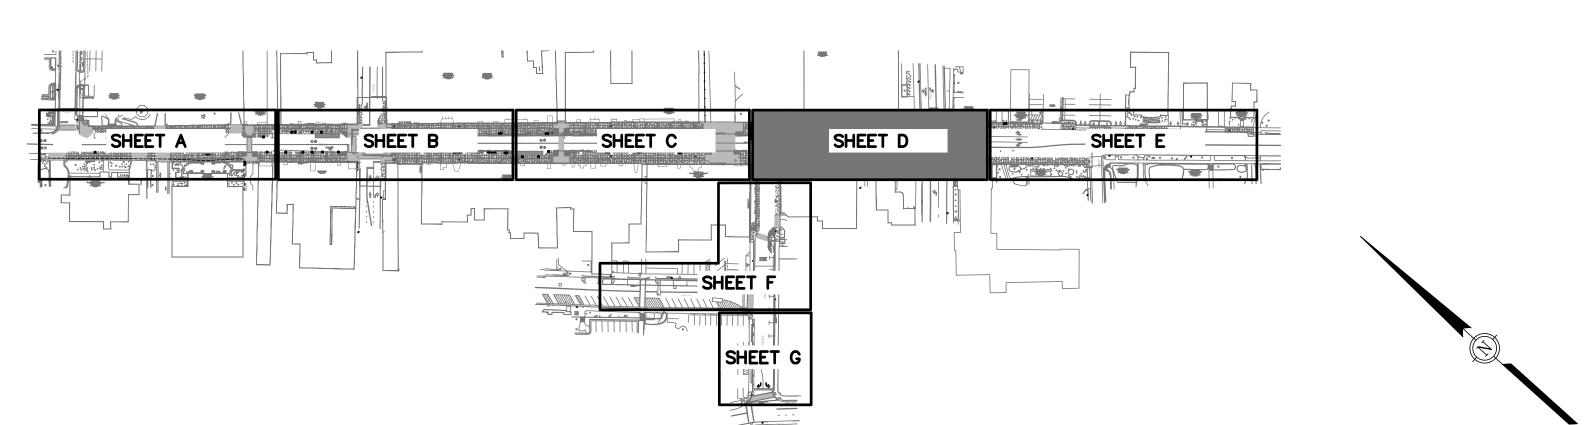




MILLIAM	1	8/20/2021	KCD	ADDENDUM #1
H CARO				
ANT DE				
915 ×				
y s				
THE THE PARTY OF T				
CRANN				
8-20-204	NO.	DATE	BY	DESCRIPTION
•				

UNION STREET IMPROVEMENTS CITY OF CONCORD CABARRUS COUNTY, NORTH CAROLINA

SITE PLAN - D D.G. CHAPMAN C.L. CRANWILL B. ROARK M.J. NORRIS JULY 2021 19.01726 N/A

SHEET

C-104

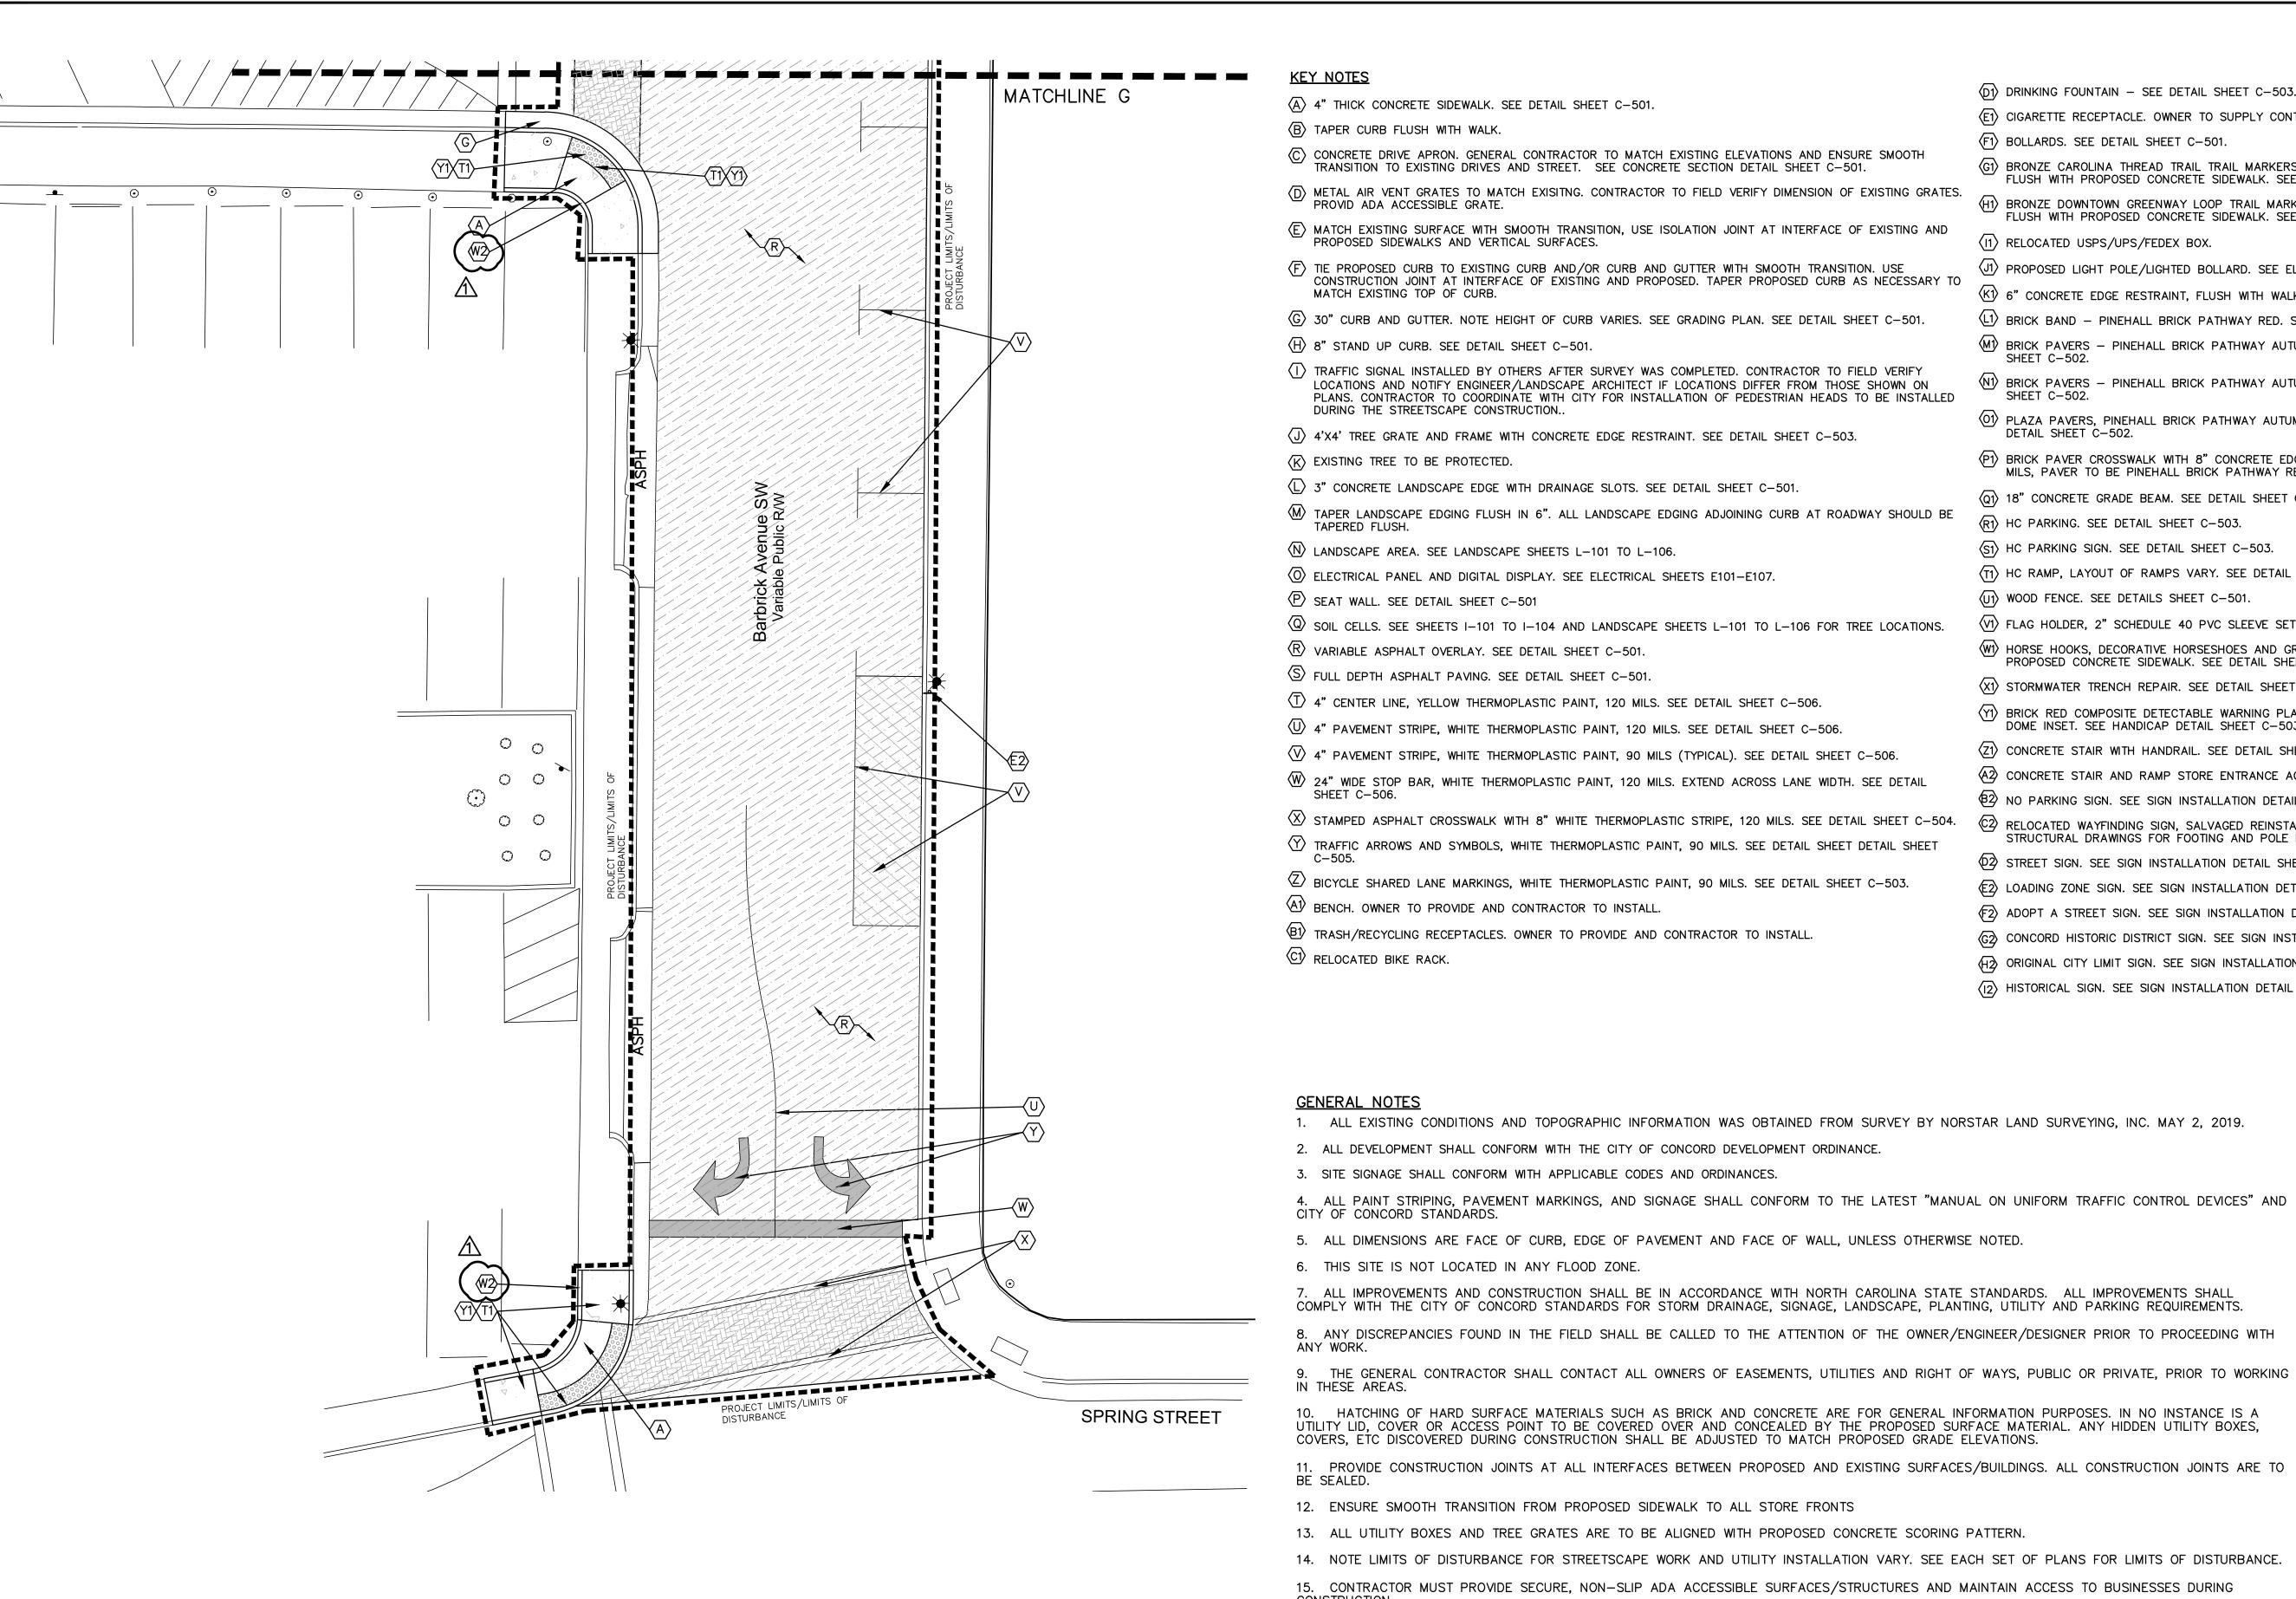

- $\langle A \rangle$ 4" THICK CONCRETE SIDEWALK. SEE DETAIL SHEET C-501.
- (B) TAPER CURB FLUSH WITH WALK.
- © CONCRETE DRIVE APRON. GENERAL CONTRACTOR TO MATCH EXISTING ELEVATIONS AND ENSURE SMOOTH TRANSITION TO EXISTING DRIVES AND STREET. SEE CONCRETE SECTION DETAIL SHEET C-501.
- (D) METAL AIR VENT GRATES TO MATCH EXISITNG. CONTRACTOR TO FIELD VERIFY DIMENSION OF EXISTING GRATES. PROVID ADA ACCESSIBLE GRATE.
- (E) MATCH EXISTING SURFACE WITH SMOOTH TRANSITION, USE ISOLATION JOINT AT INTERFACE OF EXISTING AND PROPOSED SIDEWALKS AND VERTICAL SURFACES.
- F TIE PROPOSED CURB TO EXISTING CURB AND/OR CURB AND GUTTER WITH SMOOTH TRANSITION. USE
- CONSTRUCTION JOINT AT INTERFACE OF EXISTING AND PROPOSED. TAPER PROPOSED CURB AS NECESSARY TO MATCH EXISTING TOP OF CURB.
- ⑤ 30" CURB AND GUTTER. NOTE HEIGHT OF CURB VARIES. SEE GRADING PLAN. SEE DETAIL SHEET C-501. (H) 8" STAND UP CURB. SEE DETAIL SHEET C-501.
- (T) TRAFFIC SIGNAL INSTALLED BY OTHERS AFTER SURVEY WAS COMPLETED. CONTRACTOR TO FIELD VERIFY LOCATIONS AND NOTIFY ENGINEER/LANDSCAPE ARCHITECT IF LOCATIONS DIFFER FROM THOSE SHOWN ON PLANS. CONTRACTOR TO COORDINATE WITH CITY FOR INSTALLATION OF PEDESTRIAN HEADS TO BE INSTALLED DURING THE STREETSCAPE CONSTRUCTION..
- $\langle J \rangle$ 4'X4' TREE GRATE AND FRAME WITH CONCRETE EDGE RESTRAINT. SEE DETAIL SHEET C-503.
- (K) EXISTING TREE TO BE PROTECTED.
- 3" CONCRETE LANDSCAPE EDGE WITH DRAINAGE SLOTS. SEE DETAIL SHEET C-501.
- (M) TAPER LANDSCAPE EDGING FLUSH IN 6". ALL LANDSCAPE EDGING ADJOINING CURB AT ROADWAY SHOULD BE TAPERED FLUSH.
- N LANDSCAPE AREA. SEE LANDSCAPE SHEETS L-101 TO L-106.
- © ELECTRICAL PANEL AND DIGITAL DISPLAY. SEE ELECTRICAL SHEETS E101-E107.
- (P) SEAT WALL. SEE DETAIL SHEET C-501
- ② SOIL CELLS. SEE SHEETS I-101 TO I-104 AND LANDSCAPE SHEETS L-101 TO L-106 FOR TREE LOCATIONS.
- R VARIABLE ASPHALT OVERLAY. SEE DETAIL SHEET C-501.
- S FULL DEPTH ASPHALT PAVING. SEE DETAIL SHEET C-501.
- T 4" CENTER LINE, YELLOW THERMOPLASTIC PAINT, 120 MILS. SEE DETAIL SHEET C-506.
- 4" PAVEMENT STRIPE, WHITE THERMOPLASTIC PAINT, 120 MILS. SEE DETAIL SHEET C-506. \bigcirc 4" PAVEMENT STRIPE, WHITE THERMOPLASTIC PAINT, 90 MILS (TYPICAL). SEE DETAIL SHEET C-506.
- W 24" WIDE STOP BAR, WHITE THERMOPLASTIC PAINT, 120 MILS. EXTEND ACROSS LANE WIDTH. SEE DETAIL
- SHEET C-506. STAMPED ASPHALT CROSSWALK WITH 8" WHITE THERMOPLASTIC STRIPE, 120 MILS. SEE DETAIL SHEET C-504.
- TRAFFIC ARROWS AND SYMBOLS, WHITE THERMOPLASTIC PAINT, 90 MILS. SEE DETAIL SHEET DETAIL SHEET
- ☑ BICYCLE SHARED LANE MARKINGS, WHITE THERMOPLASTIC PAINT, 90 MILS. SEE DETAIL SHEET C-503.
- (A) BENCH. OWNER TO PROVIDE AND CONTRACTOR TO INSTALL.
- (B1) TRASH/RECYCLING RECEPTACLES. OWNER TO PROVIDE AND CONTRACTOR TO INSTALL.

16. CONTRACTOR TO PROVIDE MINIMUM OF FOUR PROJECT IDENTIFICATION SIGNS.


©1) RELOCATED BIKE RACK.

- \langle D1angle DRINKING FOUNTAIN SEE DETAIL SHEET C-503. COLOR TO BE BLACK.
- (E1) CIGARETTE RECEPTACLE. OWNER TO SUPPLY CONTRACTOR TO INSTALL
- (F1) BOLLARDS. SEE DETAIL SHEET C-501.
- (G1) BRONZE CAROLINA THREAD TRAIL TRAIL MARKERS. TRAIL MARKERS TO BE MORTARED IN PLACE AND FLUSH WITH PROPOSED CONCRETE SIDEWALK. SEE DETAIL SHEET C-504.
- BRONZE DOWNTOWN GREENWAY LOOP TRAIL MARKERS. TRAIL MARKERS TO BE MORTARED IN PLACE AND FLUSH WITH PROPOSED CONCRETE SIDEWALK. SEE DETAIL SHEET C-504.
- (1) RELOCATED USPS/UPS/FEDEX BOX.
- PROPOSED LIGHT POLE/LIGHTED BOLLARD. SEE ELECTRICAL SHEETS E-001 TO E-107.
- 6" CONCRETE EDGE RESTRAINT, FLUSH WITH WALK. SEE DETAIL SHEET C-502.
- (L1) BRICK BAND PINEHALL BRICK PATHWAY RED. SEE DETAIL SHEET C-502. (MI) BRICK PAVERS - PINEHALL BRICK PATHWAY AUTUMN, HERRINGBONE PATTERN, HEAVY DUTY. SEE DETAIL
- SHEET C-502. BRICK PAVERS - PINEHALL BRICK PATHWAY AUTUMN, HERRINGBONE PATTERN, LIGHT DUTY. SEE DETAIL
- SHEET C-502.
- (01) PLAZA PAVERS, PINEHALL BRICK PATHWAY AUTUMN, HERRINGBONE PATTERN STREET SECTION. SEE DETAIL SHEET C-502.
- (P1) BRICK PAVER CROSSWALK WITH 8" CONCRETE EDGE RESTRAINT. 8" WHITE THERMOPLASTIC STRIPE, 120 MILS, PAVER TO BE PINEHALL BRICK PATHWAY RED. SEE DETAIL SHEET C-504.
- (Q1) 18" CONCRETE GRADE BEAM. SEE DETAIL SHEET C-502.
- \langle R1angle HC PARKING. SEE DETAIL SHEET C-503.
- $\langle S1 \rangle$ HC PARKING SIGN. SEE DETAIL SHEET C-503.
- (T1) HC RAMP, LAYOUT OF RAMPS VARY. SEE DETAIL SHEET C-503.
- (U1) WOOD FENCE. SEE DETAILS SHEET C-501.
- (V1) FLAG HOLDER, 2" SCHEDULE 40 PVC SLEEVE SET IN CONCRETE. 6" DEPTH. SEE DETAIL SHEET C-506.
- (W1) HORSE HOOKS, DECORATIVE HORSESHOES AND GRANITE PLAQUE. HORSESHOES TO BE SET FLUSH WITH PROPOSED CONCRETE SIDEWALK. SEE DETAIL SHEET C-506.
- (X1) STORMWATER TRENCH REPAIR. SEE DETAIL SHEET C-504.
- BRICK RED COMPOSITE DETECTABLE WARNING PLATE, SET IN CONCRETE. 6" CONCRETE BAND AROUND DOME INSET. SEE HANDICAP DETAIL SHEET C-503.
- (Z1) CONCRETE STAIR WITH HANDRAIL. SEE DETAIL SHEET C-502.
- (A2) CONCRETE STAIR AND RAMP STORE ENTRANCE ACCESS. SEE DETAIL SHEET C-502.
- (B2) NO PARKING SIGN. SEE SIGN INSTALLATION DETAIL SHEET C-503.
- © RELOCATED WAYFINDING SIGN, SALVAGED REINSTALL. CONTRACTOR TO PROVIDE SIGNED AND SEALED STRUCTURAL DRAWINGS FOR FOOTING AND POLE INSTALLATION.
- \$\\\phi\$\rightarrow\$ STREET SIGN. SEE SIGN INSTALLATION DETAIL SHEET C-503.
- (2) LOADING ZONE SIGN. SEE SIGN INSTALLATION DETAIL SHEET C-503.
- (F2) ADOPT A STREET SIGN. SEE SIGN INSTALLATION DETAIL SHEET C-503.
- © CONCORD HISTORIC DISTRICT SIGN. SEE SIGN INSTALLATION DETAIL SHEET C-503.
- (H2) ORIGINAL CITY LIMIT SIGN. SEE SIGN INSTALLATION DETAIL SHEET C-503. (12) HISTORICAL SIGN. SEE SIGN INSTALLATION DETAIL SHEET C-503.

- (J2) GRANITE EDGE RESTRAINT FLUSH WITH WALK. OWNER TO SUPPLY GRANITE FOR PROJECT, CONTRACTOR TO INSTALL. SEE DETAIL SHEET C-502.
- GRANITE STORMWATER FLUME. OWNER TO SUPPLY GRANITE FOR PROJECT, CONTRACTOR TO INSTALL. SEE DETAIL SHEET C-504.
- (2) PROPOSED FUTURE CLOCK, CLOCK NOT IN CONTRACT. SEE ELECTRICAL PLANS FOR CONDUIT LOCATIONS.
- M2 MOSAIC LIGHT STRUCTURES. SEE ELECTRICAL PLANS PROVIDED BY THE CITY.
- (N2) GRANITE MARKER FOR ORIGINAL SURVEYORS STONE. SEE DETAIL SHEET C-506 © CONCRETE EDGE RESTRAINT TO MATCH LOCATION AND WIDTH OF PROPOSED PLAZA CONCRETE BANDS. VERIFY LOCATION OF BANDS WITH CURRENT SET OF COURTHOUSE RENOVATION PLANS BY
- (P2) MONOLITHIC RETAINING WALL WITH LANDSCAPE CURB OR METAL RAILING. SEE DETAIL SHEET
- (2) THERMOPLASTIC COMPASS SYMBOL, 120 MIL. SEE DETAIL SHEET C-506.
- R2 HC RAMP WITH HANDRAILS. SEE DETAILS SHEET C-503.

KIMLEY HORN. PLANS TO BE PROVIDED BY THE CITY.

- \$2 PUBLIC PARKING DIRECTION SIGN. SEE DETAIL SHEET C-503.
- 18" METAL RAILING/TREE GUARD TO BE PROVIDED BY THE OWNER AND CONTRACTOR INSTALLED. SEE DETAIL C-506.
- (U2) STORMWATER STRUCTURE. SEE GRADING, DRAINAGE AND EROSION CONTROL PLANS.
- ⟨V2⟩ RIGHT TURN PROHIBITED SIGN. SEE DETAIL SHEET C-503.
- (W2) 6" STAND UP CURB. SEE DETAIL SHEET C-501.
- (2) NCDOT ASPHALT PAVING. SEE DETAIL SHEET C-501. Y2 NCDOT 8" STAND UP CURB. SEE DETAIL SHEET C-501.

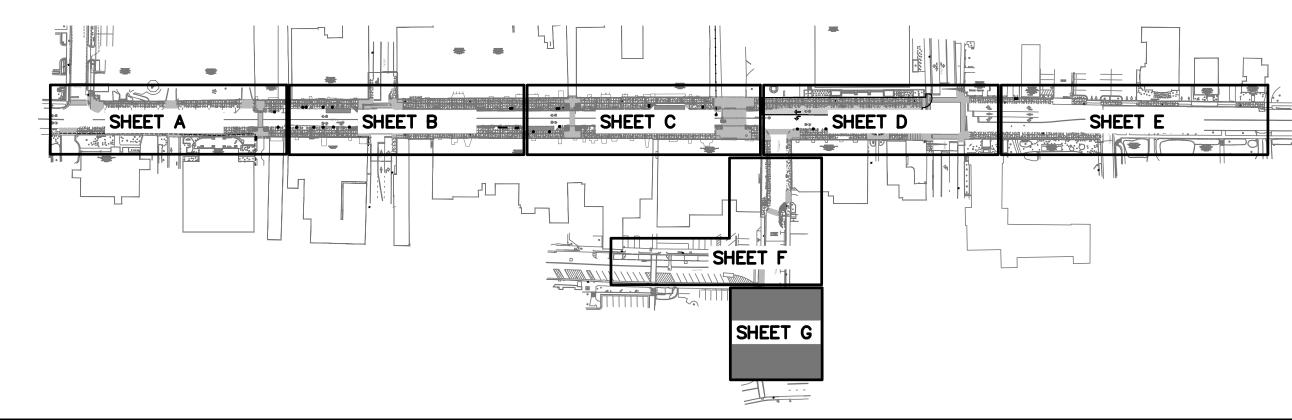






NO. DATE


UNION STREET IMPROVEMENTS CITY OF CONCORD CABARRUS COUNTY, NORTH CAROLINA

SITE PLAN - G D.G. CHAPMAN C.L. CRANWILL B. ROARK JULY 2021 19.01726 M.J. NORRIS

C-107

SHEET

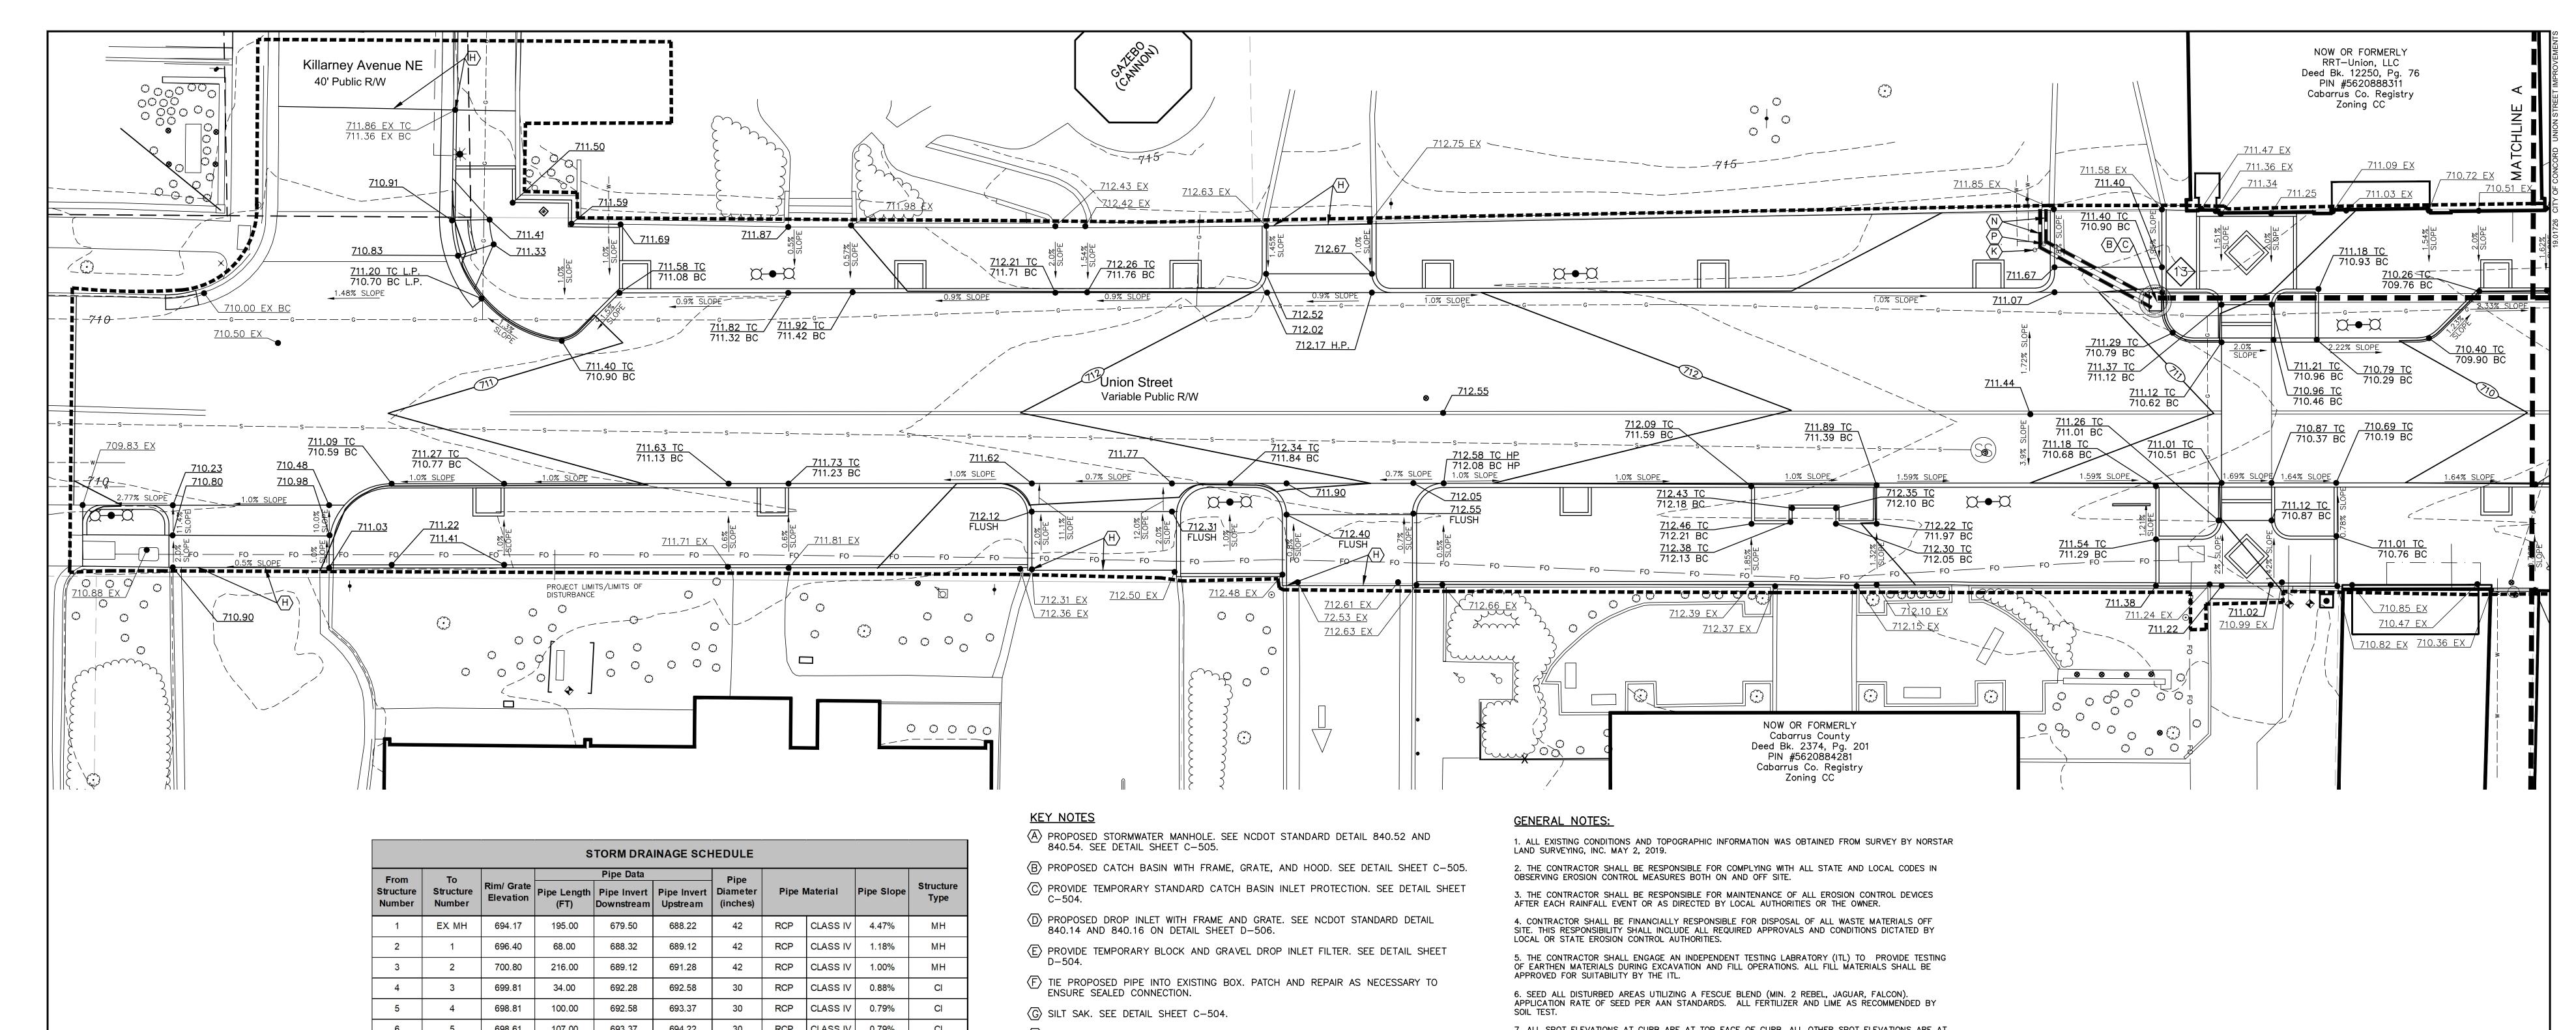

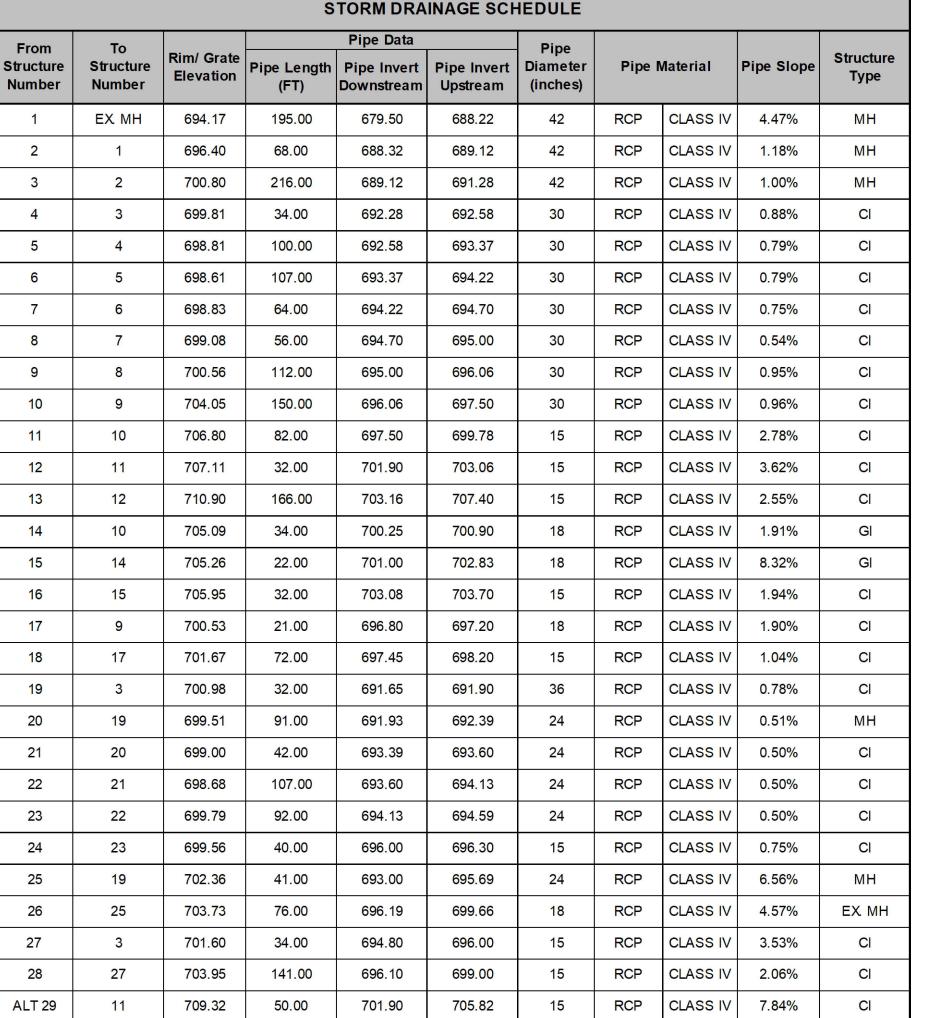

(H) MATCH EXISTING GRADE WITH SMOOTH TRANSITION.

- PROPOSED 6" SCHEDULE 40 PVC.
- (J) CONNECT PROPOSED BOX TO EX. PIPE. VERIFY INVERTS OF EXISTING PIPE PRIOR TO BOX INSTALLATION.
- K PROPOSED 3" ROOF DRAIN CLEANOUT. SEE DETAIL SHEET C-504.
- PROPOSED 8" SCHEDULE 40 PVC ROOF DRAIN TO DAYLIGHT AT WALL LOCATION SHOWN. PROVIDE 2" AIR GAP BETWEEN PIPE EXIT AND TOP OF 10" NYOPLAST DRAIN. CONNECT 10" DROP IN DRAIN TO PROPOSED BOX AS SHOWN, MIN. SLOPE 2%. PROVIDE CLEANOUTS AS SHOWN.
- ⟨M⟩ SEDIMENT WATTLE. SEE DETAILS SHEET C-504.
- PROPOSED 3" AND 6" SCHEDULE 40 PVC DRAINS FROM EXISTING UTILITY BOX TO TIE TO PROPOSED STORM STRUCTURE.
- PROPOSED 3" SCHEDULE 40 PVC ROOF DRAIN TO DAYLIGHT AT WALL LOCATION SHOWN. PROVIDE 2" AIR GAP BETWEEN PIPE EXIT AND TOP OF 6" DROP IN NYOPLAST DRAIN. CONNECT 6" DROP IN DRAINS TO PROPOSED BOX WITH 6" SCHEDULE 40 PVC AS SHOWN, MIN SLOPE 2%. PROVIDE CLEANOUTS AS SHOWN.
- ⟨P⟩ PROPOSED 6" ROOF DRAIN CLEANOUT. SEE DETAIL SHEET C-504.
- PROPOSED 8" ROOF DRAIN CLEANOUT. SEE DETAIL SHEET C-504.
- (R) PROPOSED 3" SCHEDULE 40 PVC ROOF DRAIN TO DAYLIGHT TO CURB. PROVIDE CLEANOUTS AS SHOWN.
- (S) ADD ALTERNATE #1 CATCH BASIN WITH FRAME, GRATE, AND HOOD. SEE DETAIL SHEET C-505.
- T ADD ALTERNATE #1 15" CLASS IV RCP.
- (U) ADD ALTERNATE #1 PROVIDE TEMPORARY STANDARD CATCH BASIN INLET PROTECTION. SEE DETAIL SHEET C-504.

RELOCATED AS NECESSARY TO ACTIVE CONSTRUCTION AREAS.

- $\langle \overline{\mathsf{V}} \rangle$ mud mat to be installed as temporary construction entrance and
- PROVIDE 3" SCHEDULE 40 PVC ROOF DRAIN TO CONNECT TO PROPOSED MANHOLE AT MIN.1% SLOPE. CONTRACTOR TO REMOVE EX. 3" PIPE TO BUILDING FACE AND REDIRECT FOR MANHOLE CONNECTION. LOCATION SHOWN IS APPROXIMATE. NOT FROM SURVEY.
- PROVIDE 4" SCHEDULE 40 PVC ROOF DRAIN TO CONNECT TO PROPOSED MANHOLE AT MIN.1% SLOPE. CONTRACTOR TO REMOVE ENOUGH EXISTING CONCRETE AROUND END OF PIPE AS NECESSARY TO INSTALL ELBOW FOR CONNECTION TO STORMWATER MANHOLE PIPE. INSTALL ELBOW SO THAT THERE IS NO CONFLICT WITH PROPOSED SIDEWALK. PROVIDE CLEANOUTS AS SHOWN.
- PROVIDE 6" SCHEDULE 40 PVC ROOF DRAIN TO CONNECT TO PROPOSED MANHOLE AT MIN.1% SLOPE.

6. SEED ALL DISTURBED AREAS UTILIZING A FESCUE BLEND (MIN. 2 REBEL, JAGUAR, FALCON).
APPLICATION RATE OF SEED PER AAN STANDARDS. ALL FERTILIZER AND LIME AS RECOMMENDED BY SOIL TEST.

7. ALL SPOT ELEVATIONS AT CURB ARE AT TOP FACE OF CURB. ALL OTHER SPOT ELEVATIONS ARE AT SLAB GRADE OR AS INDICATED.

8. ALL OPEN STORM DRAIN PIPES SHALL BE PROTECTED WITH STONE FILTER PROTECTION AFTER STOPPAGE OF WORK EACH DAY. SEE DETAIL SHEET C-504.

10. CONTRACTOR TO INSTALL SILK SAK EROSION PROTECTION AS SHOWN ON THE DRAWINGS AND ON THE FIRST DOWNSTREAM INLET STRUCTURES OUTSIDE OF THE PROJECT AREA RECEIVING RUNOFF FROM THE ACTIVE CONSTRUCTION AREA. AS WORK IS PHASED, CONTRACTOR TO UTILIZE WATTLES AS APPLICABLE AROUND THE OPEN WORK AREA TO DISCHARGE THE STORM WATER. DEWATERING BAGS/SEDIMENT FILTER BAGS MAY BE USED TO FILETER STORMWATER FROM TRENCHING ACTIVITIES. UNDER NO CIRCUMSTANCE IS UNTREATED WATER TO BE RELEASED FROM THE WORK AREA WITHOUT PASSING THROUGH AN EROSION CONTROL DEVICE.

9. CONTRACTOR TO ENSURE POSITIVE DRAINAGE ON ALL SURFACES. NOTIFY ENGINEER/LANDSCAPE

ARCHITECT PRIOR TO INSTALLATION OF ANY PAVING/SURFACES IF ON SITE CONDITIONS ARE FIELD

11. PROJECT IS BID UNCLASSIFIED.

LEGEND PROJECT LIMITS SEDIMENT WATTLE INLET PROTECTION

DETERMINED NOT TO PROVIDE POSITIVE DRAINAGE.

SITE DATA RIVER BASI

RIVER BASIN: YADKIN — PEE DEE RIVER RECEIVING WATER: IRISH BUFFALO CREEK

PROJECT LIMITS/DISTURBED ACREAGE: 3.32 ACRES. PERMITTED DISTURBED AREA: 3.5 ACRES.

MUNICIPALITY: CITY OF CONCORD


TW TOP OF WALL

5 STORMWATER STRUCTURE ID

BOTTOM OF WALL

TOP OF CURB

BOTTOM OF CURB

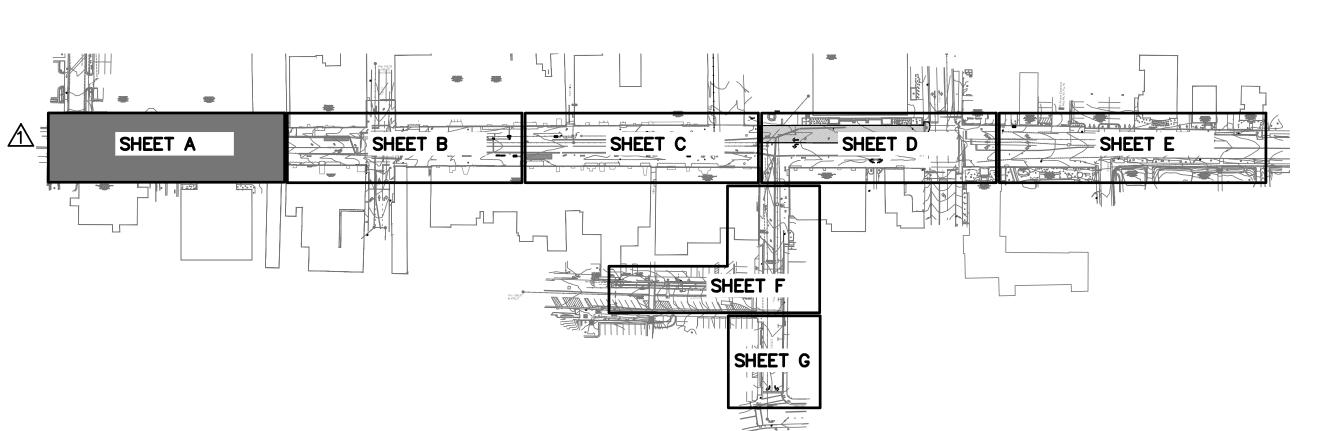





1	8/20/2021	KCD	ADDENDUM #1	
NO.	DATE	BY	DESCRIPTION	


UNION STREET IMPROVEMENTS
CITY OF CONCORD

CABARRUS COUNTY, NORTH CAROLINA

	4 6				
10 0 GRAPHIC SCALE	5 10 20 DIVISION VALUE = 10 FEET		DING, DRAINAO	•	
FFICE MANAGER	DESIGNER]			
D.G. CHAPMAN	C.L. CRANWILL				
ROJECT MANAGER	REVIEWER	DATE	PROJECT#	FUNDING #	
M.J. NORRIS	B. ROARK	JULY 2021	19.01726	N/A	


C-201


SHEET

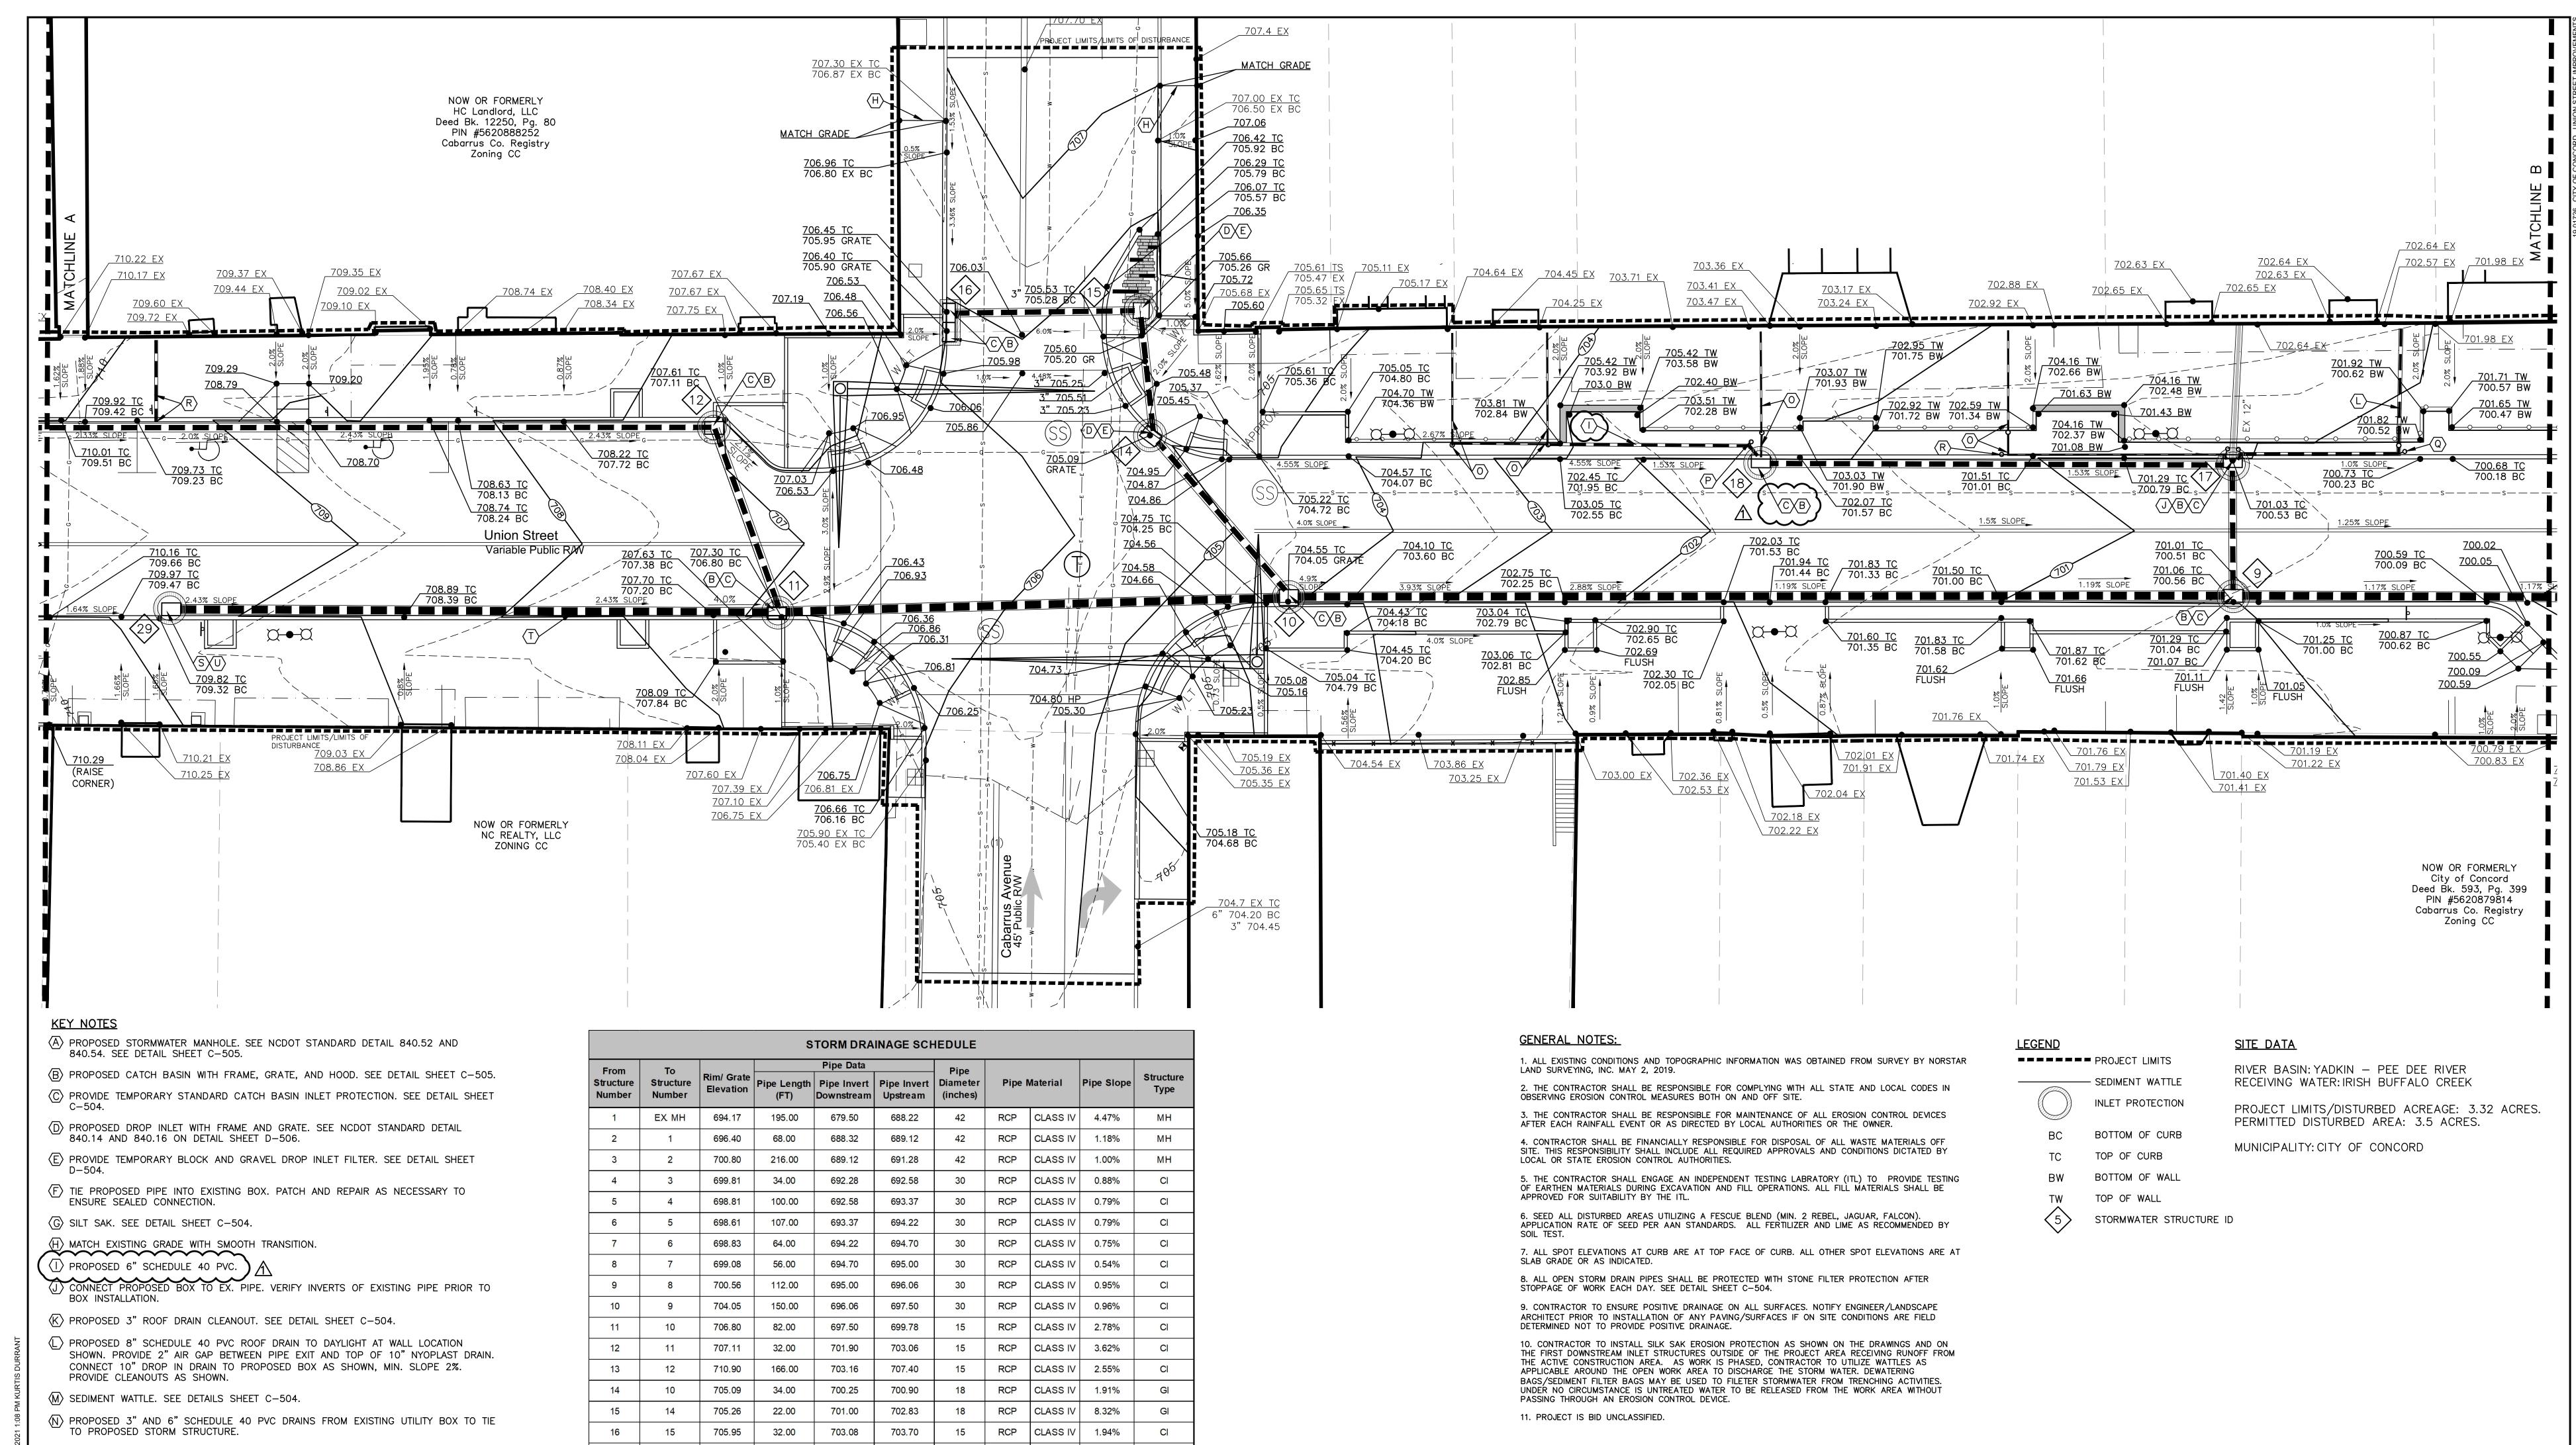

700.53 21.00 696.80 RCP 1.90% 701.67 72.00 697.45 RCP CLASS IV 698.20 700.98 32.00 691.65 RCP CLASS IV 0.50% 696.00 RCP CLASS IV 0.75% 23 699.56 40.00 696.30 RCP CLASS IV 6.56% 702.36 41.00 693.00 695.69 RCP CLASS IV 4.57% 26 703.73 76.00 696.19 699.66 EX MH RCP CLASS IV 27 701.60 34.00 694.80 3.53% RCP CLASS IV 2.06% 28 703.95 141.00 696.10

SHEET B SHEET C SHEET E SHEET D SHEET A

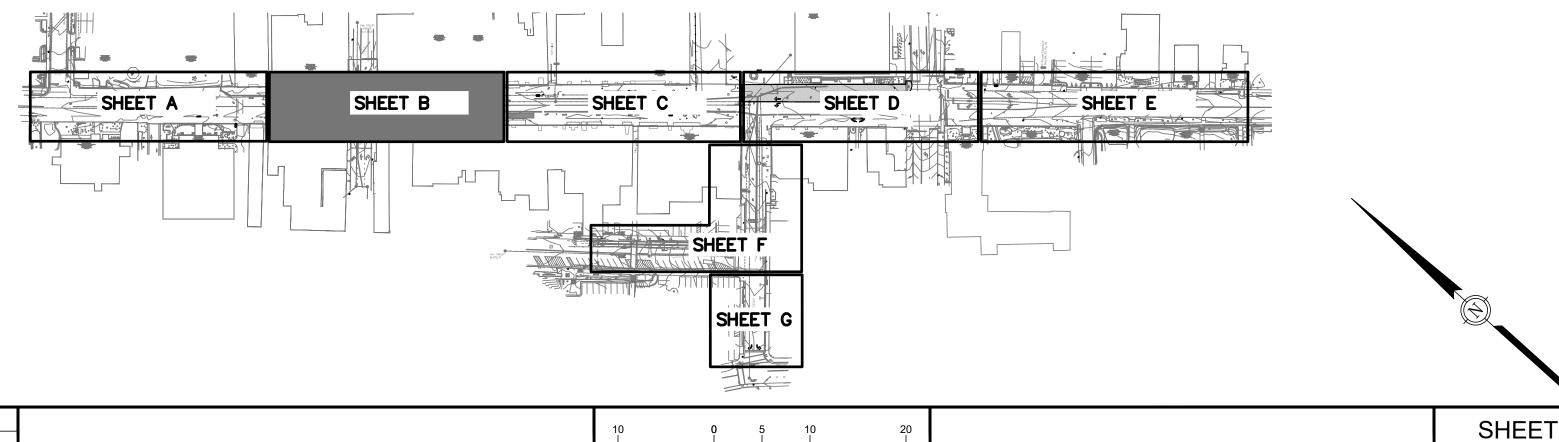

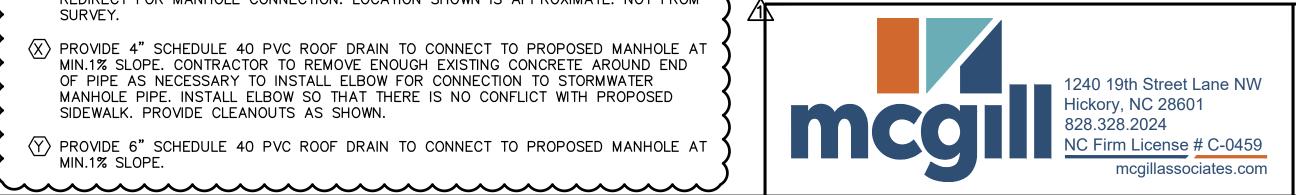

709.32

50.00

701.90

ALT 29

(O) PROPOSED 3" SCHEDULE 40 PVC ROOF DRAIN TO DAYLIGHT AT WALL LOCATION

SHOWN. PROVIDE 2" AIR GAP BETWEEN PIPE EXIT AND TOP OF 6" DROP IN

NYOPLAST DRAIN. CONNECT 6" DROP IN DRAINS TO PROPOSED BOX WITH 6" SCHEDULE 40 PVC AS SHOWN, MIN SLOPE 2%. PROVIDE CLEANOUTS AS SHOWN.

R PROPOSED 3" SCHEDULE 40 PVC ROOF DRAIN TO DAYLIGHT TO CURB. PROVIDE

(S) ADD ALTERNATE #1 CATCH BASIN WITH FRAME, GRATE, AND HOOD. SEE DETAIL

(V) MUD MAT TO BE INSTALLED AS TEMPORARY CONSTRUCTION ENTRANCE AND

RELOCATED AS NECESSARY TO ACTIVE CONSTRUCTION AREAS.

(U) ADD ALTERNATE #1 PROVIDE TEMPORARY STANDARD CATCH BASIN INLET PROTECTION.

W PROVIDE 3" SCHEDULE 40 PVC ROOF DRAIN TO CONNECT TO PROPOSED MANHOLE AT MIN.1% SLOPE. CONTRACTOR TO REMOVE EX. 3" PIPE TO BUILDING FACE AND

REDIRECT FOR MANHOLE CONNECTION. LOCATION SHOWN IS APPROXIMATE. NOT FROM

MIN.1% SLOPE. CONTRACTOR TO REMOVE ENOUGH EXISTING CONCRETE AROUND END OF PIPE AS NECESSARY TO INSTALL ELBOW FOR CONNECTION TO STORMWATER

MANHOLE PIPE. INSTALL ELBOW SO THAT THERE IS NO CONFLICT WITH PROPOSED

Y PROVIDE 6" SCHEDULE 40 PVC ROOF DRAIN TO CONNECT TO PROPOSED MANHOLE AT

P PROPOSED 6" ROOF DRAIN CLEANOUT. SEE DETAIL SHEET C-504.

 $\langle \overline{\mathbb{Q}} \rangle$ PROPOSED 8" ROOF DRAIN CLEANOUT. SEE DETAIL SHEET C-504.


SHEET C-505.

MIN.1% SLOPE.

 $\langle T \rangle$ ADD ALTERNATE #1 15" CLASS IV RCP.

SIDEWALK. PROVIDE CLEANOUTS AS SHOWN.

SEE DETAIL SHEET C-504.

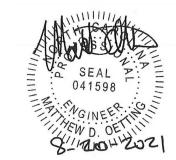

15

RCP


CLASS IV 7.84%

705.82

	ADDENDUM #1	KCD	8/20/2021	1
-				
CAB				
J/ (D	DESCRIPTION	BY	DATE	NO.

UNION STREET IMPROVEMENTS CITY OF CONCORD BARRUS COUNTY, NORTH CAROLINA

GRAPHIC SCALE D	5 10 20	GRADING, DRAINAGE, & EROSION CONTROL - B			
TICE MANAGER	DESIGNER				
.G. CHAPMAN	C.L. CRANWILL				
DJECT MANAGER	REVIEWER	DATE	PROJECT#	FUNDING #	
I.J. NORRIS	B. ROARK	JULY 2021	19.01726	N/A	

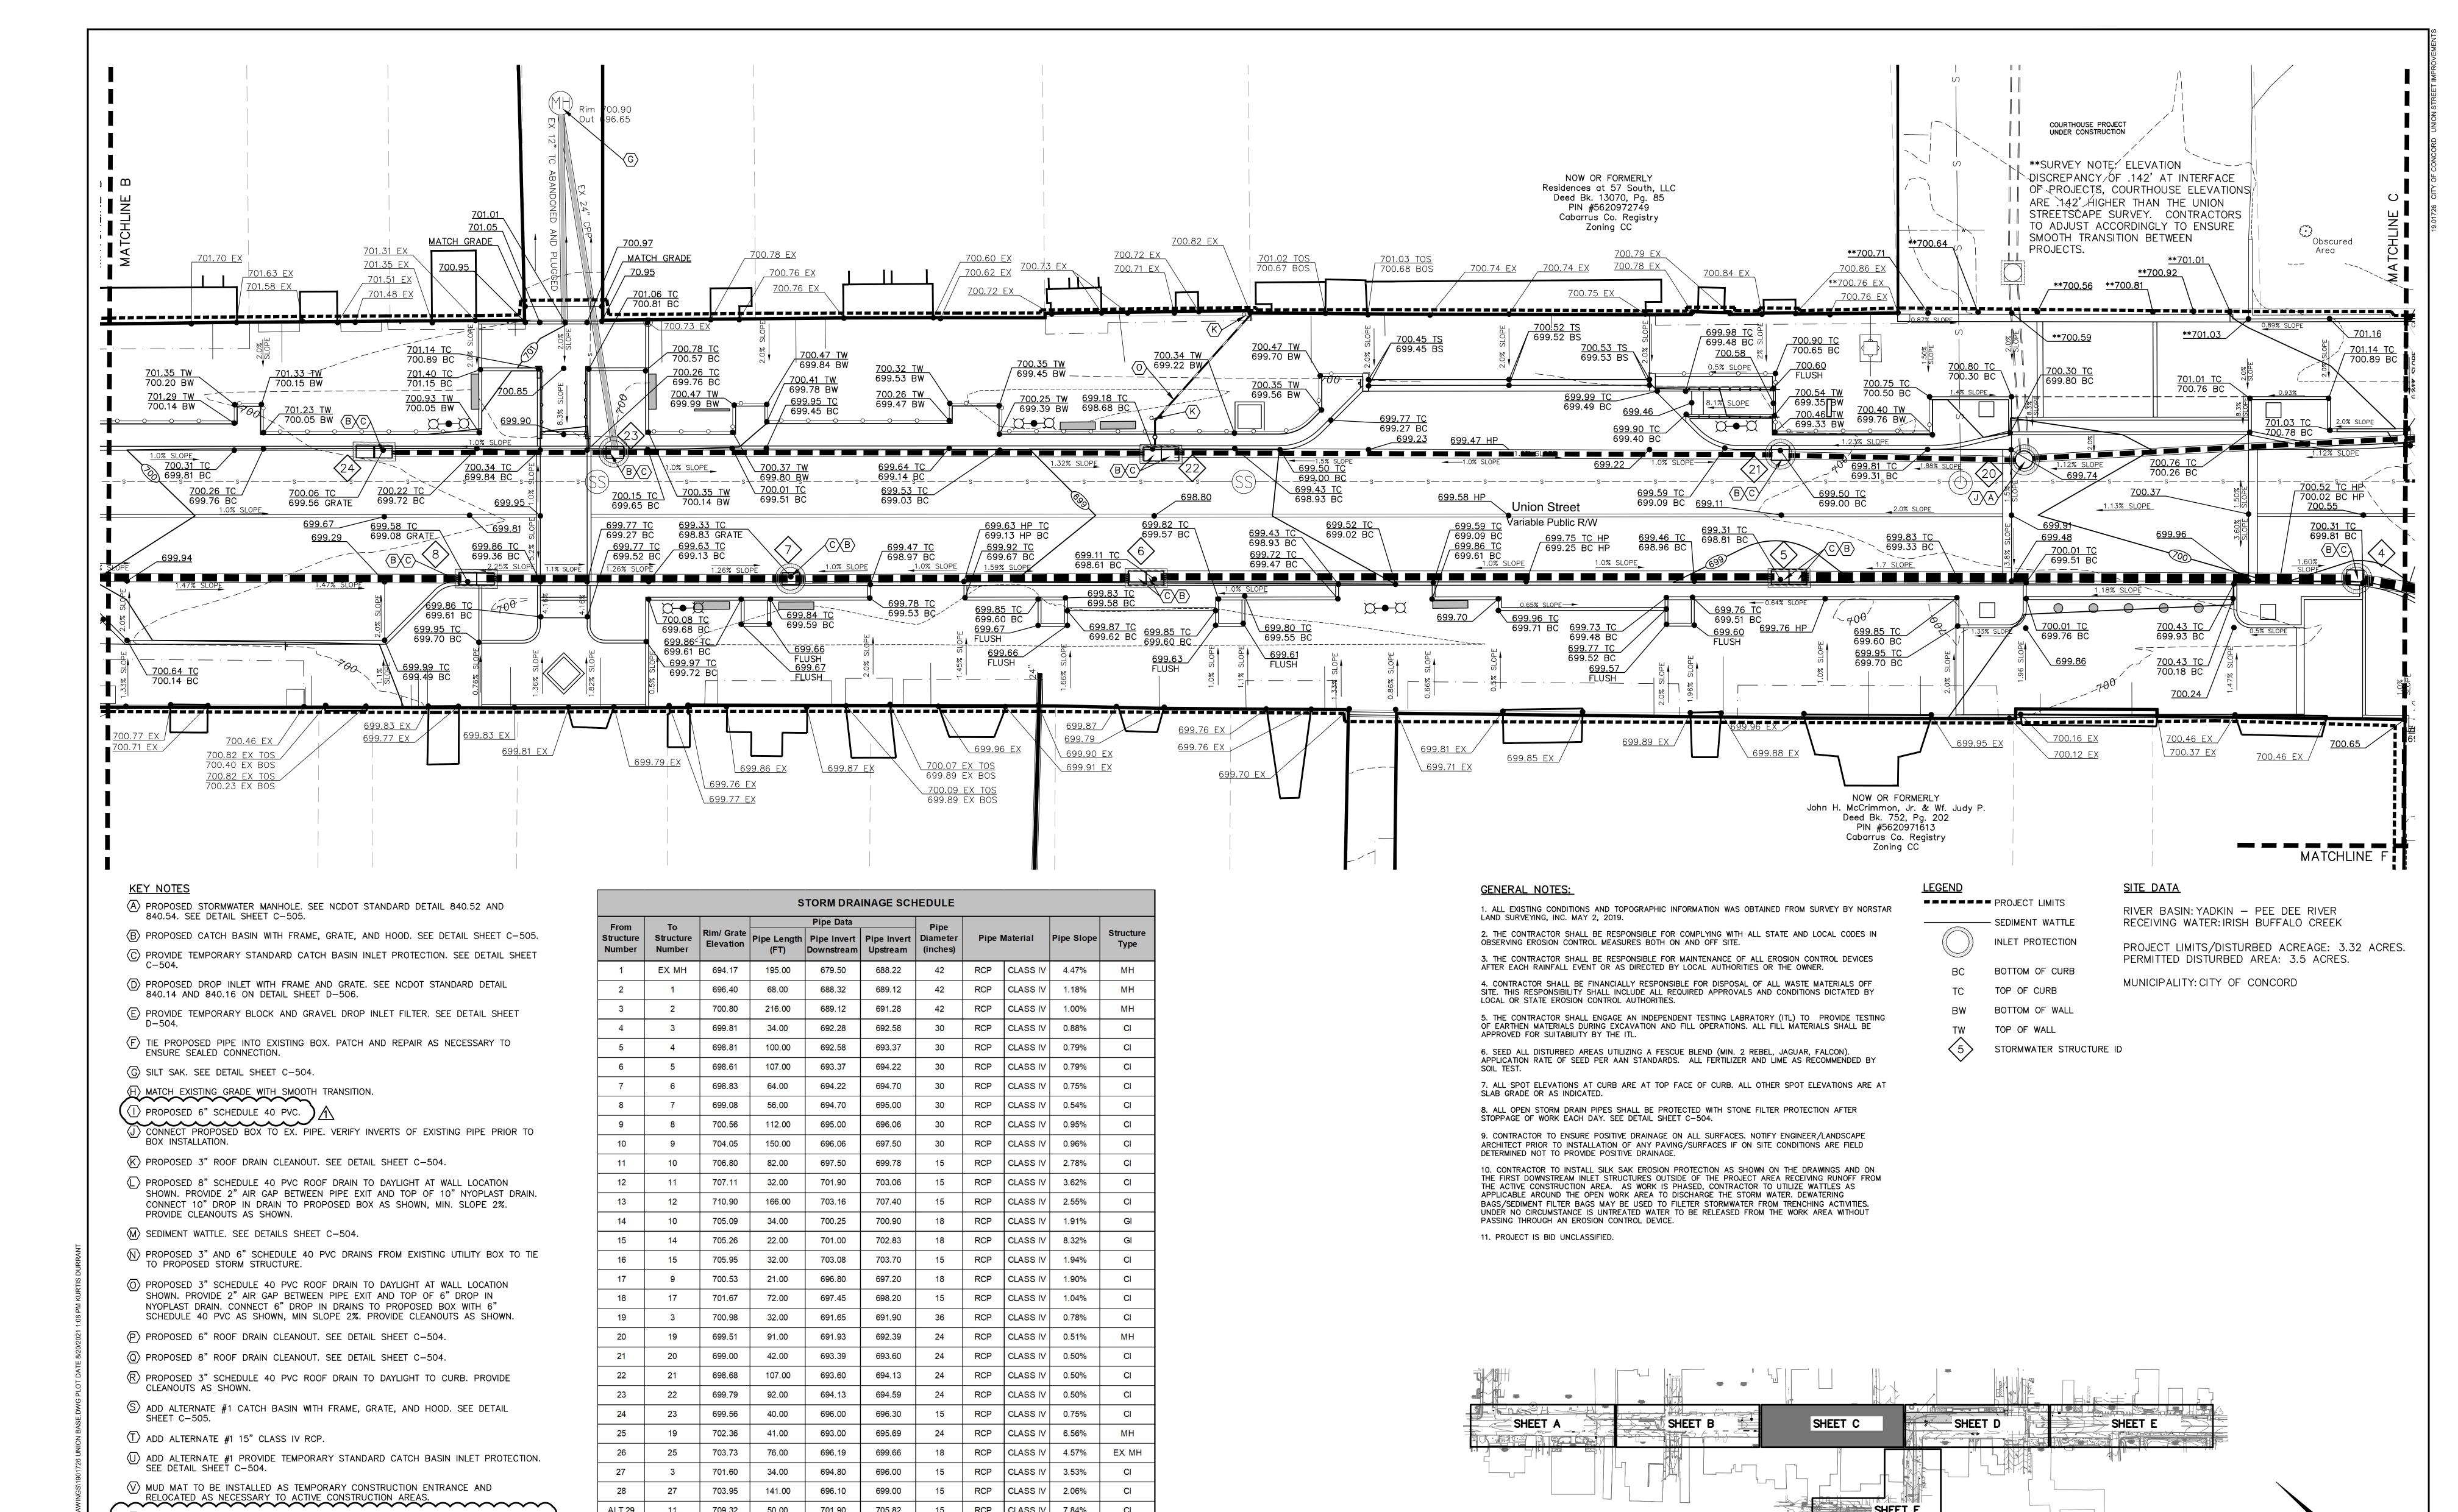

1240 19th Street Lane NW Hickory, NC 28601 828.328.2024 NC Firm License # C-0459 mcgillassociates.com

709.32

ALT 29

W PROVIDE 3" SCHEDULE 40 PVC ROOF DRAIN TO CONNECT TO PROPOSED MANHOLE AT MIN.1% SLOPE. CONTRACTOR TO REMOVE EX. 3" PIPE TO BUILDING FACE AND

X PROVIDE 4" SCHEDULE 40 PVC ROOF DRAIN TO CONNECT TO PROPOSED MANHOLE AT MIN.1% SLOPE. CONTRACTOR TO REMOVE ENOUGH EXISTING CONCRETE AROUND END OF PIPE AS NECESSARY TO INSTALL ELBOW FOR CONNECTION TO STORMWATER MANHOLE PIPE. INSTALL ELBOW SO THAT THERE IS NO CONFLICT WITH PROPOSED

Y PROVIDE 6" SCHEDULE 40 PVC ROOF DRAIN TO CONNECT TO PROPOSED MANHOLE AT

SIDEWALK. PROVIDE CLEANOUTS AS SHOWN.

REDIRECT FOR MANHOLE CONNECTION. LOCATION SHOWN IS APPROXIMATE. NOT FROM

50.00



15

RCP CLASS IV 7.84%

705.82

701.90


1	8/20/2021	KCD	ADDENDUM #1	
NO.	DATE	BY	DESCRIPTION	


UNION STREET IMPROVEMENTS CITY OF CONCORD CABARRUS COUNTY, NORTH CAROLINA


GRADING, DRAINAGE, & GRAPHIC SCALE DIVISION VALUE = 10 FEET **EROSION CONTROL - C** FFICE MANAGER D.G. CHAPMAN C.L. CRANWILL ROJECT MANAGER 19.01726 B. ROARK M.J. NORRIS JULY 2021 N/A

C-203

SHEET

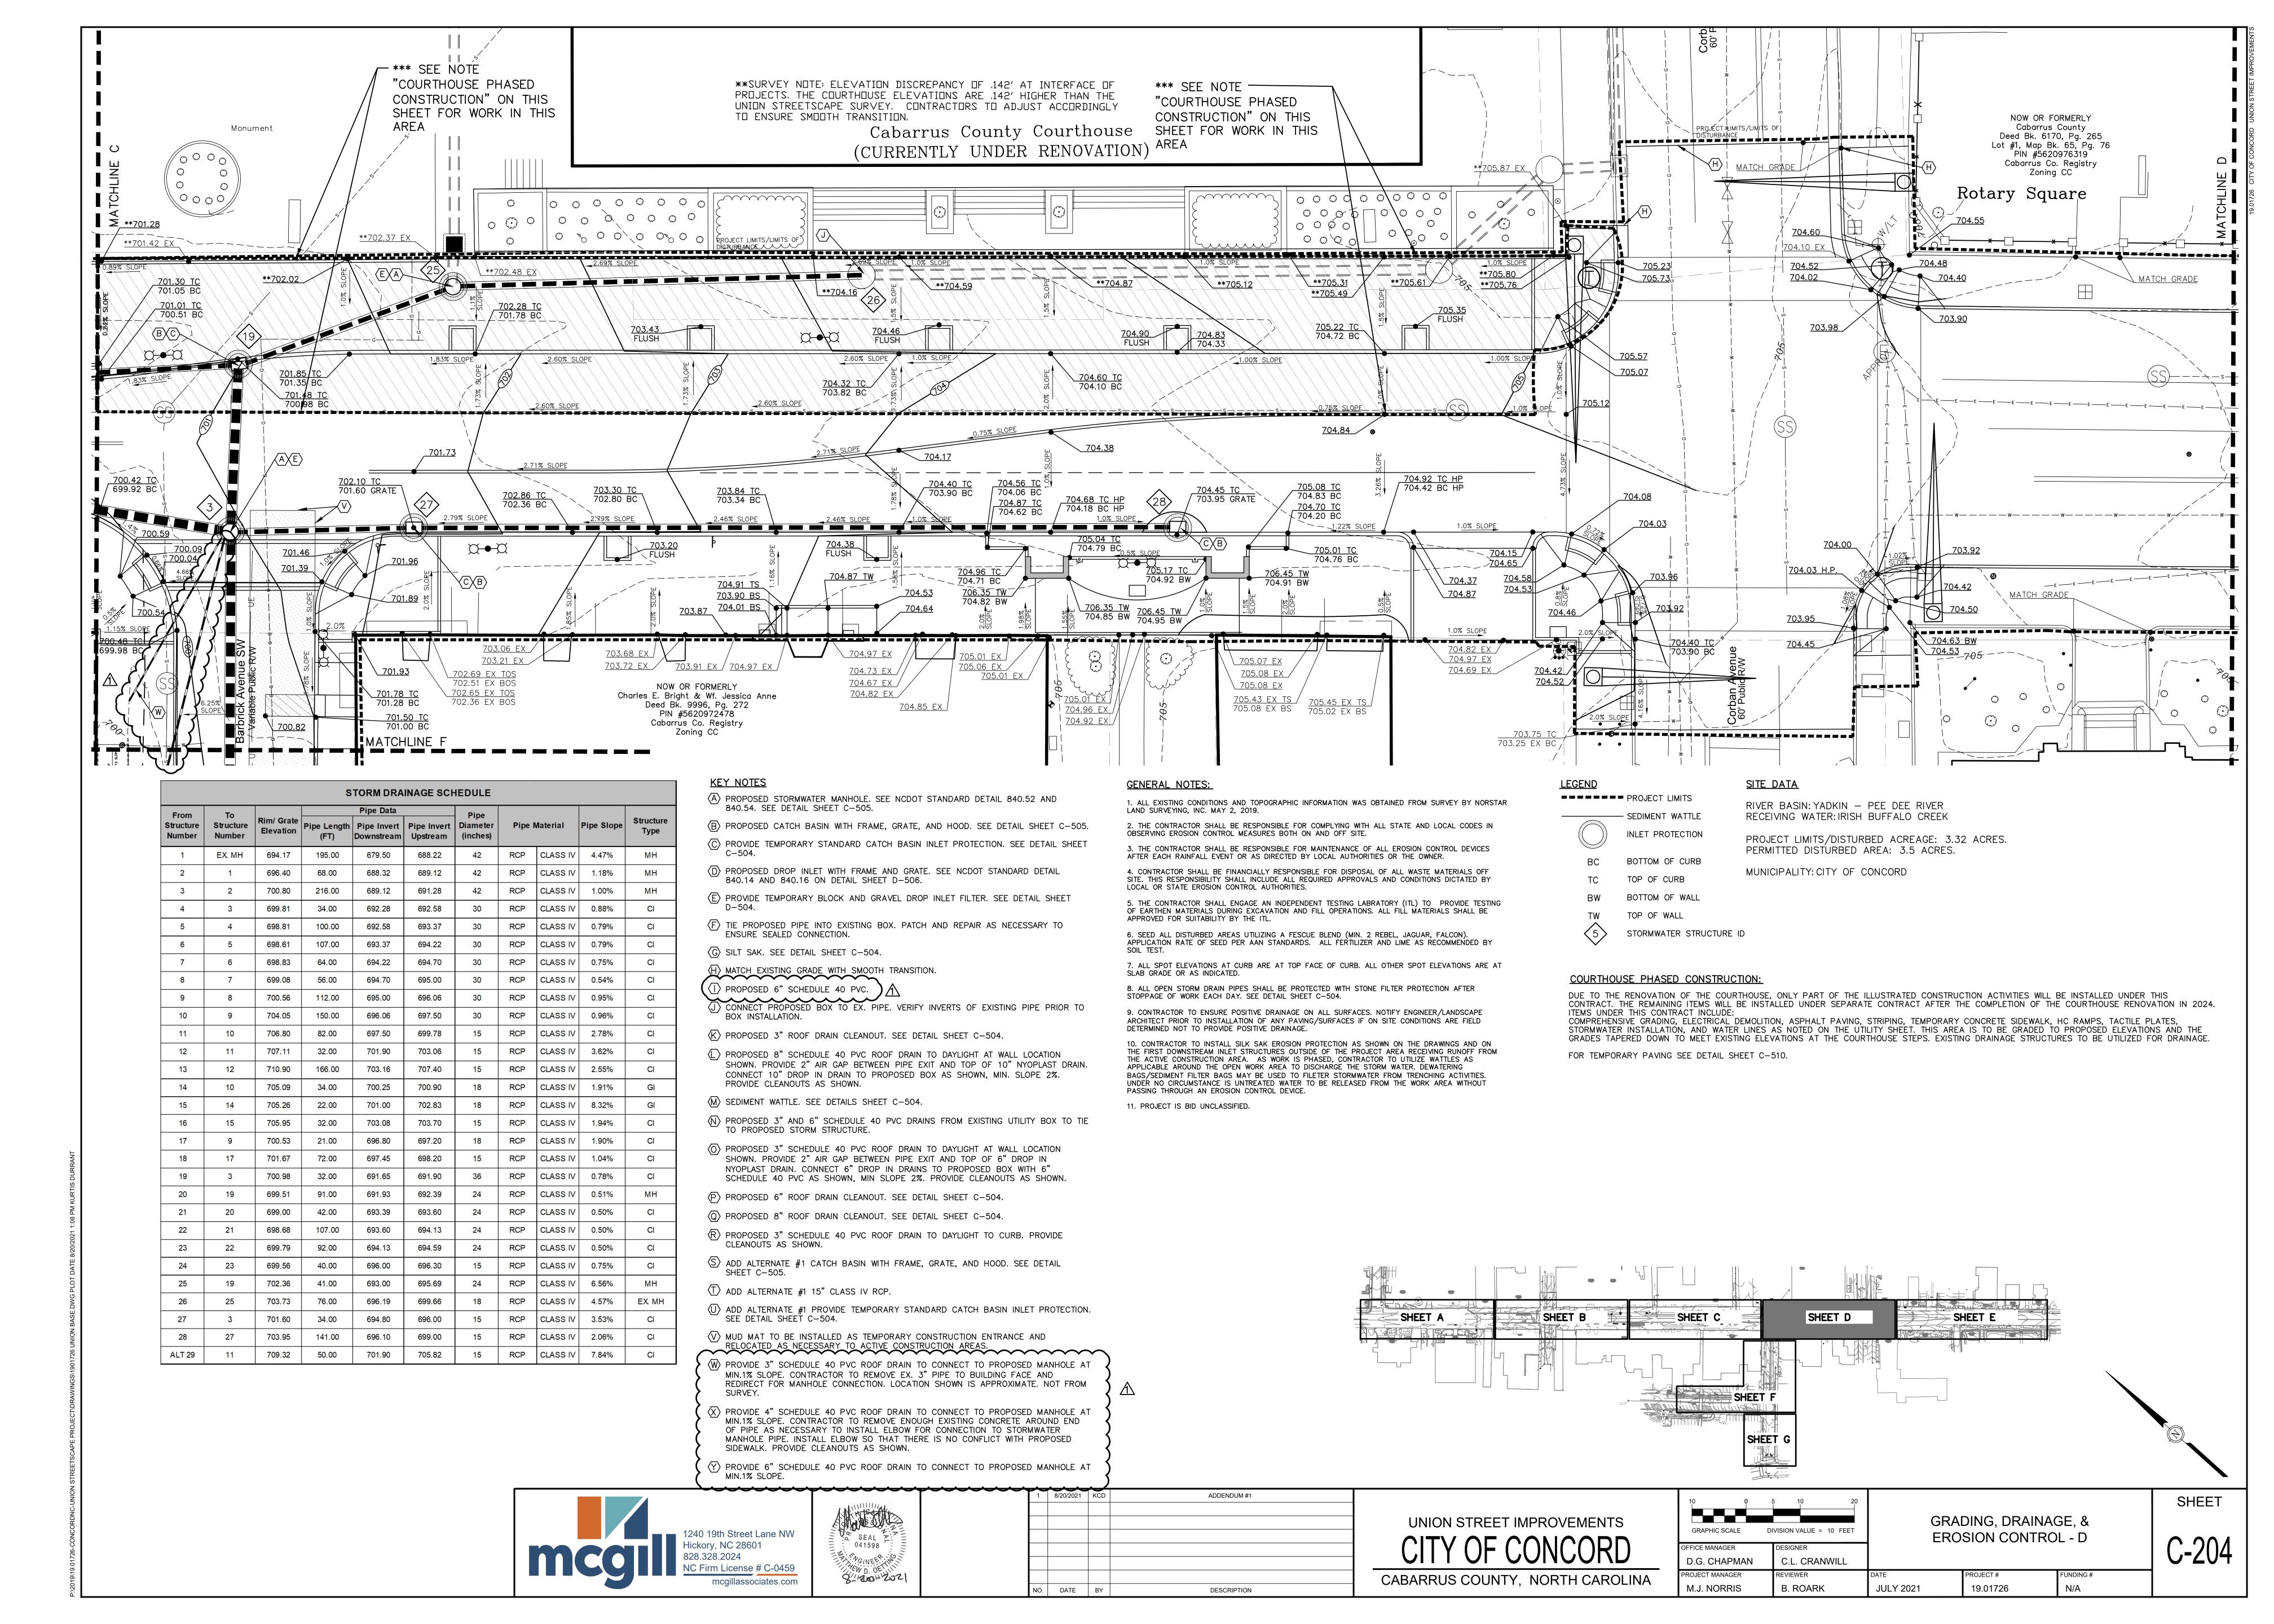

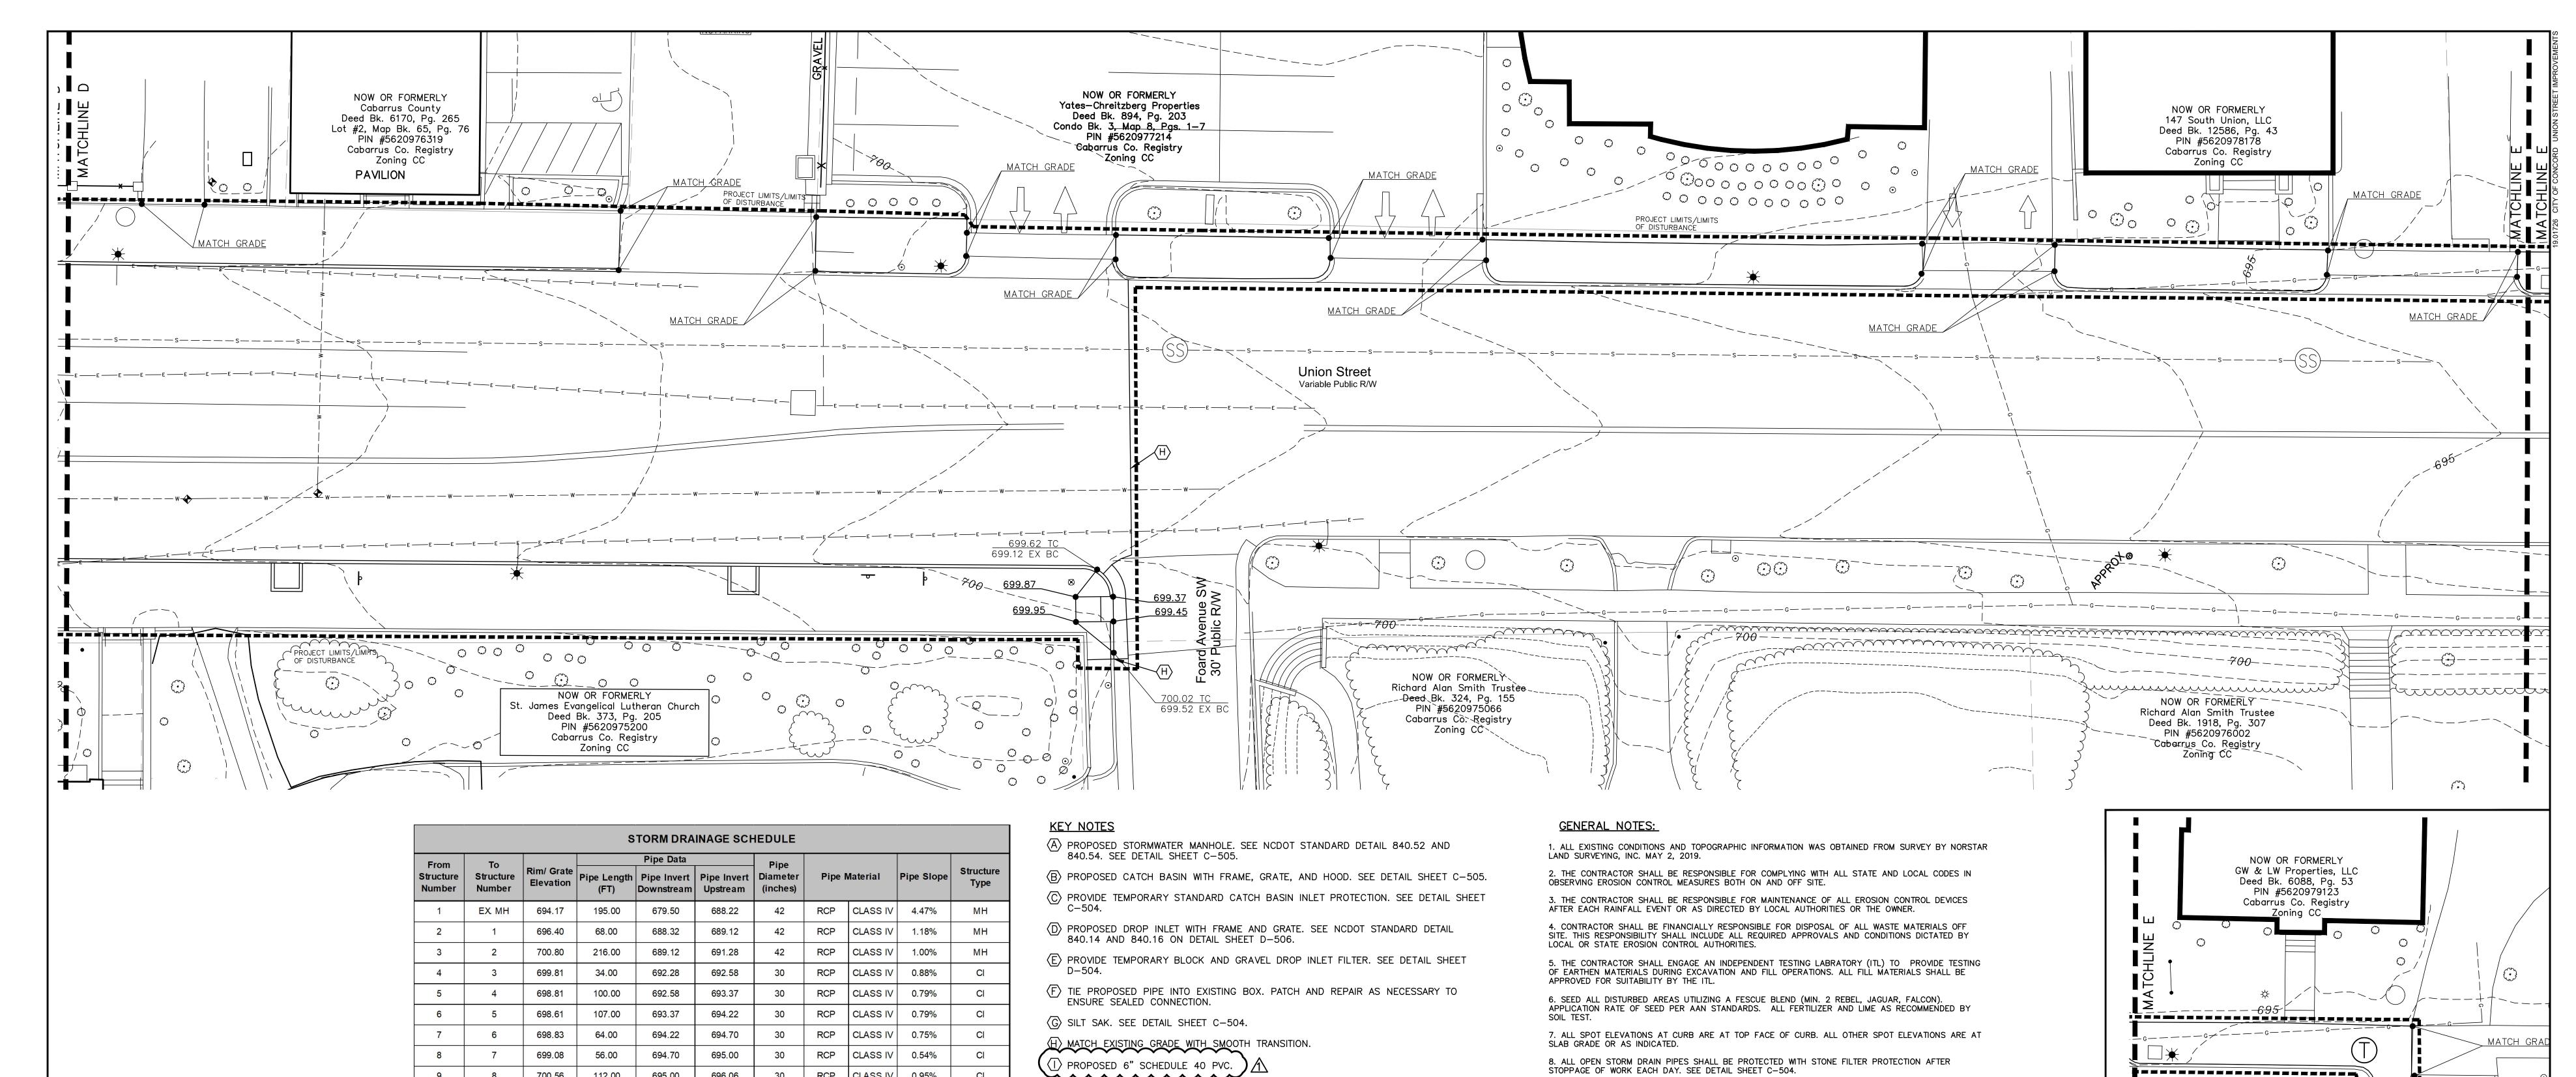

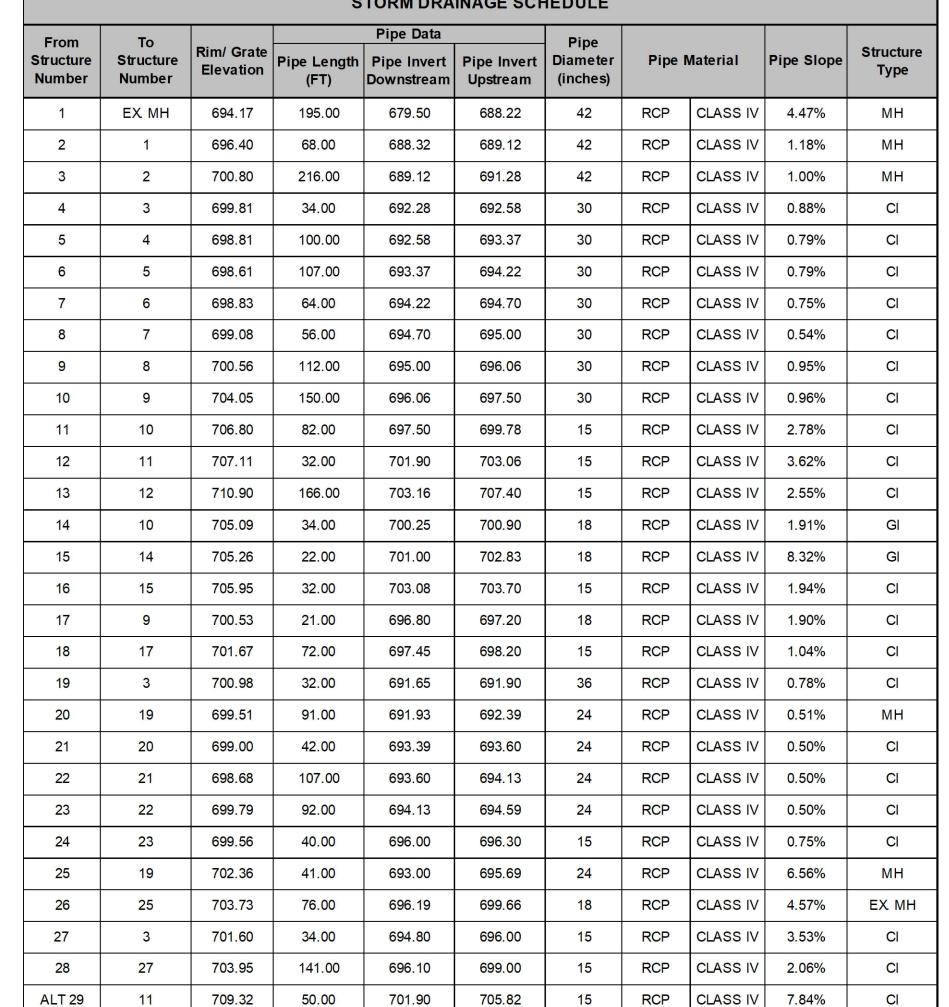

- (J) CONNECT PROPOSED BOX TO EX. PIPE. VERIFY INVERTS OF EXISTING PIPE PRIOR TO BOX INSTALLATION.
- (K) PROPOSED 3" ROOF DRAIN CLEANOUT. SEE DETAIL SHEET C-504.
- (L) PROPOSED 8" SCHEDULE 40 PVC ROOF DRAIN TO DAYLIGHT AT WALL LOCATION SHOWN. PROVIDE 2" AIR GAP BETWEEN PIPE EXIT AND TOP OF 10" NYOPLAST DRAIN. CONNECT 10" DROP IN DRAIN TO PROPOSED BOX AS SHOWN, MIN. SLOPE 2%. PROVIDE CLEANOUTS AS SHOWN.
- $\langle M \rangle$ SEDIMENT WATTLE. SEE DETAILS SHEET C-504.
- (N) PROPOSED 3" AND 6" SCHEDULE 40 PVC DRAINS FROM EXISTING UTILITY BOX TO TIE TO PROPOSED STORM STRUCTURE.
- (O) PROPOSED 3" SCHEDULE 40 PVC ROOF DRAIN TO DAYLIGHT AT WALL LOCATION SHOWN. PROVIDE 2" AIR GAP BETWEEN PIPE EXIT AND TOP OF 6" DROP IN NYOPLAST DRAIN. CONNECT 6" DROP IN DRAINS TO PROPOSED BOX WITH 6" SCHEDULE 40 PVC AS SHOWN, MIN SLOPE 2%. PROVIDE CLEANOUTS AS SHOWN.
- (P) PROPOSED 6" ROOF DRAIN CLEANOUT. SEE DETAIL SHEET C-504.
- $\langle \overline{\mathbb{Q}} \rangle$ PROPOSED 8" ROOF DRAIN CLEANOUT. SEE DETAIL SHEET C-504.
- (R) PROPOSED 3" SCHEDULE 40 PVC ROOF DRAIN TO DAYLIGHT TO CURB. PROVIDE CLEANOUTS AS SHOWN.
- S ADD ALTERNATE #1 CATCH BASIN WITH FRAME, GRATE, AND HOOD. SEE DETAIL SHEET C-505.
- $\langle T \rangle$ ADD ALTERNATE #1 15" CLASS IV RCP.
- $\langle \overline{\mathsf{U}} \rangle$ add alternate #1 provide temporary standard catch basin inlet protection. SEE DETAIL SHEET C-504.
- (V) MUD MAT TO BE INSTALLED AS TEMPORARY CONSTRUCTION ENTRANCE AND
- RELOCATED AS NECESSARY TO ACTIVE CONSTRUCTION AREAS. (W) PROVIDE 3" SCHEDULE 40 PVC ROOF DRAIN TO CONNECT TO PROPOSED MANHOLE AT MIN.1% SLOPE. CONTRACTOR TO REMOVE EX. 3" PIPE TO BUILDING FACE AND REDIRECT FOR MANHOLE CONNECTION. LOCATION SHOWN IS APPROXIMATE. NOT FROM
- X PROVIDE 4" SCHEDULE 40 PVC ROOF DRAIN TO CONNECT TO PROPOSED MANHOLE AT MIN.1% SLOPE. CONTRACTOR TO REMOVE ENOUGH EXISTING CONCRETE AROUND END OF PIPE AS NECESSARY TO INSTALL ELBOW FOR CONNECTION TO STORMWATER MANHOLE PIPE. INSTALL ELBOW SO THAT THERE IS NO CONFLICT WITH PROPOSED SIDEWALK. PROVIDE CLEANOUTS AS SHOWN.
- Y PROVIDE 6" SCHEDULE 40 PVC ROOF DRAIN TO CONNECT TO PROPOSED MANHOLE AT MIN.1% SLOPE.

- STOPPAGE OF WORK EACH DAY. SEE DETAIL SHEET C-504. 9. CONTRACTOR TO ENSURE POSITIVE DRAINAGE ON ALL SURFACES. NOTIFY ENGINEER/LANDSCAPE ARCHITECT PRIOR TO INSTALLATION OF ANY PAVING/SURFACES IF ON SITE CONDITIONS ARE FIELD
- DETERMINED NOT TO PROVIDE POSITIVE DRAINAGE. 10. CONTRACTOR TO INSTALL SILK SAK EROSION PROTECTION AS SHOWN ON THE DRAWINGS AND ON THE FIRST DOWNSTREAM INLET STRUCTURES OUTSIDE OF THE PROJECT AREA RECEIVING RUNOFF FROM THE ACTIVE CONSTRUCTION AREA. AS WORK IS PHASED, CONTRACTOR TO UTILIZE WATTLES AS APPLICABLE AROUND THE OPEN WORK AREA TO DISCHARGE THE STORM WATER. DEWATERING BAGS/SEDIMENT FILTER BAGS MAY BE USED TO FILETER STORMWATER FROM TRENCHING ACTIVITIES.

UNDER NO CIRCUMSTANCE IS UNTREATED WATER TO BE RELEASED FROM THE WORK AREA WITHOUT

PASSING THROUGH AN EROSION CONTROL DEVICE. 11. PROJECT IS BID UNCLASSIFIED.

PROJECT LIMITS

- SEDIMENT WATTLE

- INLET PROTECTION
- BOTTOM OF CURB
- TOP OF CURB
- BOTTOM OF WALL TOP OF WALL


STORMWATER STRUCTURE ID


SITE DATA

RIVER BASIN: YADKIN - PEE DEE RIVER RECEIVING WATER: IRISH BUFFALO CREEK

PROJECT LIMITS/DISTURBED ACREAGE: 3.32 ACRES. PERMITTED DISTURBED AREA: 3.5 ACRES.

MUNICIPALITY: CITY OF CONCORD

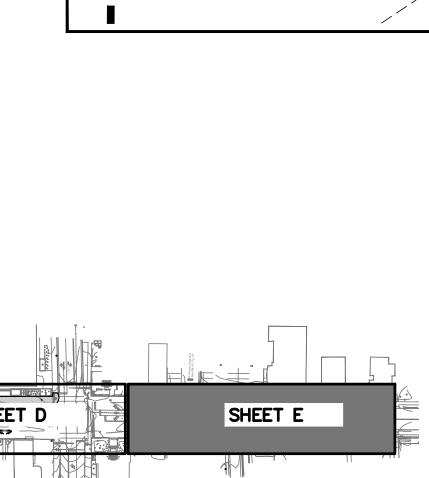

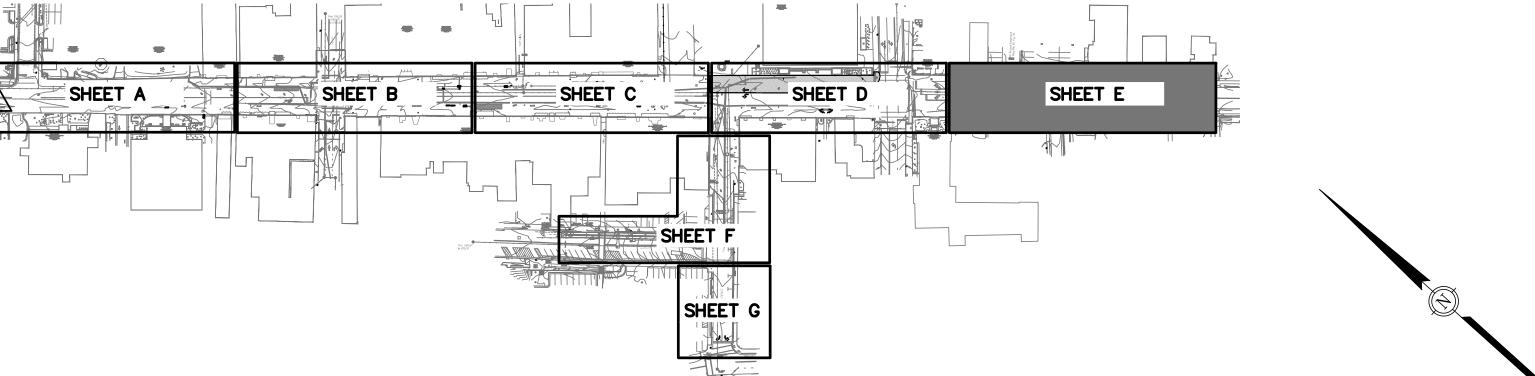





1	8/20/2021	KCD	ADDENDUM #1	
NO.	DATE	BY	DESCRIPTION	

UNION STREET IMPROVEMENTS CITY OF CONCORD CABARRUS COUNTY, NORTH CAROLINA

GRAPHIC SCALE DIVISION VALUE = 10 FEET FFICE MANAGER D.G. CHAPMAN C.L. CRANWILL ROJECT MANAGER B. ROARK M.J. NORRIS JULY 2021


GRADING, DRAINAGE, & EROSION CONTROL - E


19.01726


N/A


C-205


SHEET

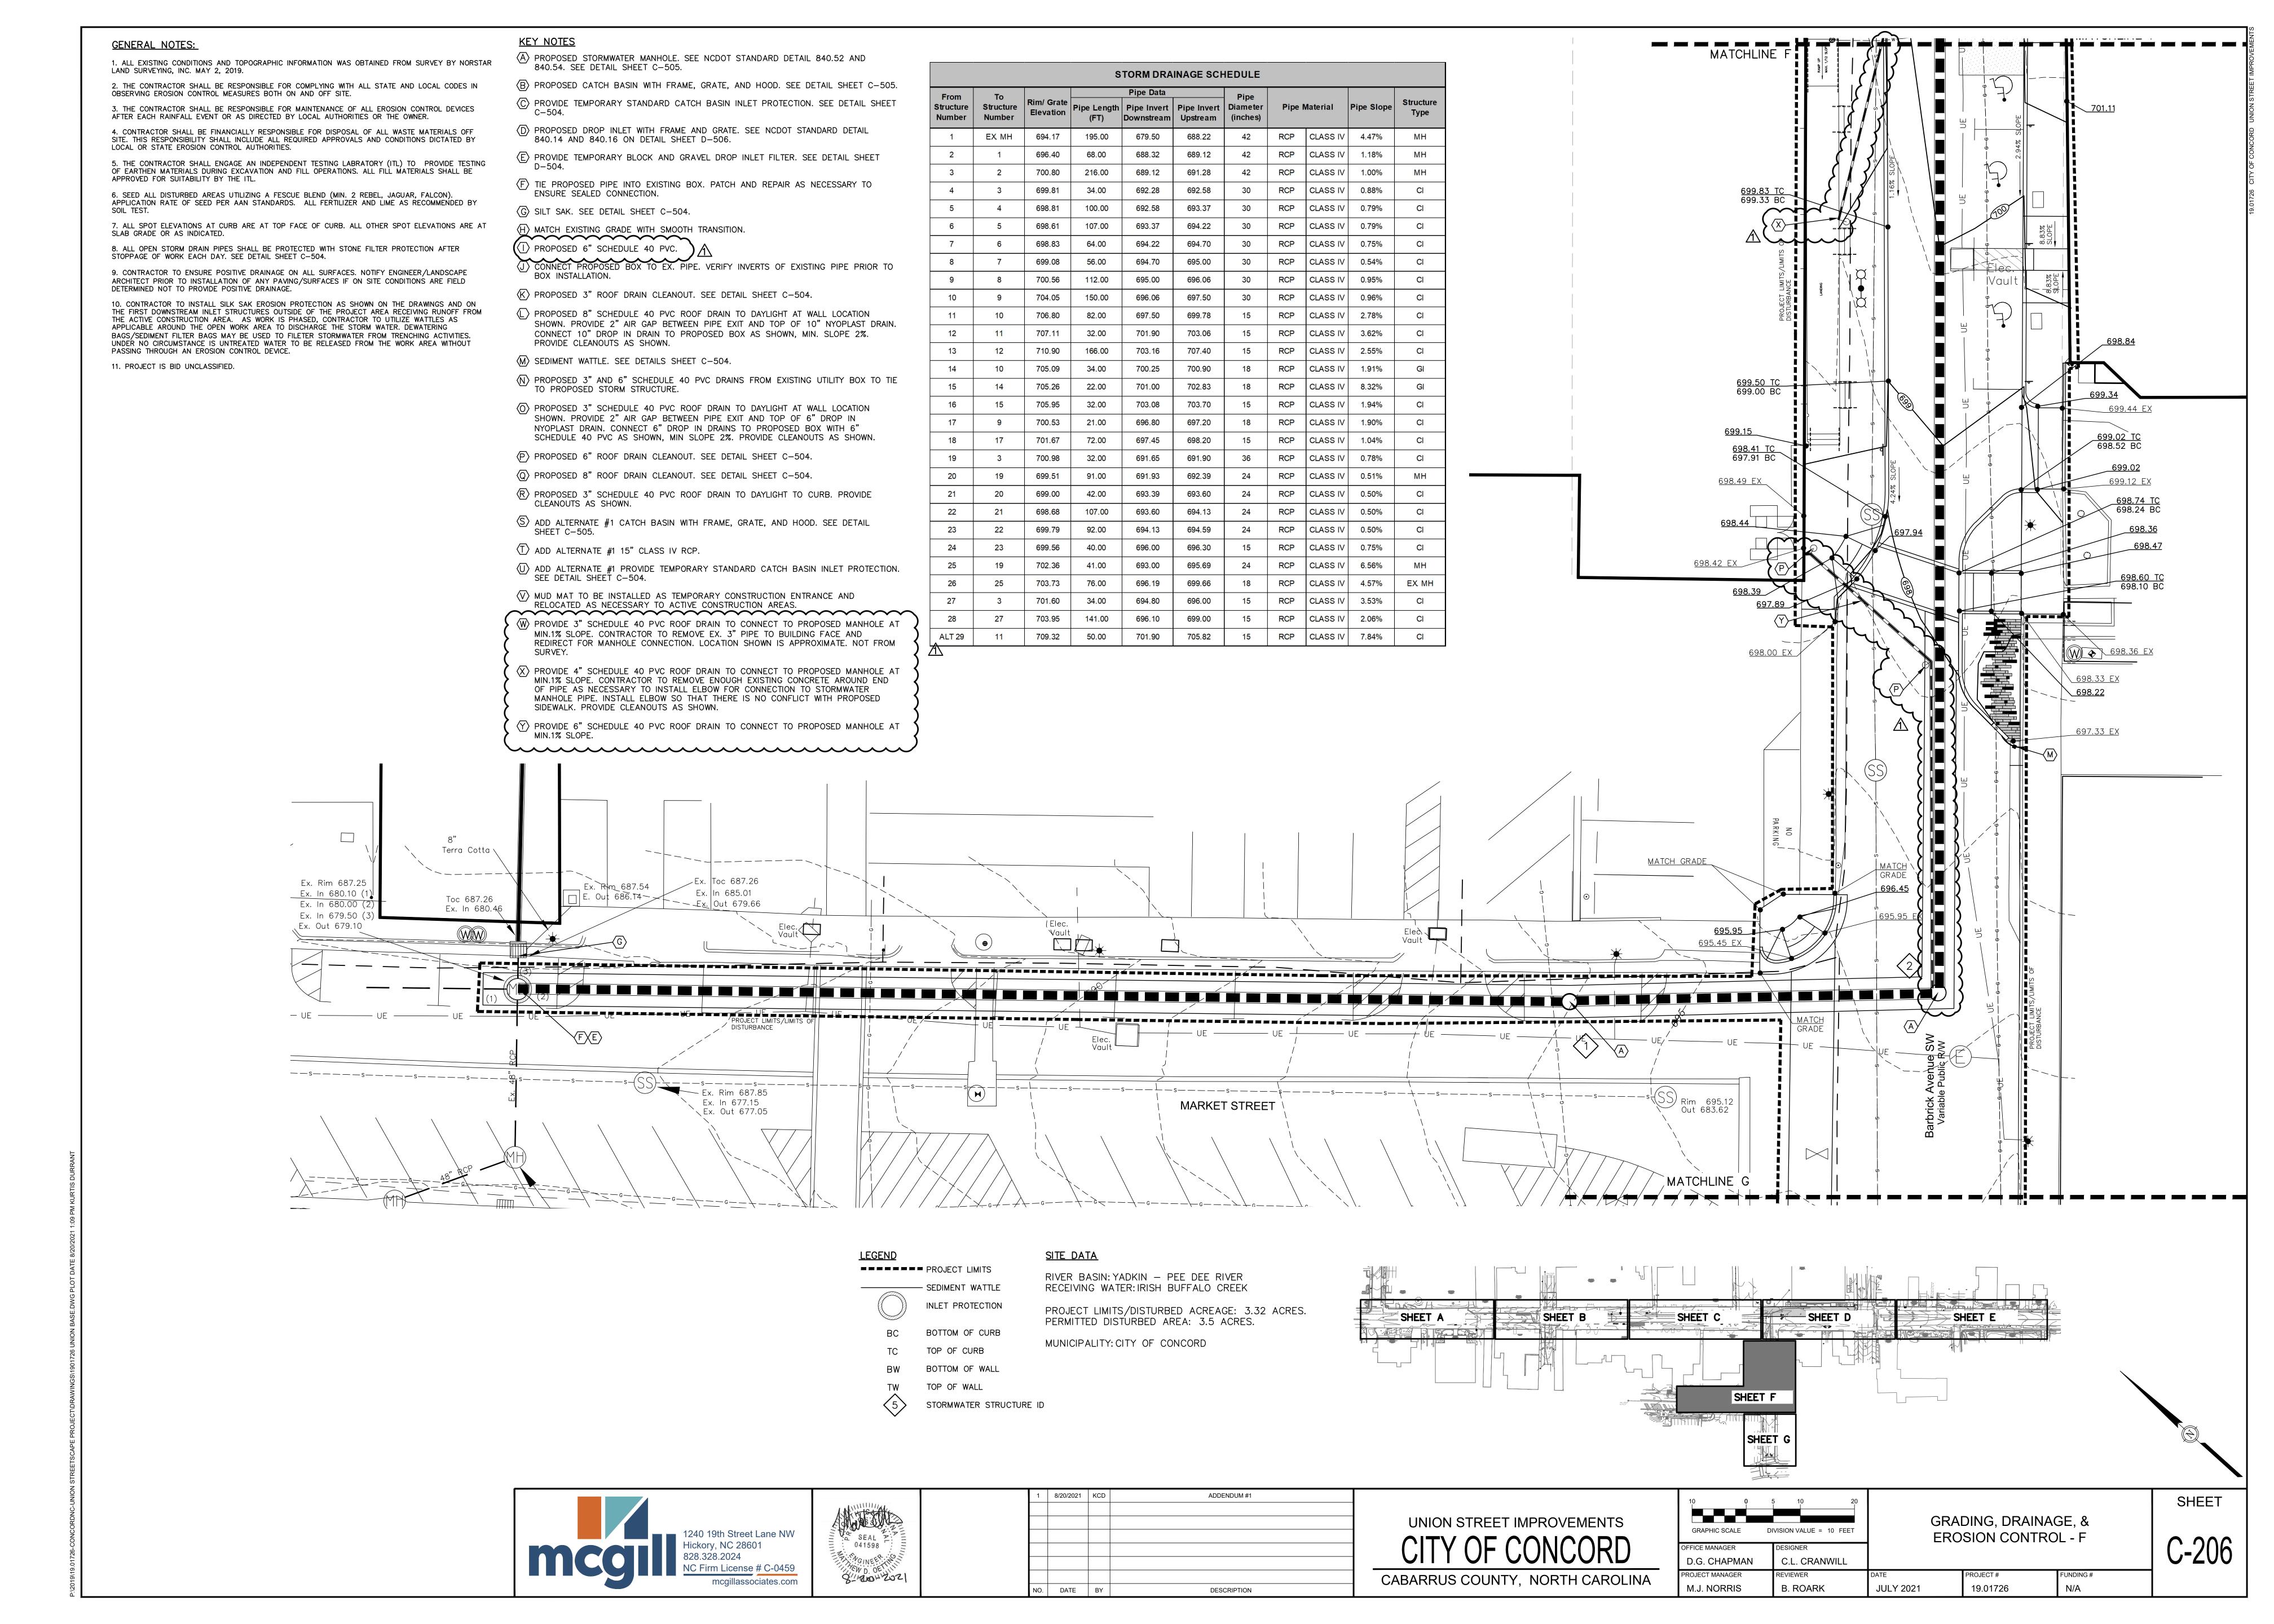


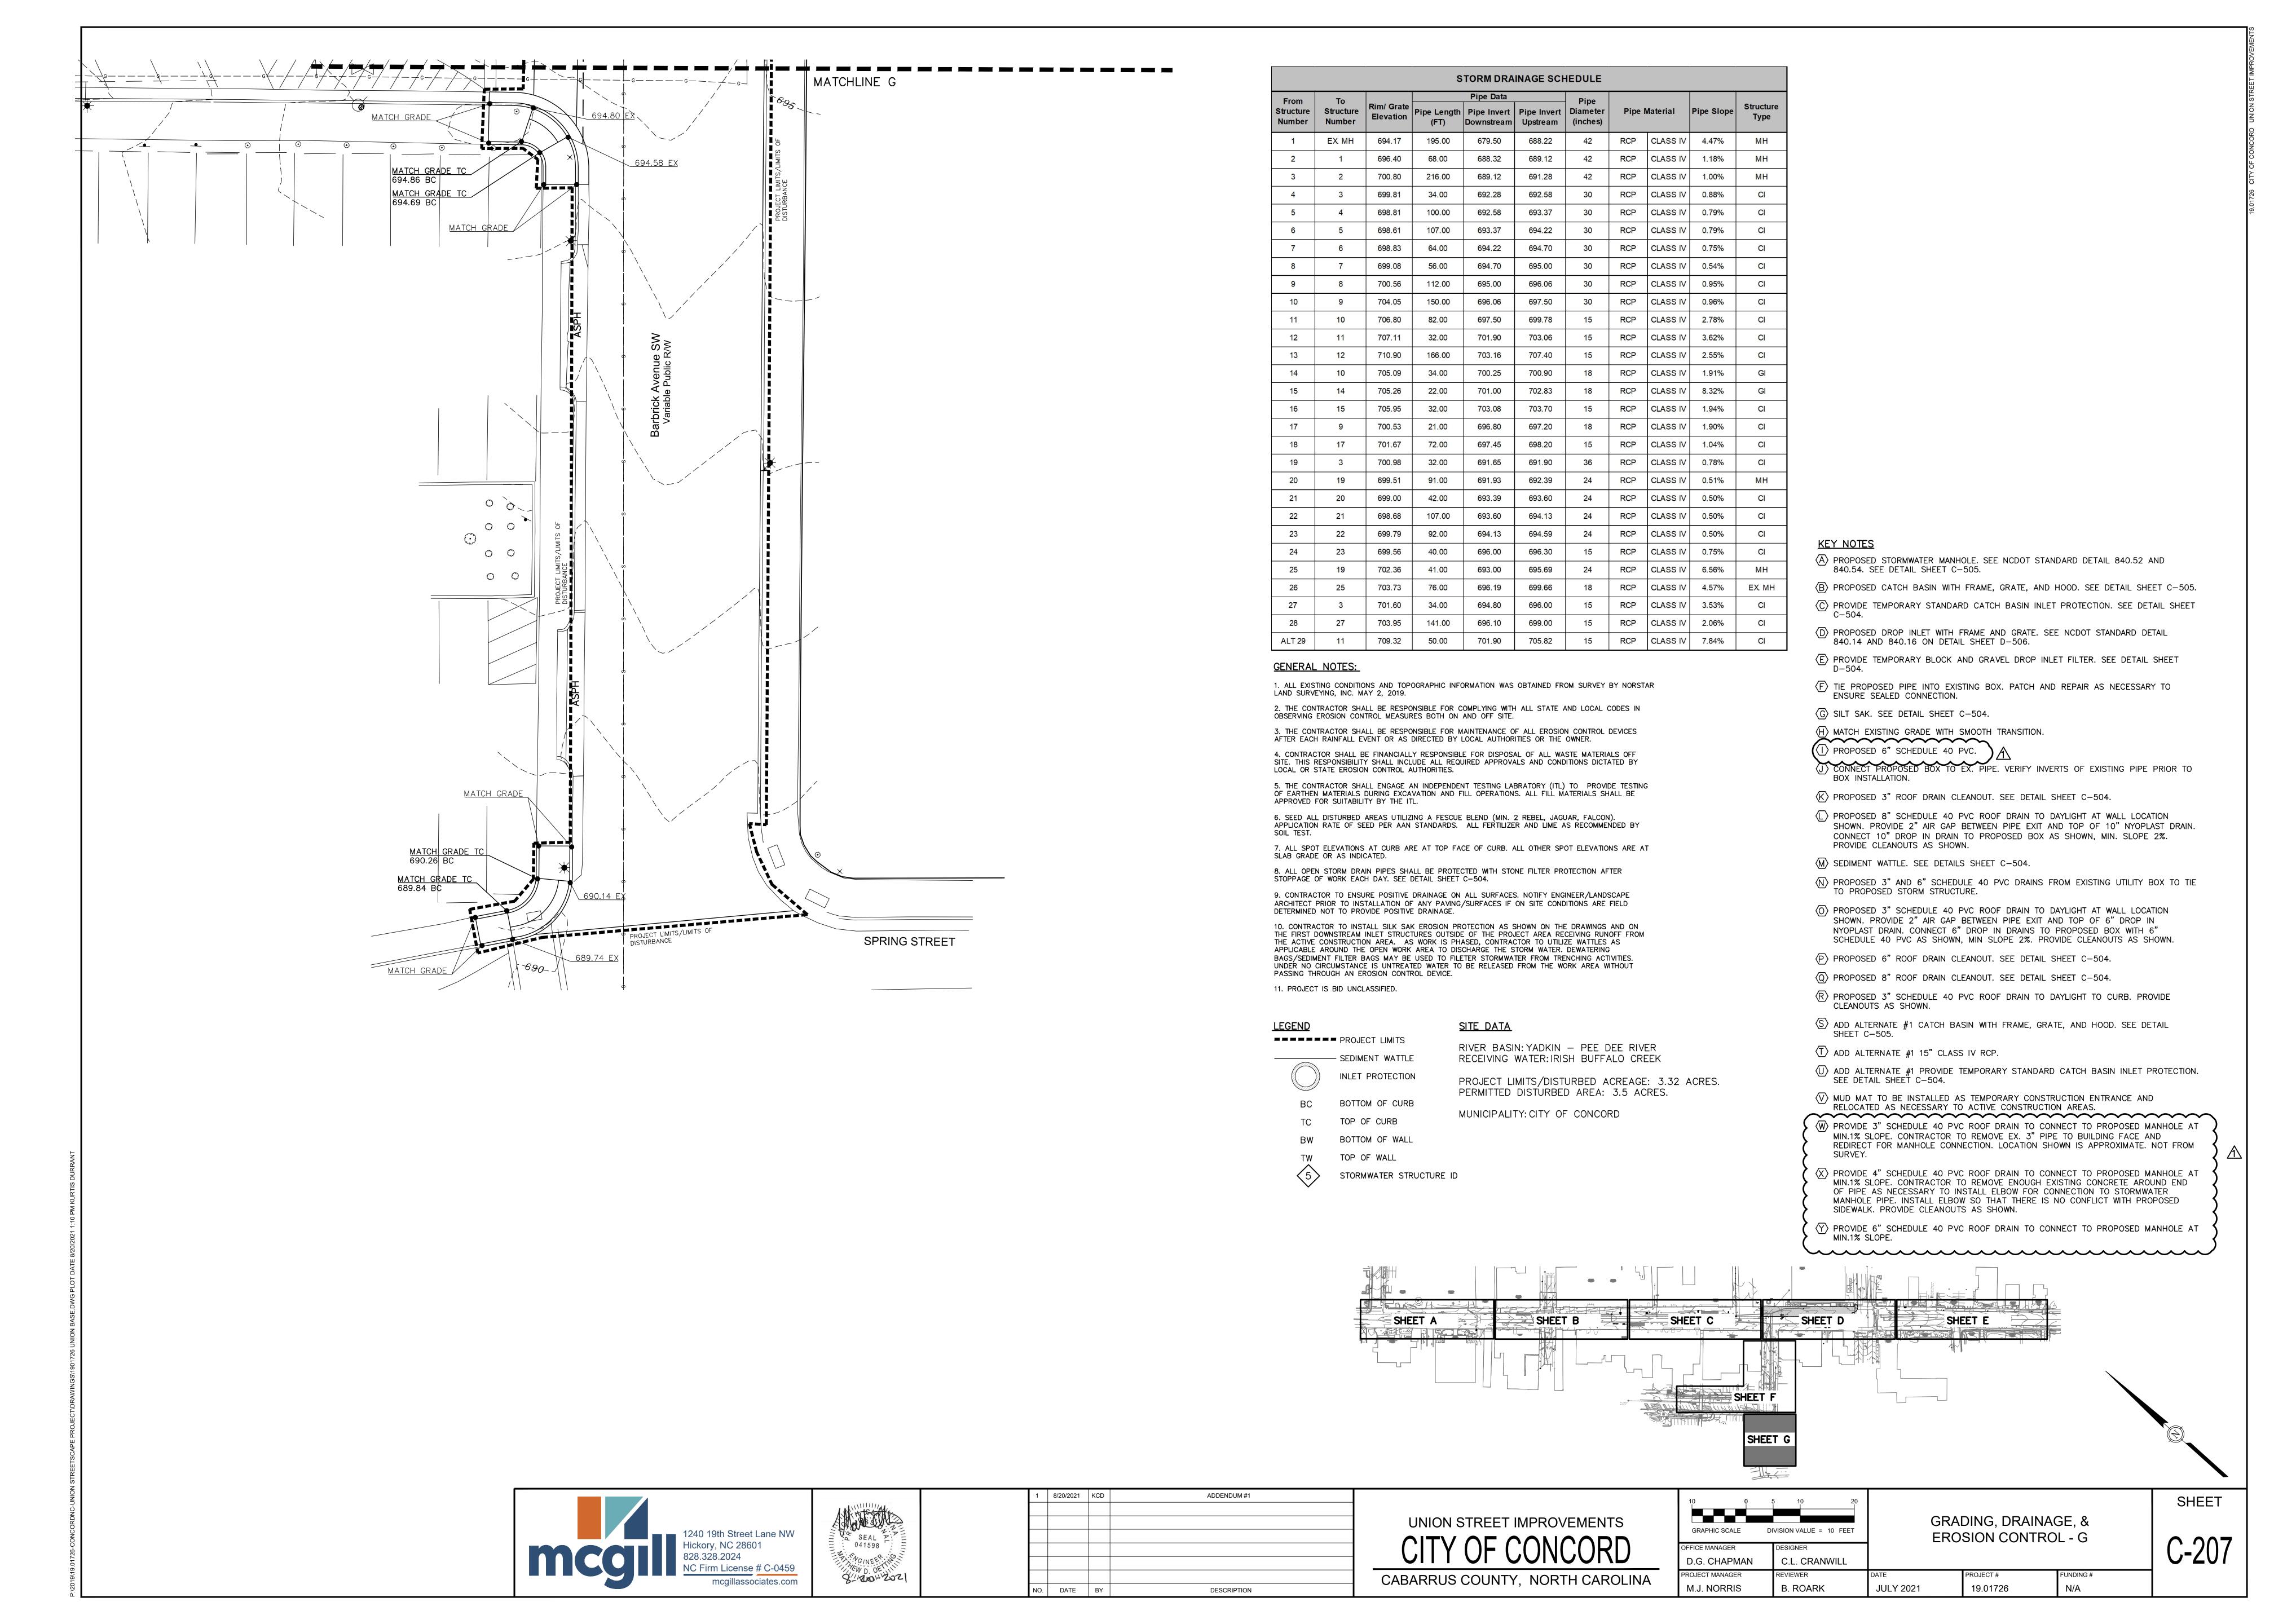


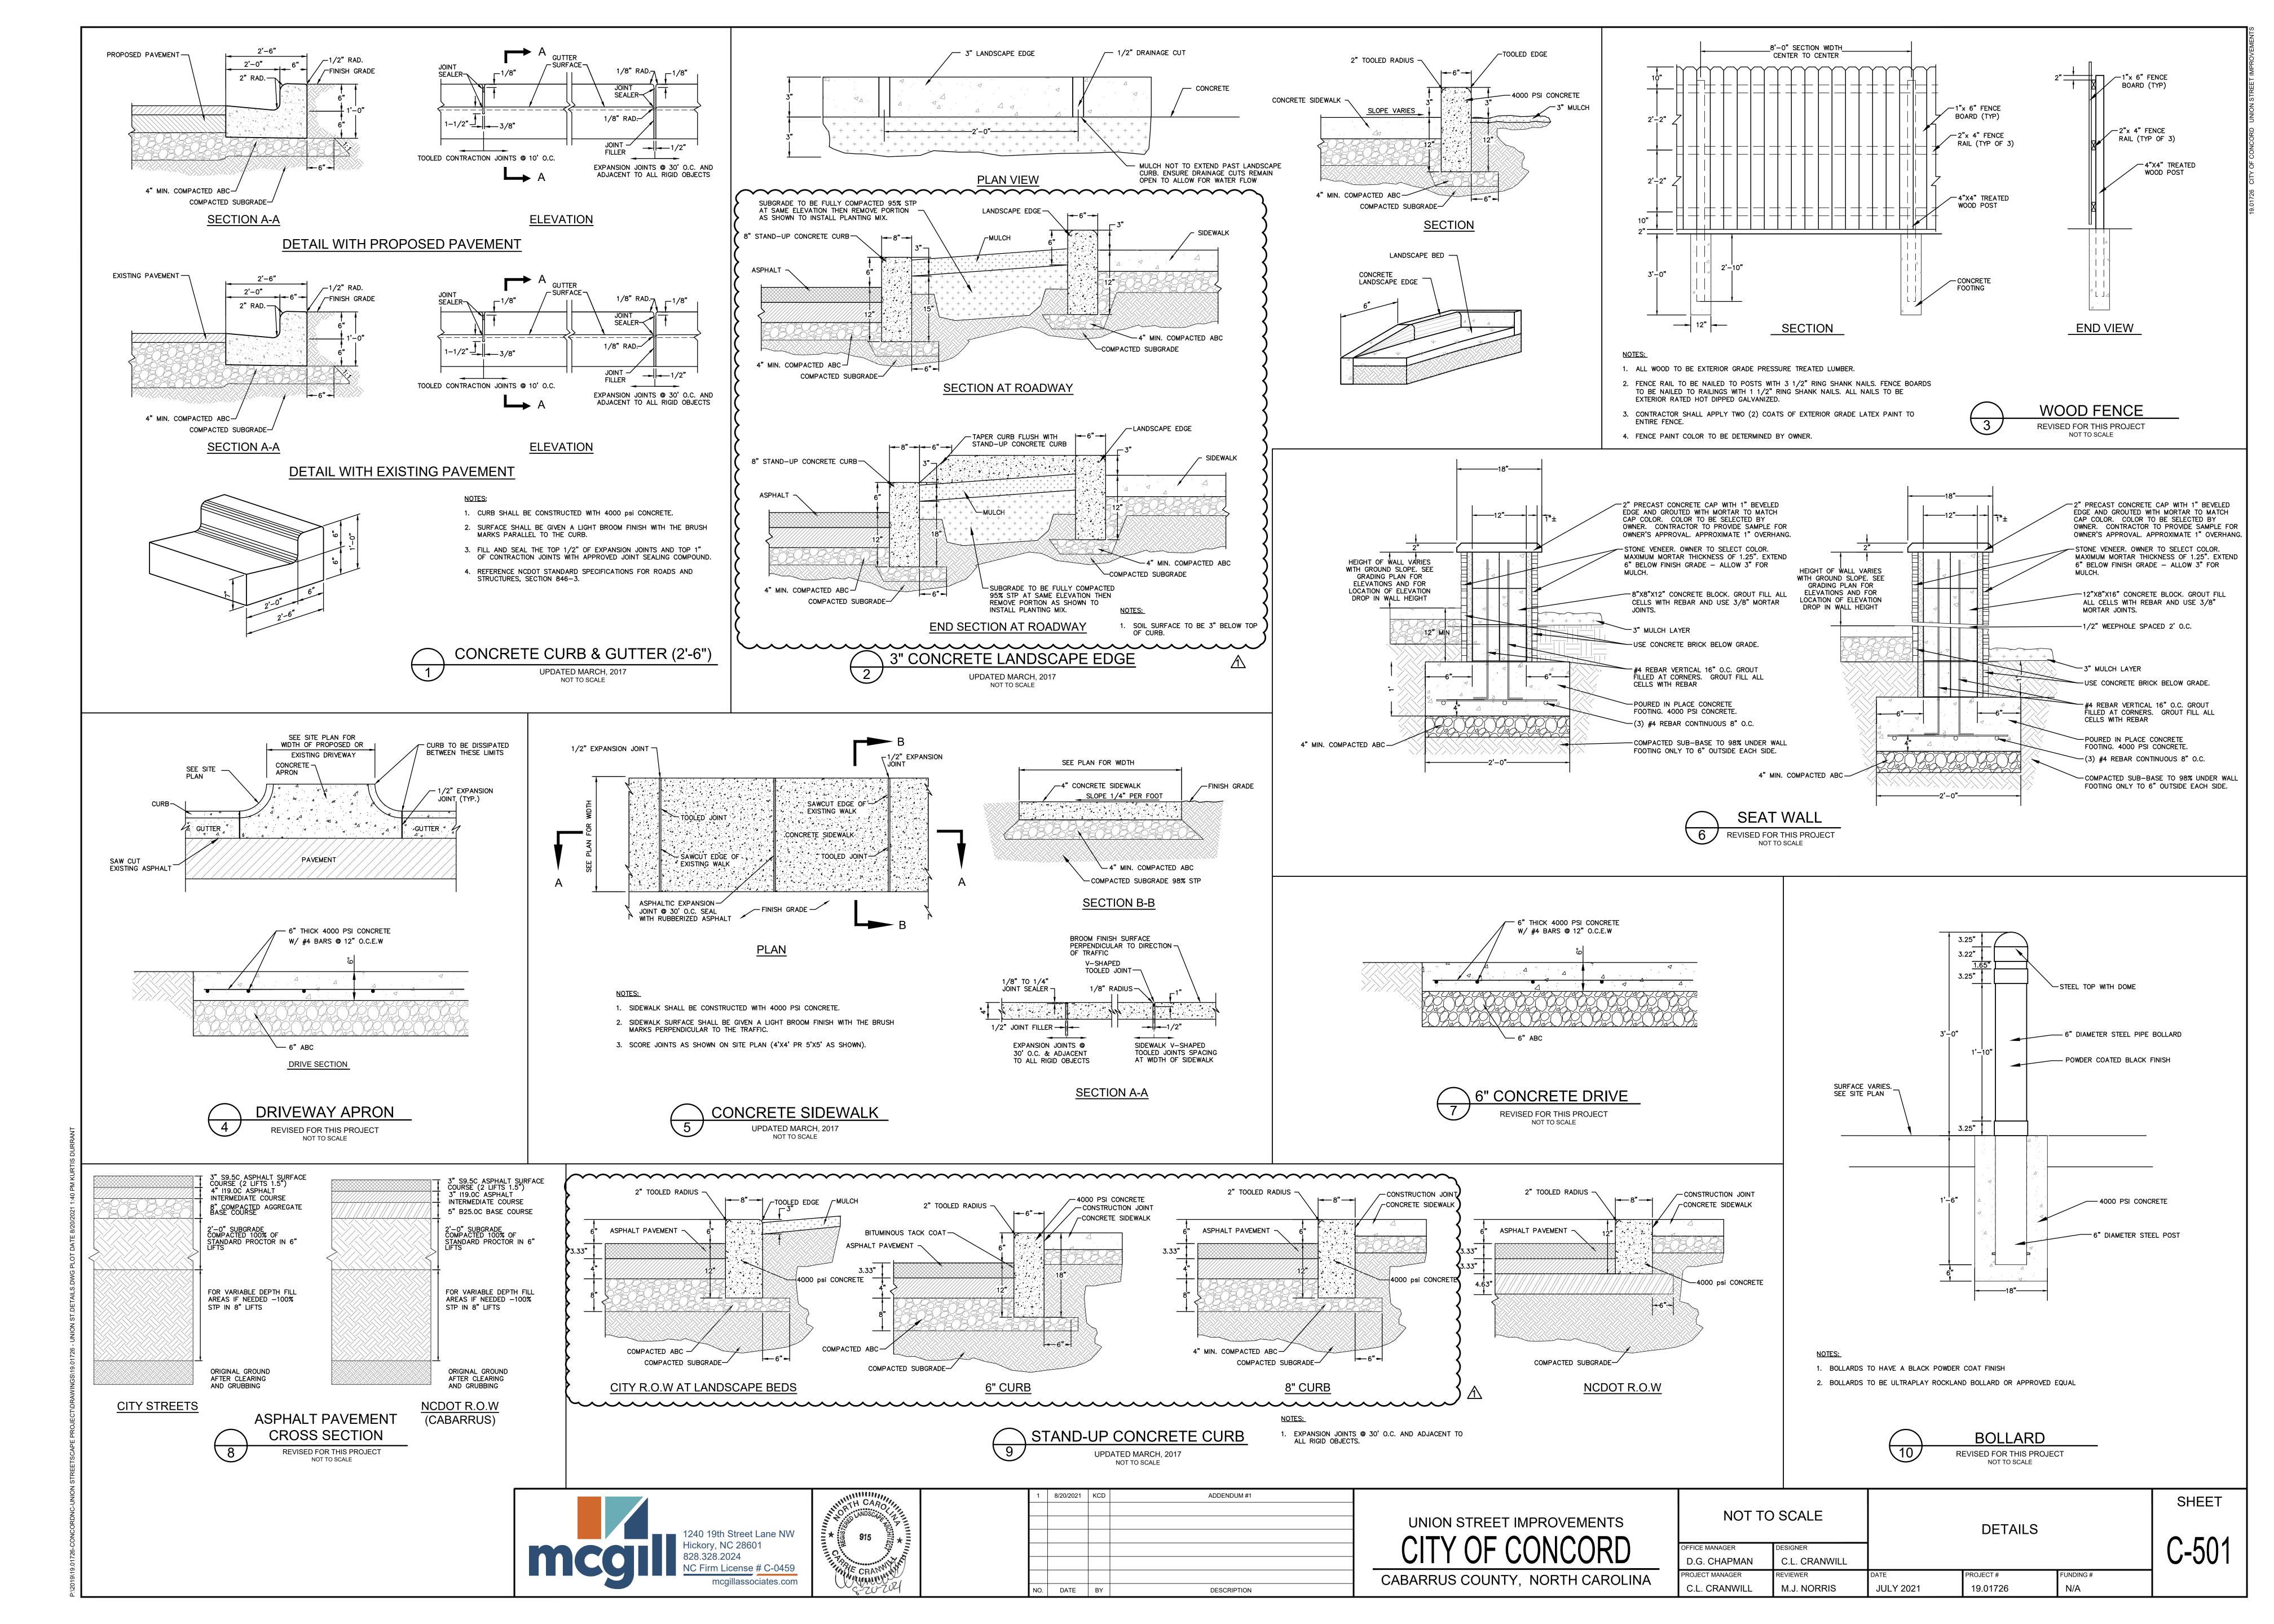


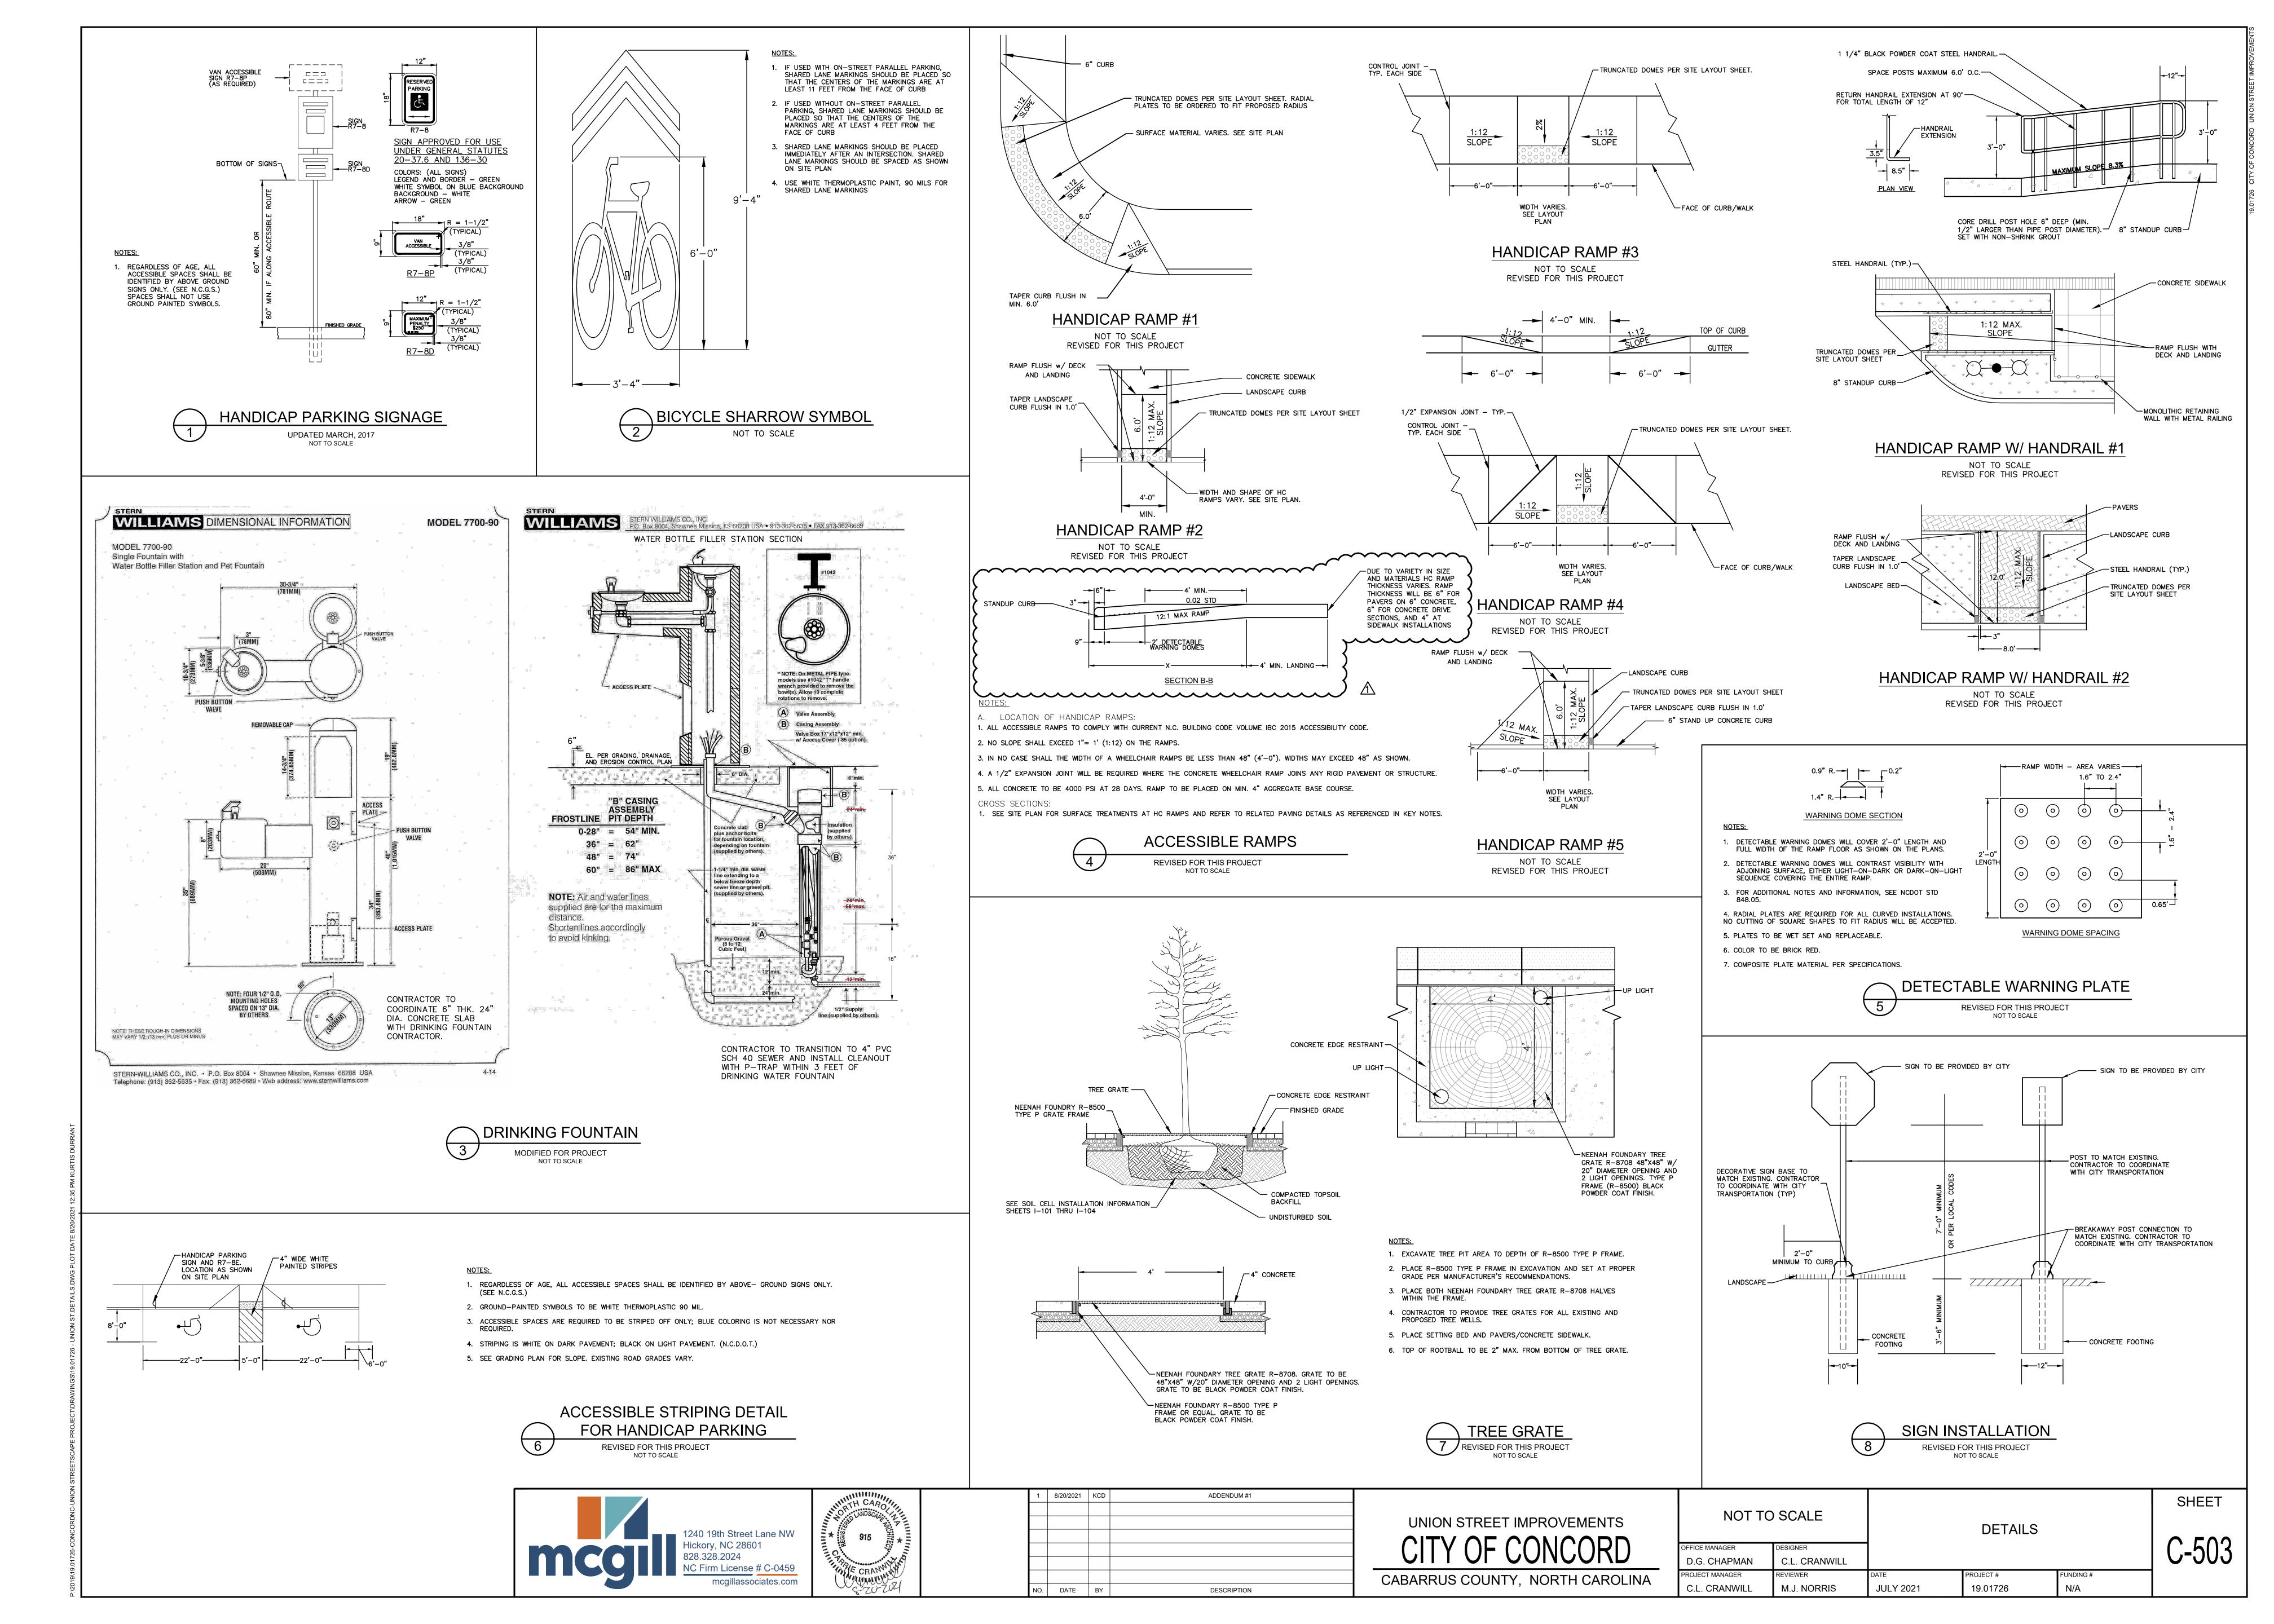


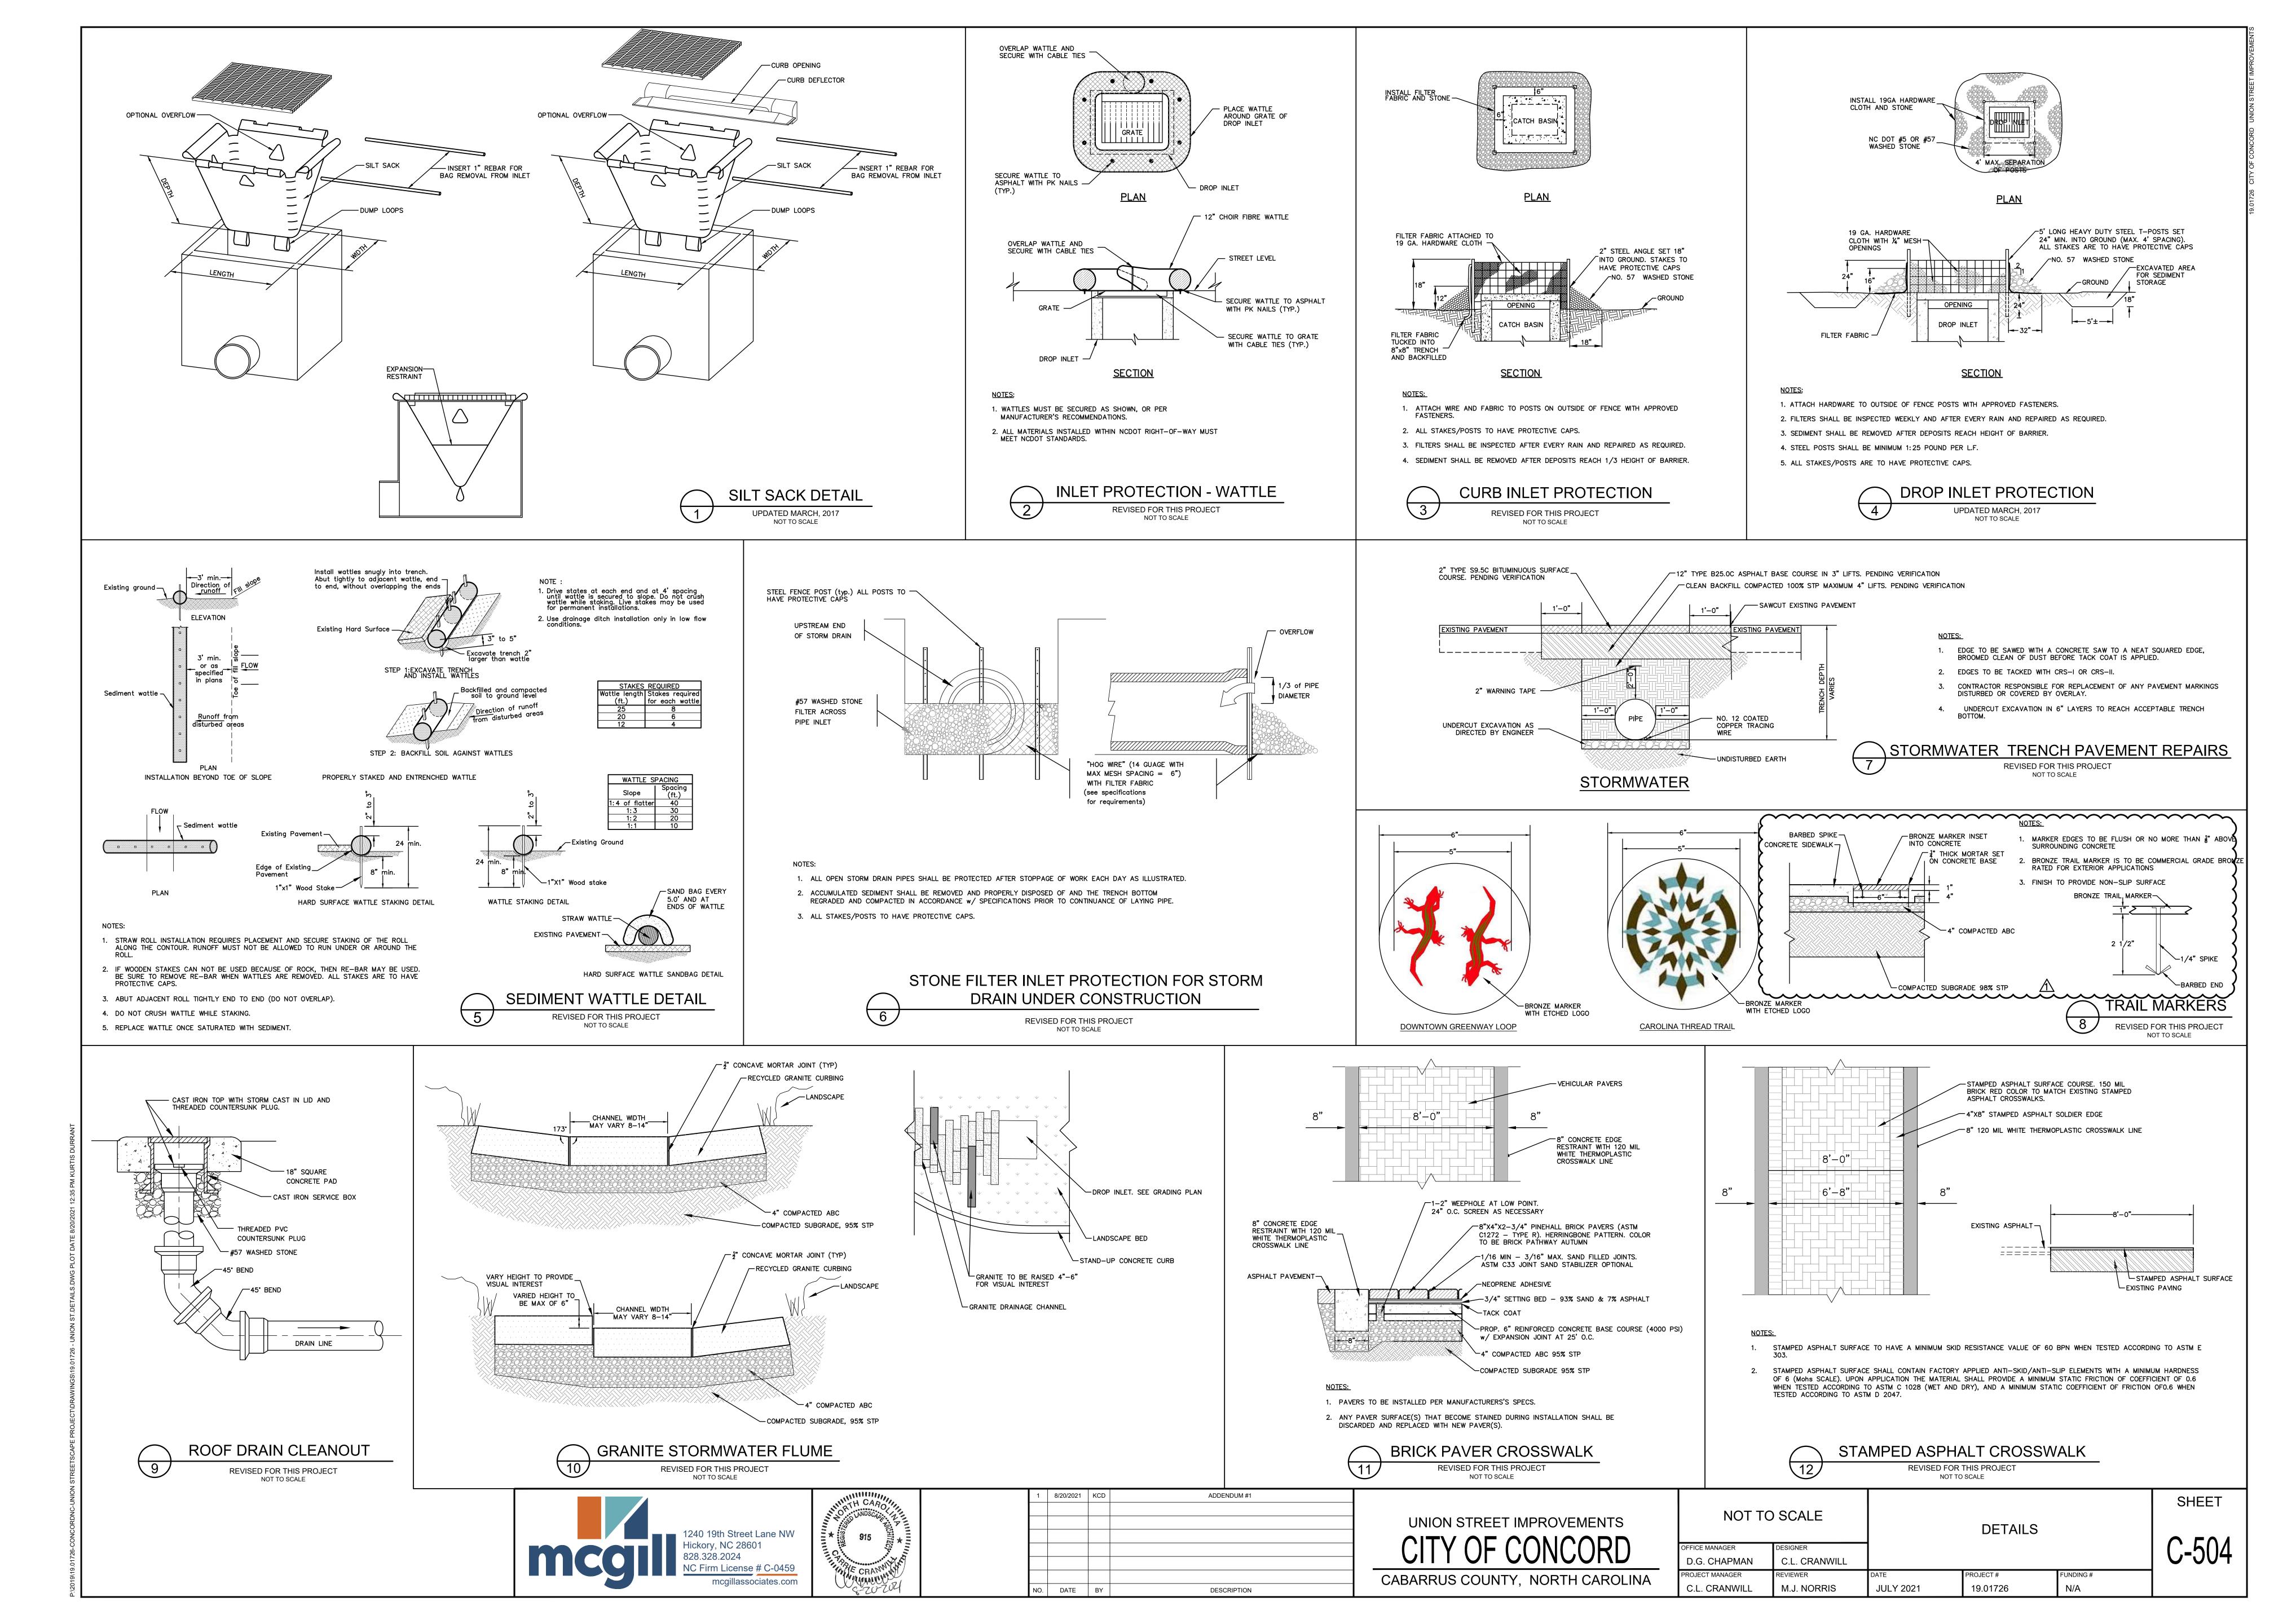


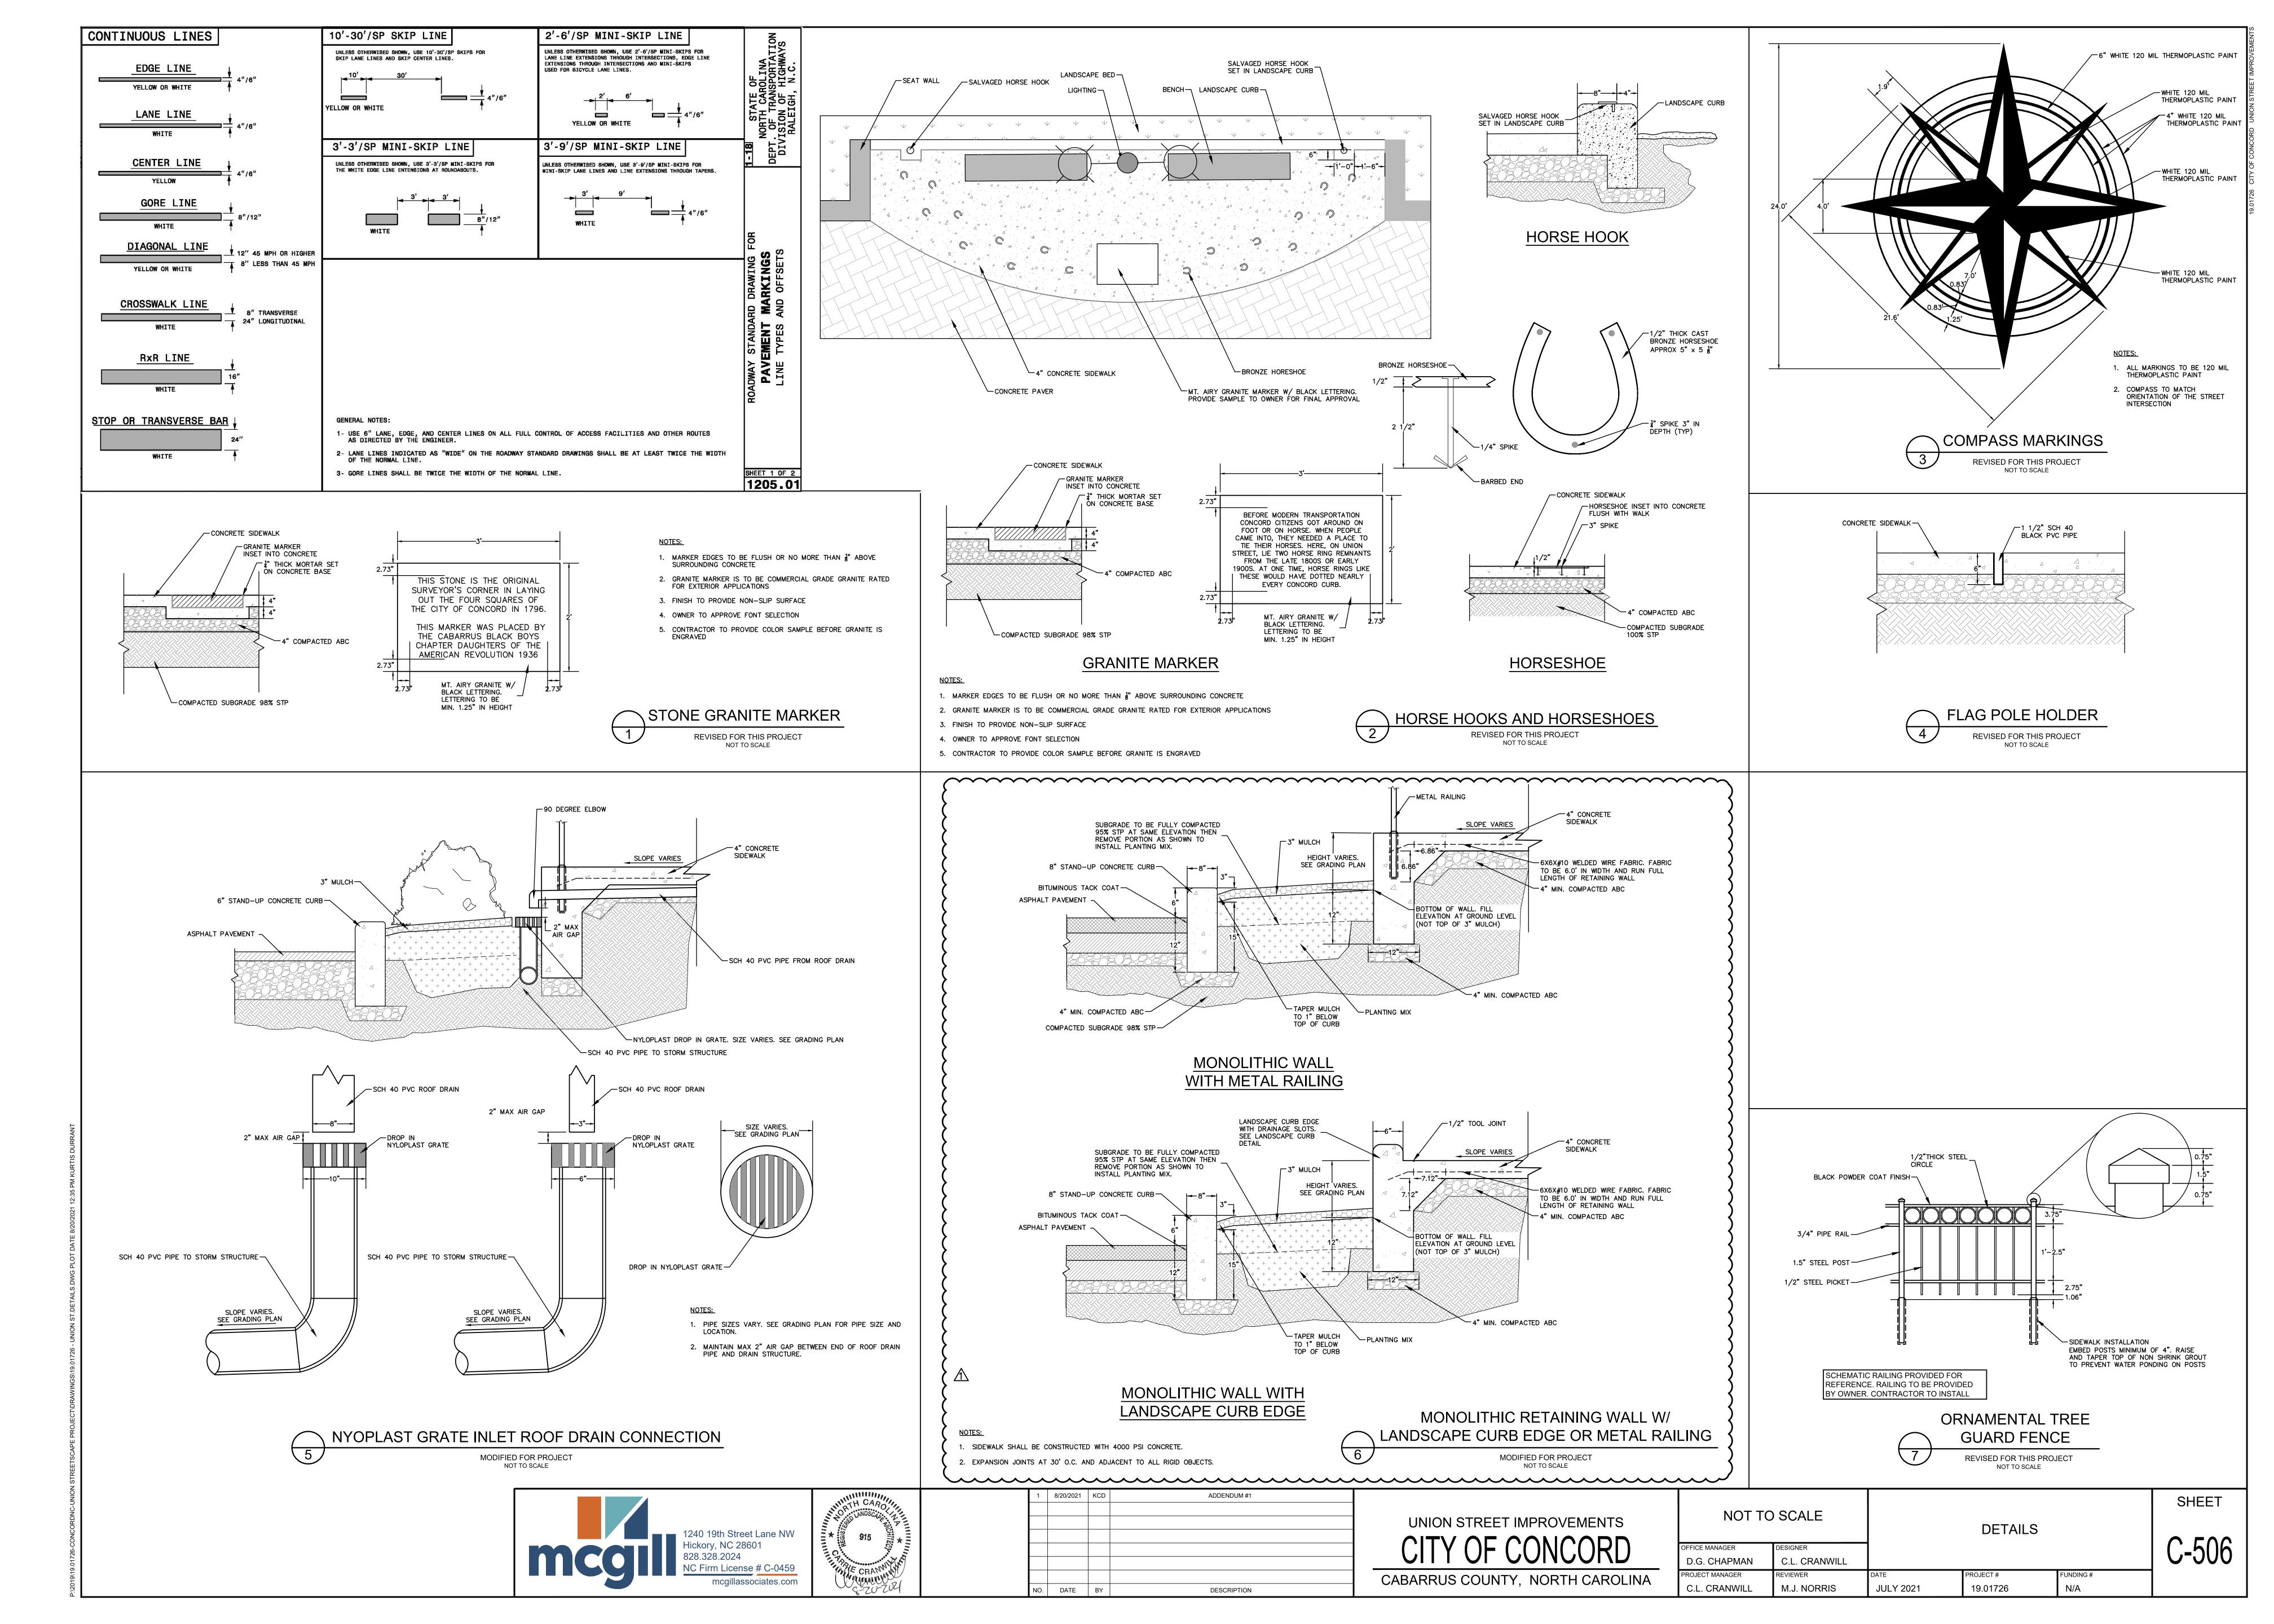

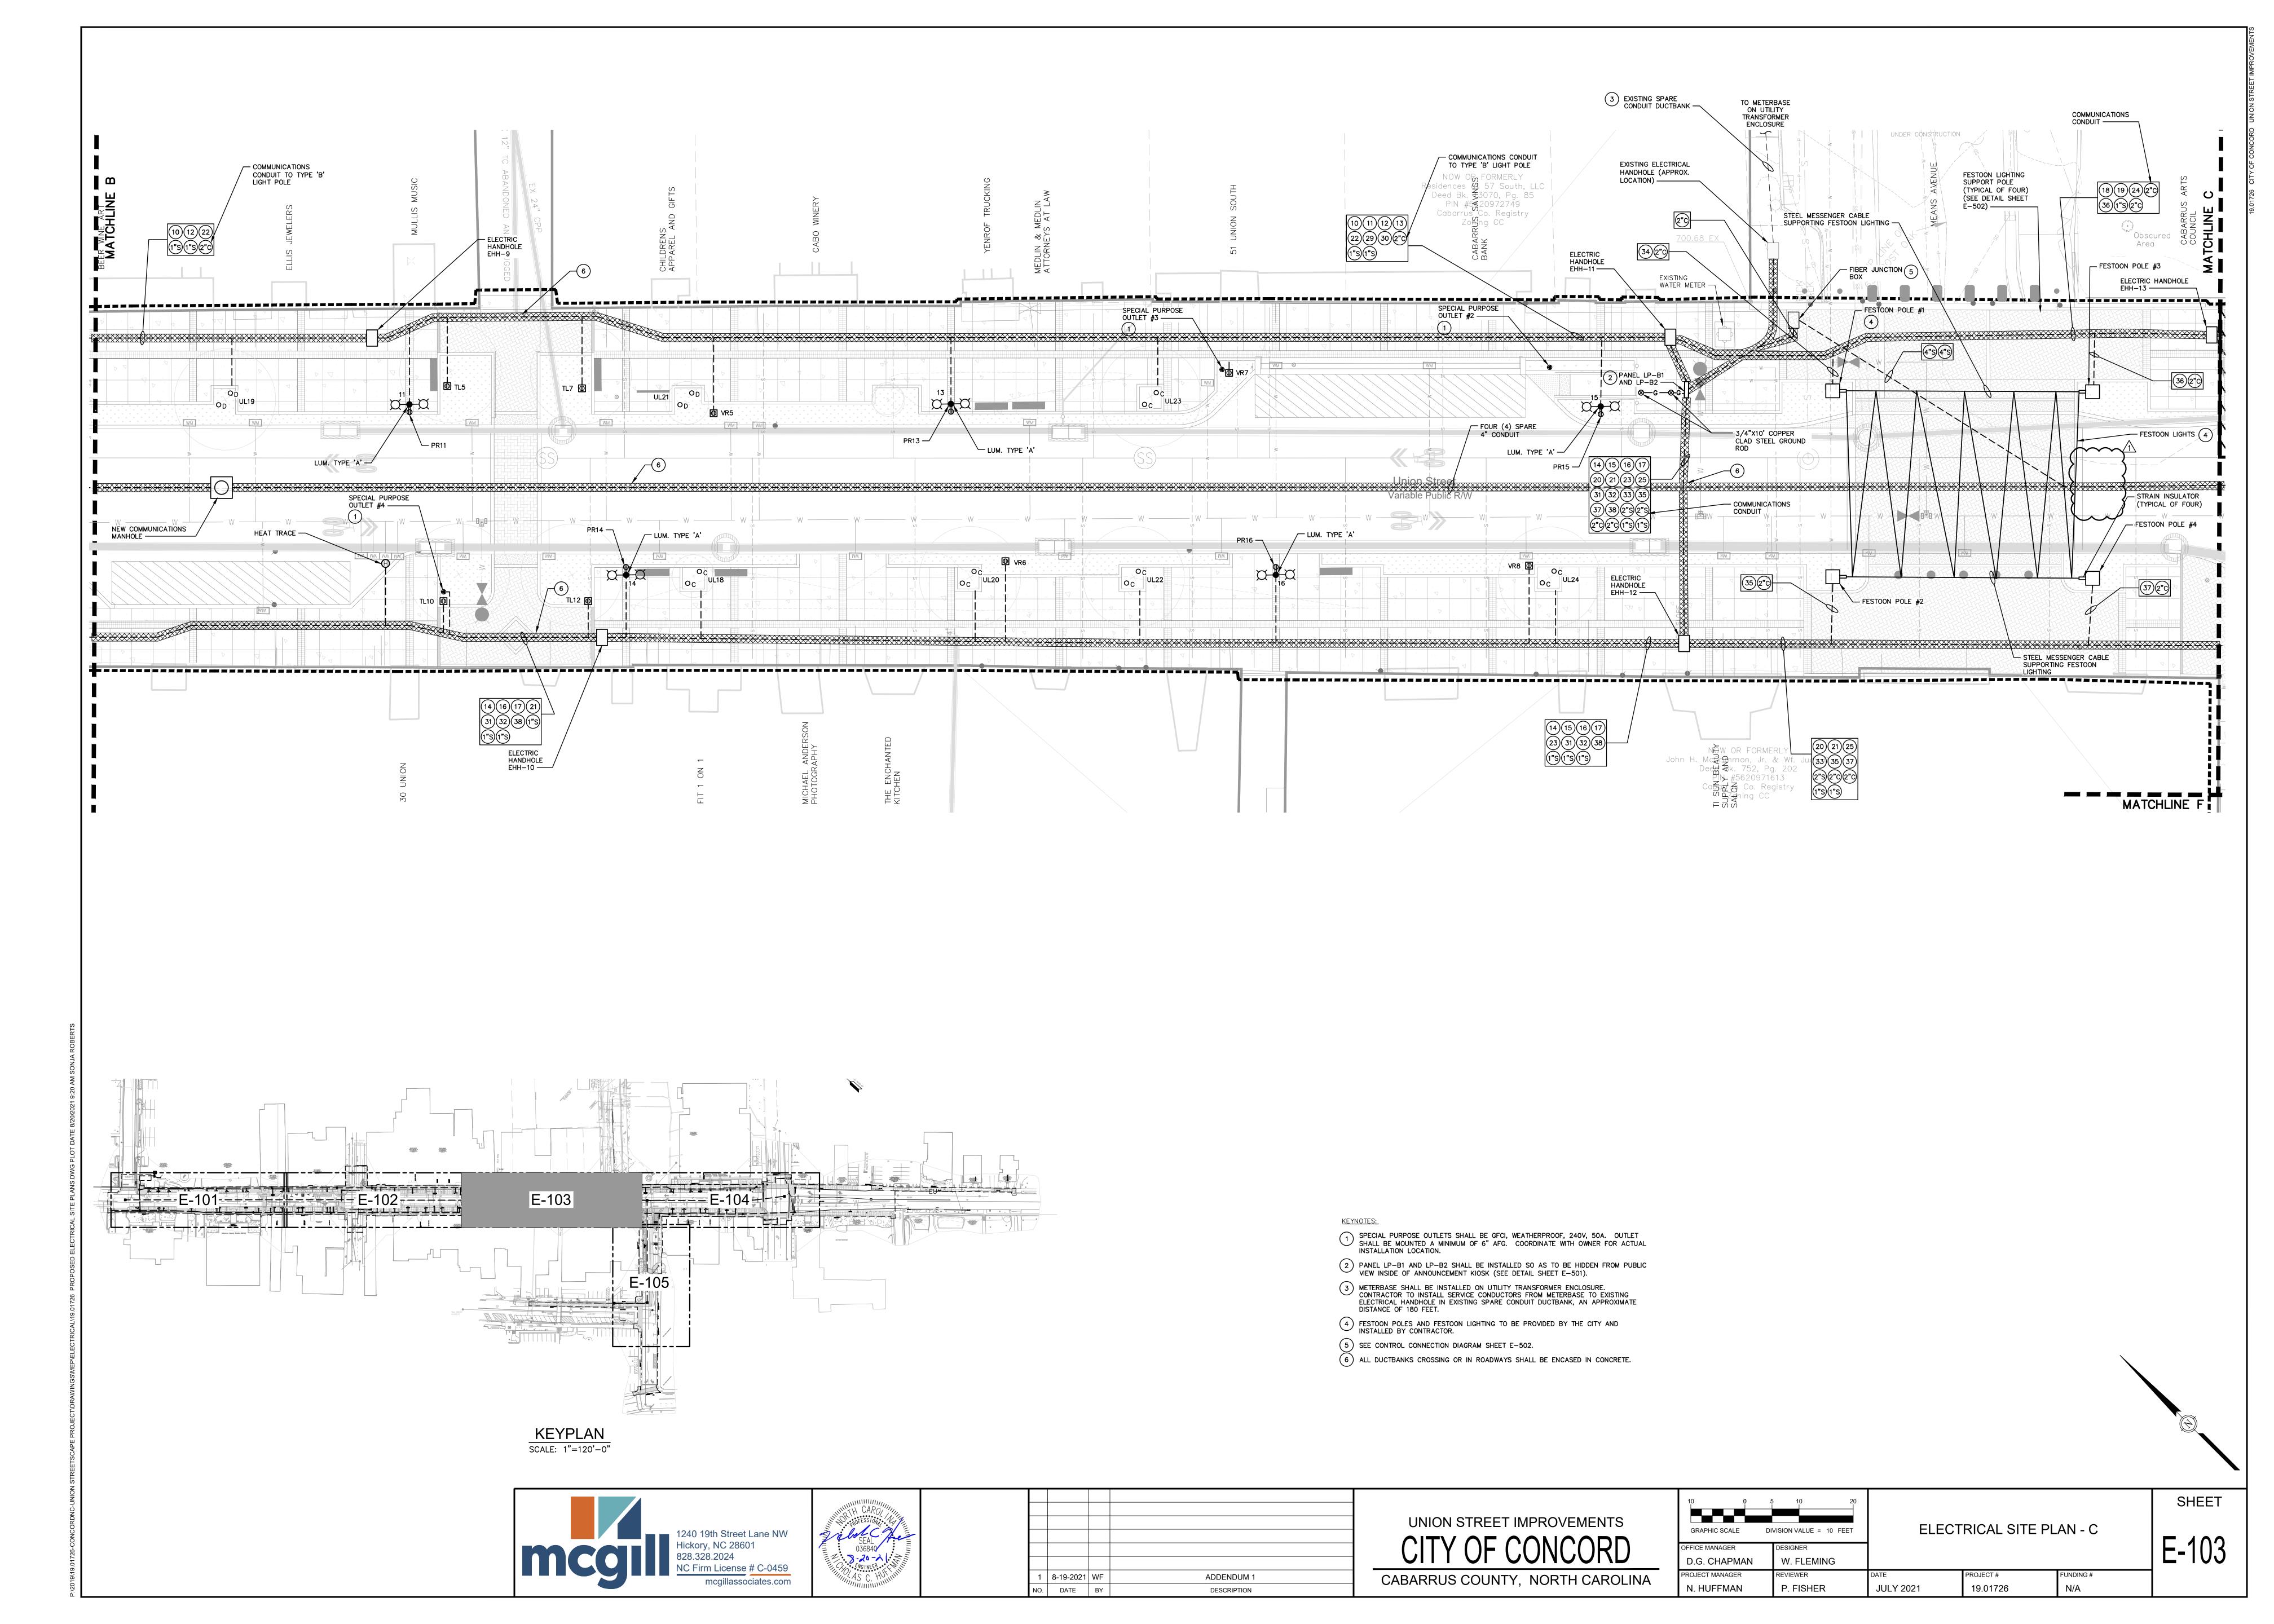

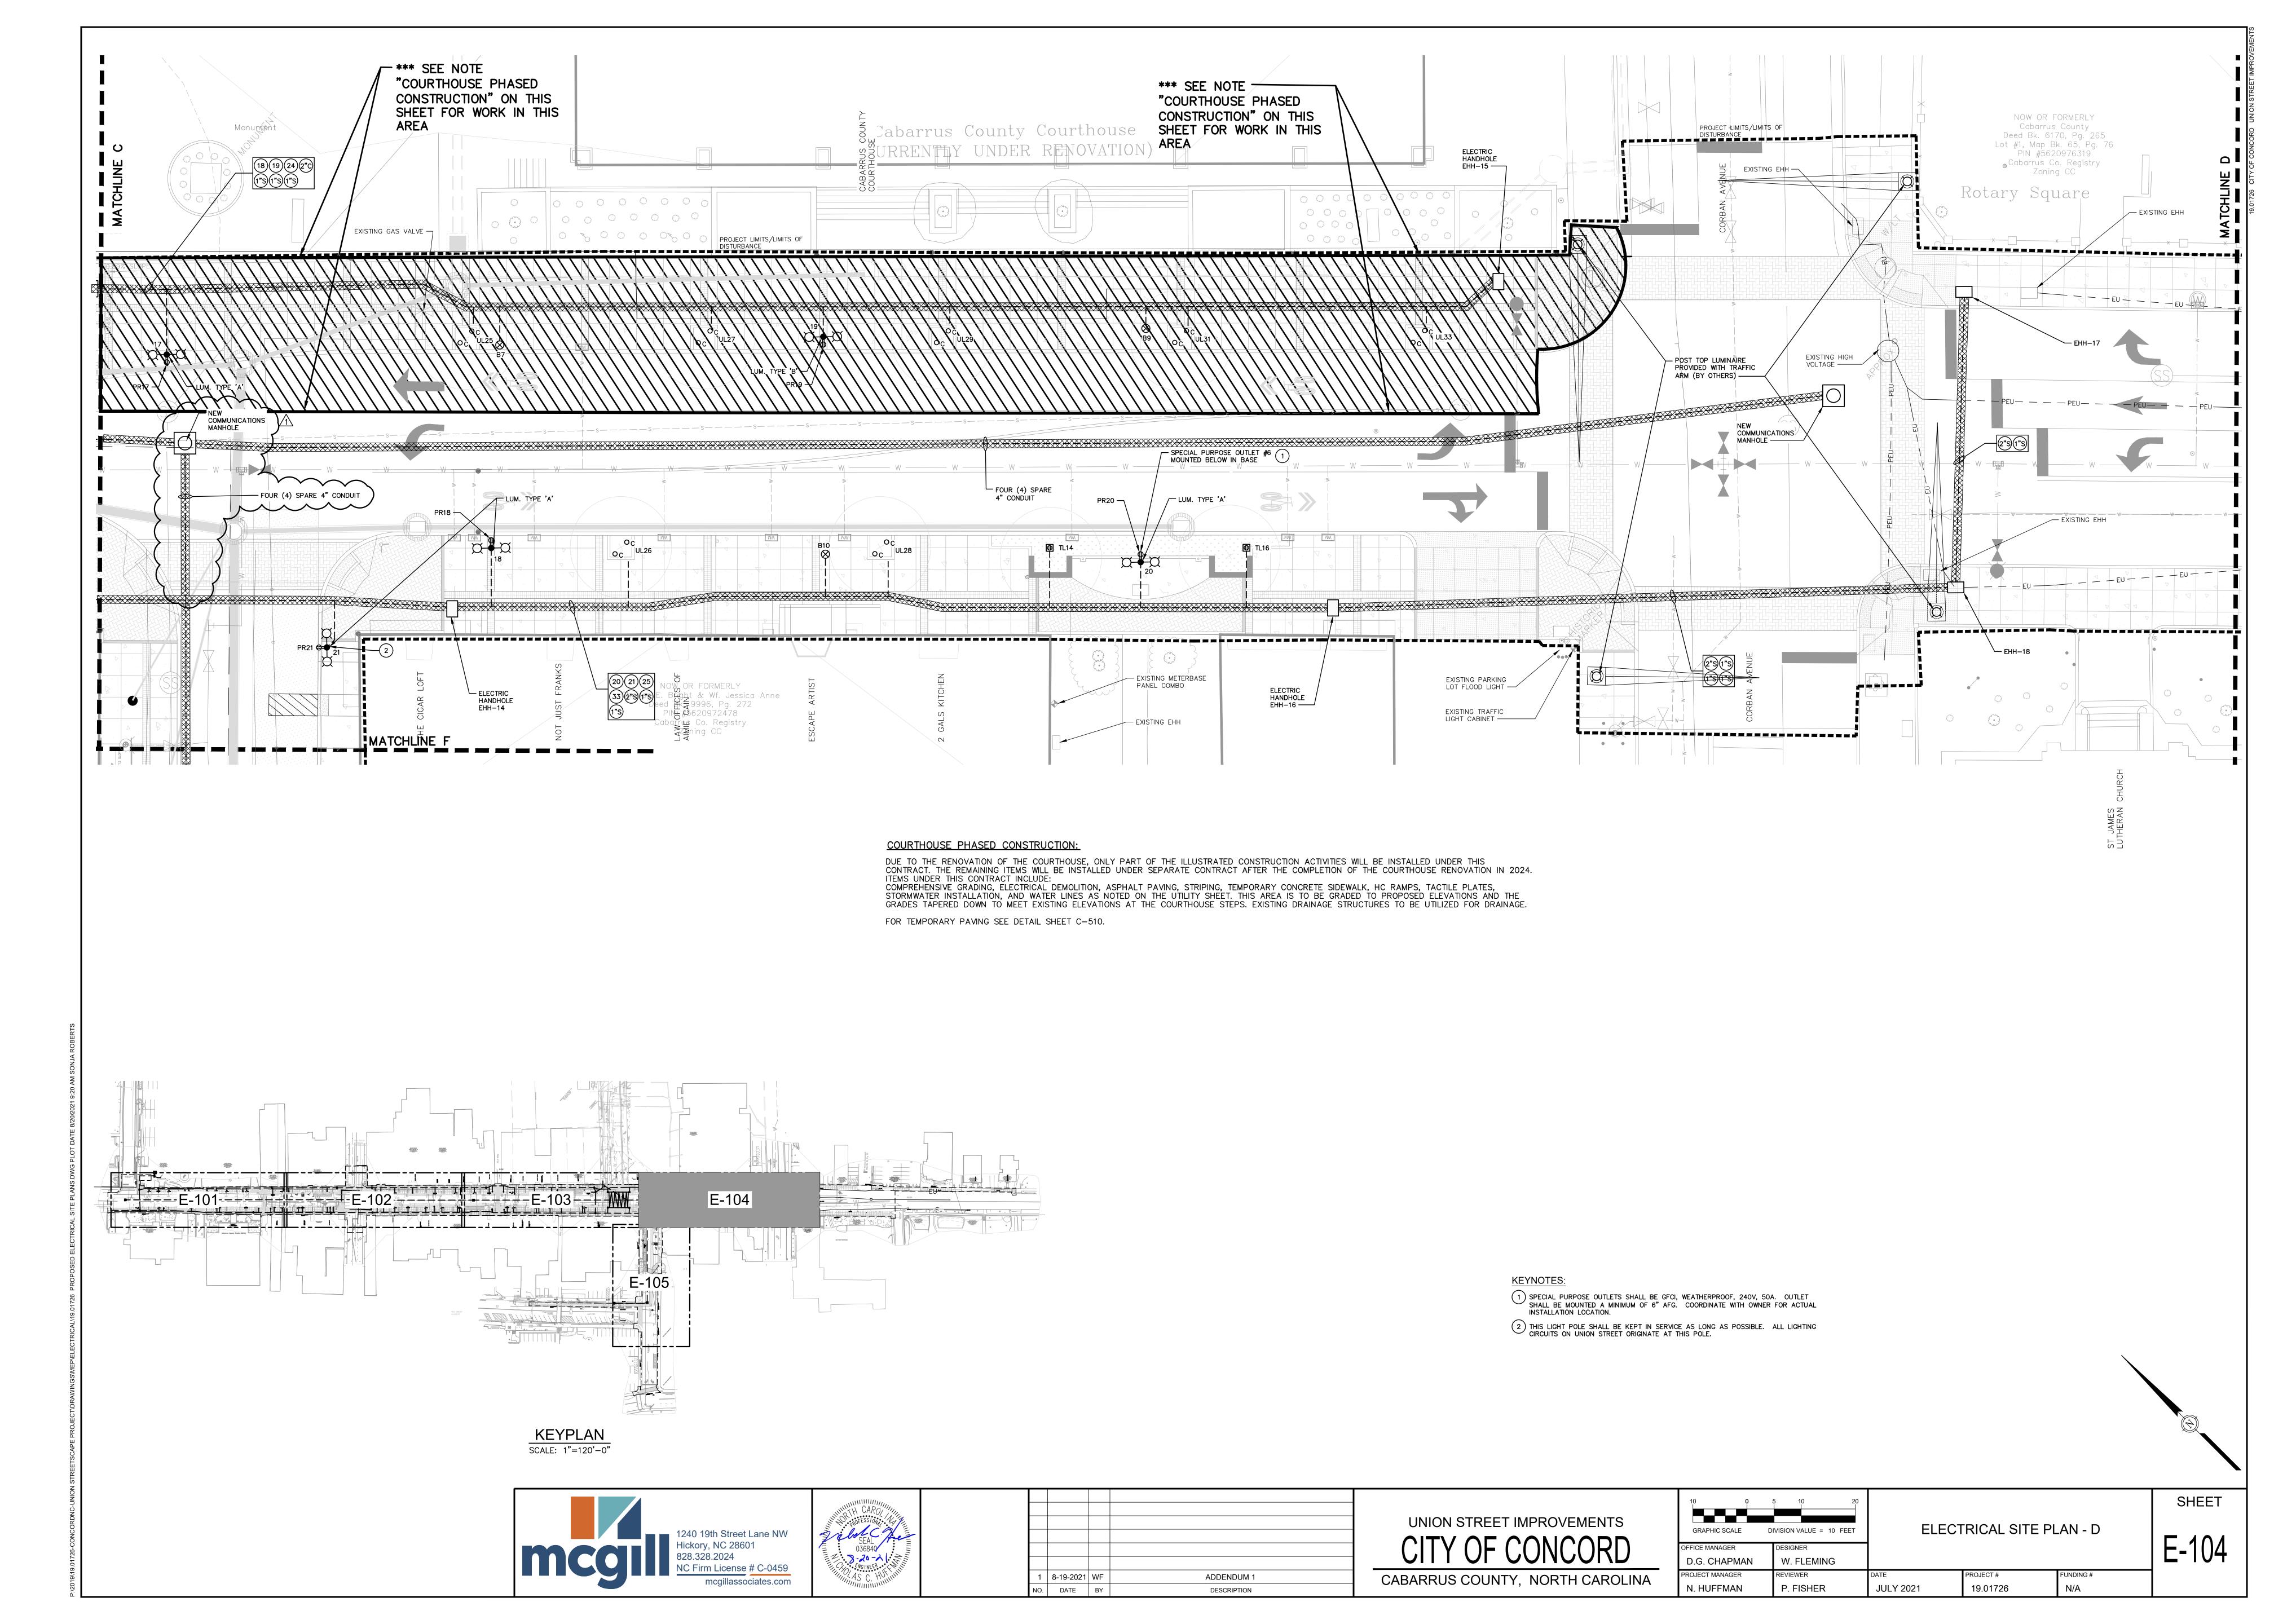


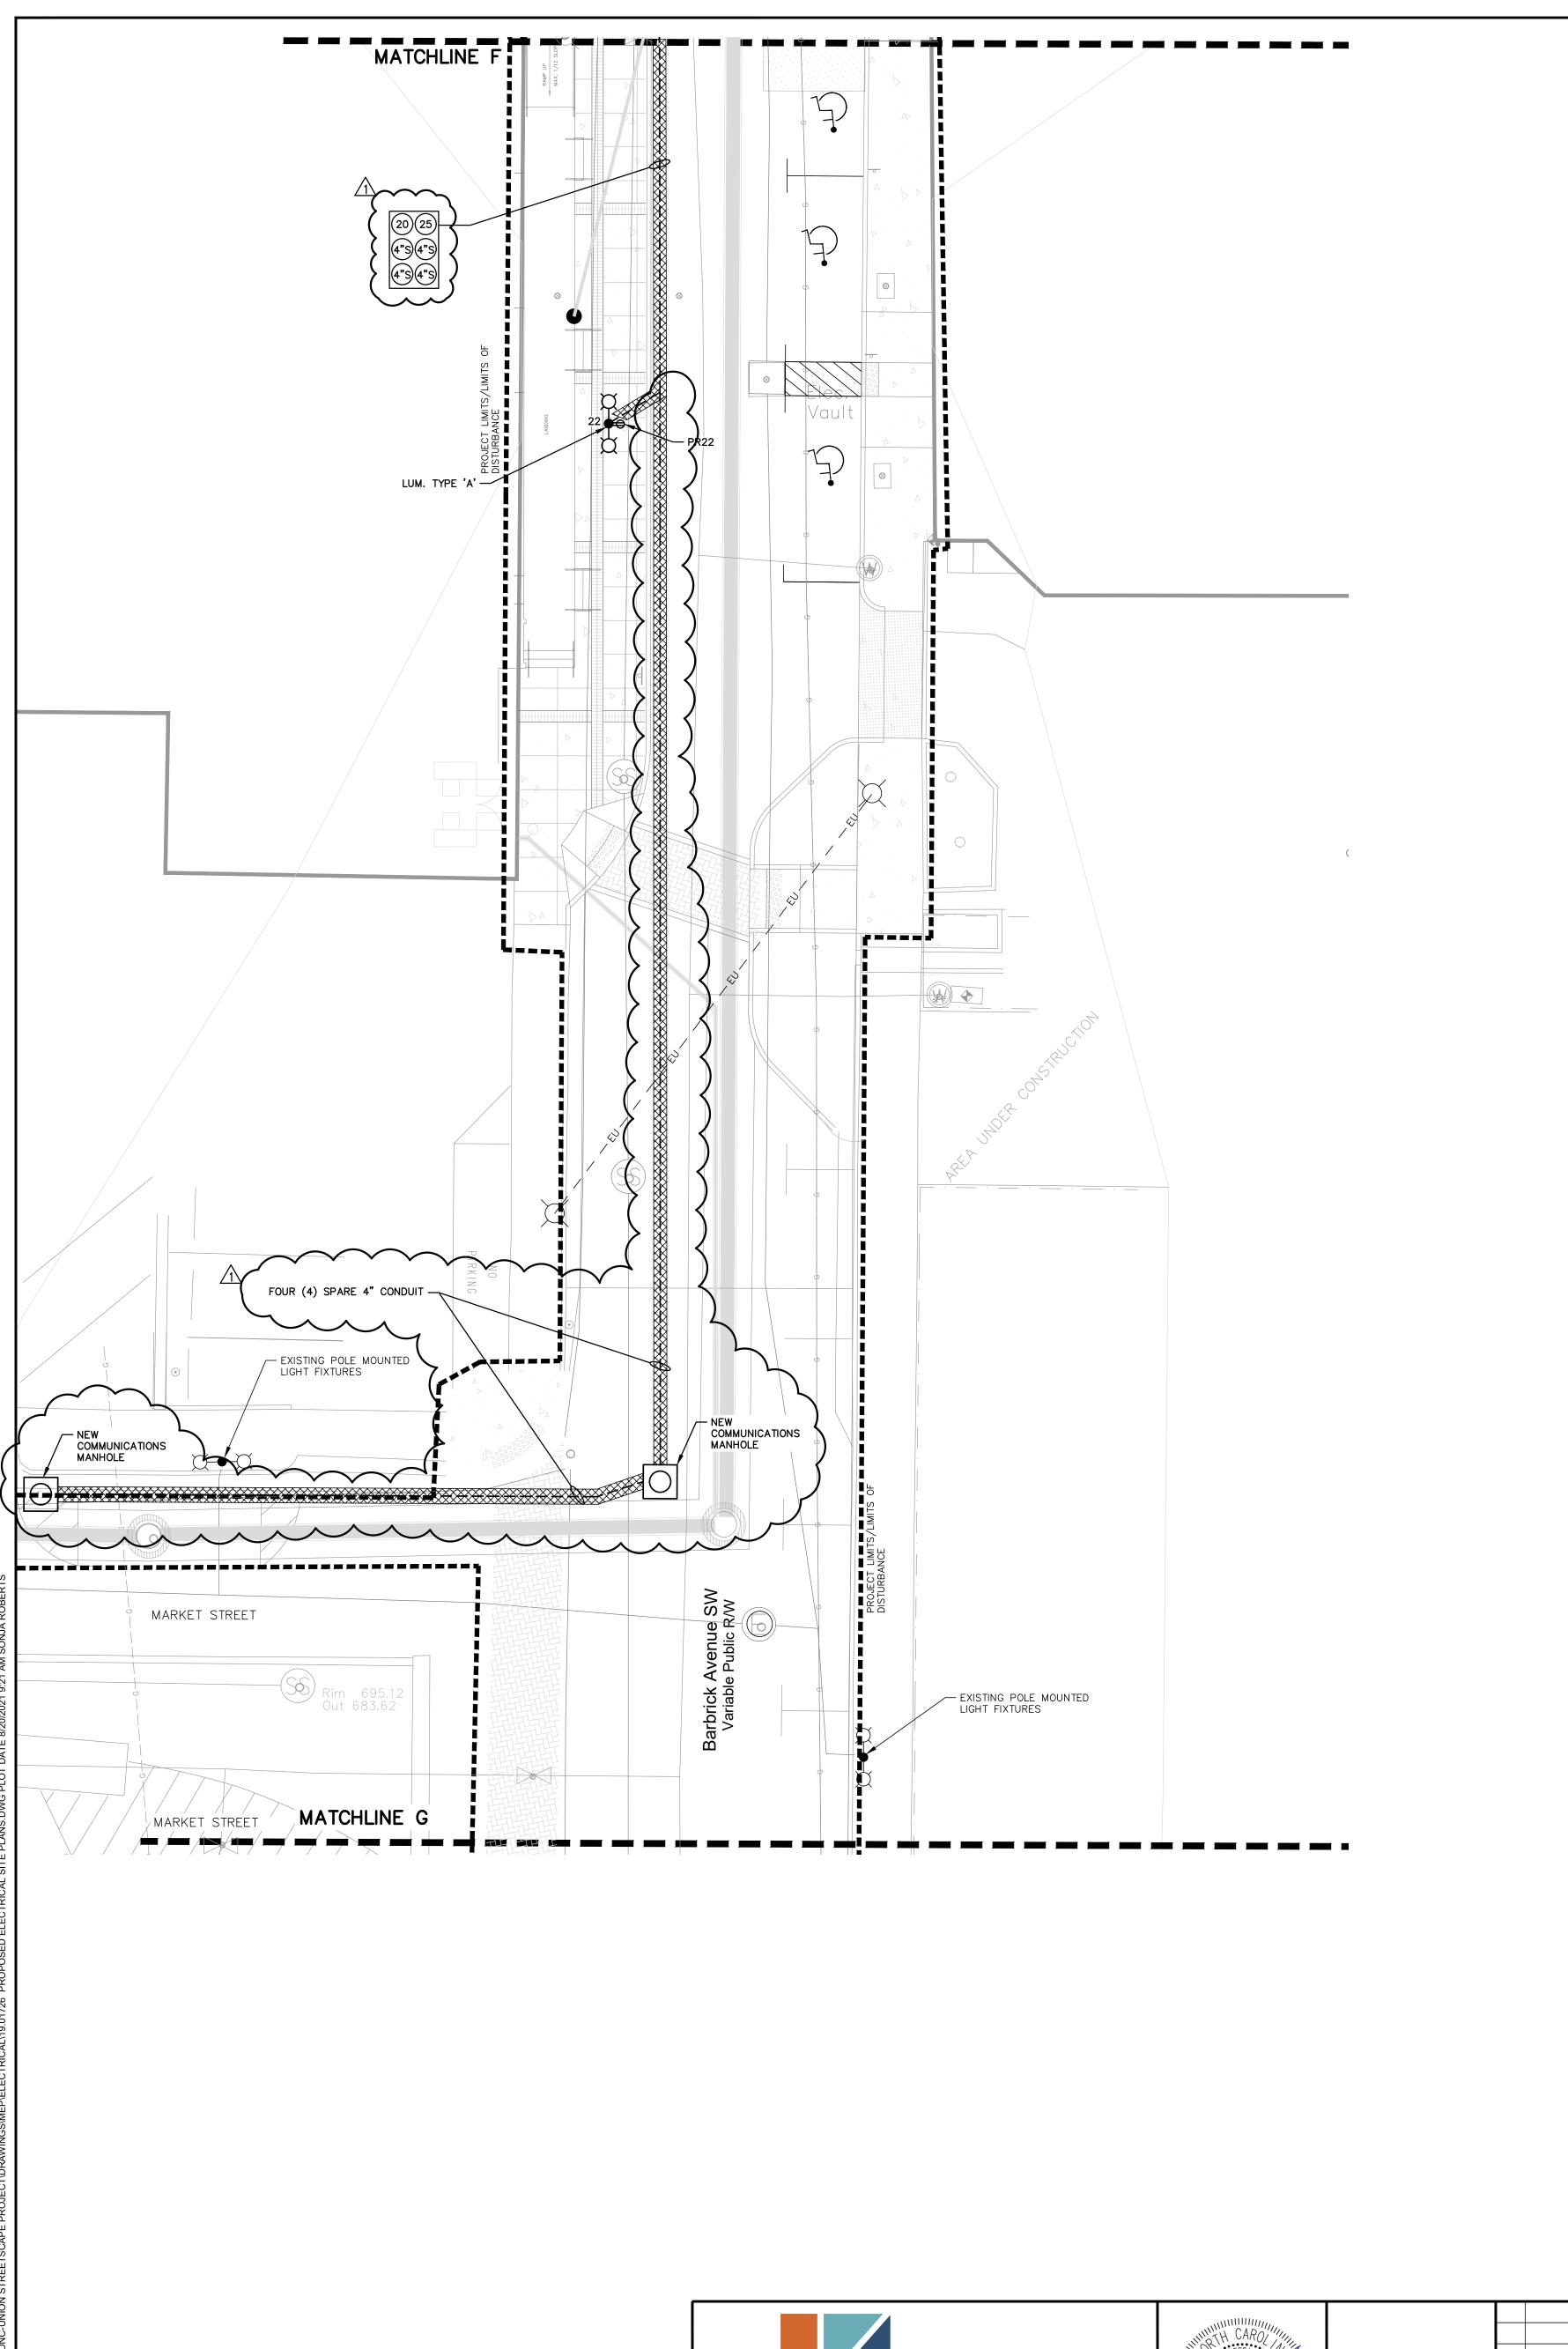

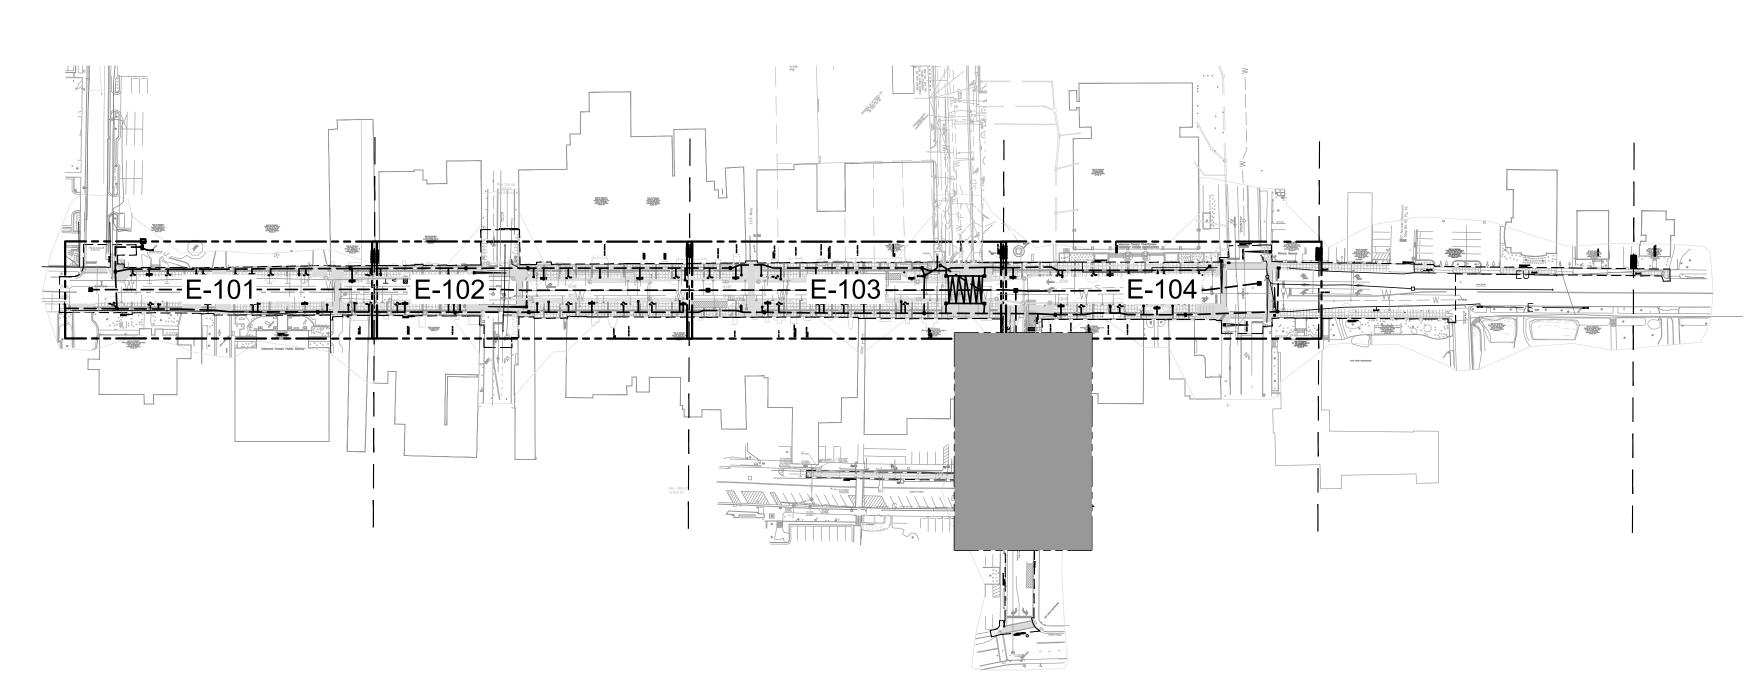

KEYPLAN
SCALE: 1"=120'-0"

1240 19th Street Lane NW
Hickory, NC 28601
828.328.2024
NC Firm License # C-0459
mcgillassociates.com

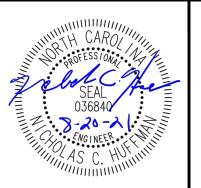

	1	8-19-2021	WF	ADDENDUM 1
	NO.	DATE	BY	DESCRIPTION
·				

UNION STREET IMPROVEMENTS
CITY OF CONCORD

CABARRUS COUNTY, NORTH CAROLINA

10 0	5 10 20	
GRAPHIC SCALE	DIVISION VALUE = 10 FEET	E
OFFICE MANAGER	DESIGNER	1
D.G. CHAPMAN	W. FLEMING	
PROJECT MANAGER	REVIEWER	DATE
N. HUFFMAN	P. FISHER	JULY 2021

ELECTRICAL SITE PLAN - F

N/A

E-105

SHEET

GRAPHIC SCA

OFFICE MANAGER

D.G. CHAPI

PROJECT MANAGER

DATE PROJECT #

R JULY 2021 19.01726